
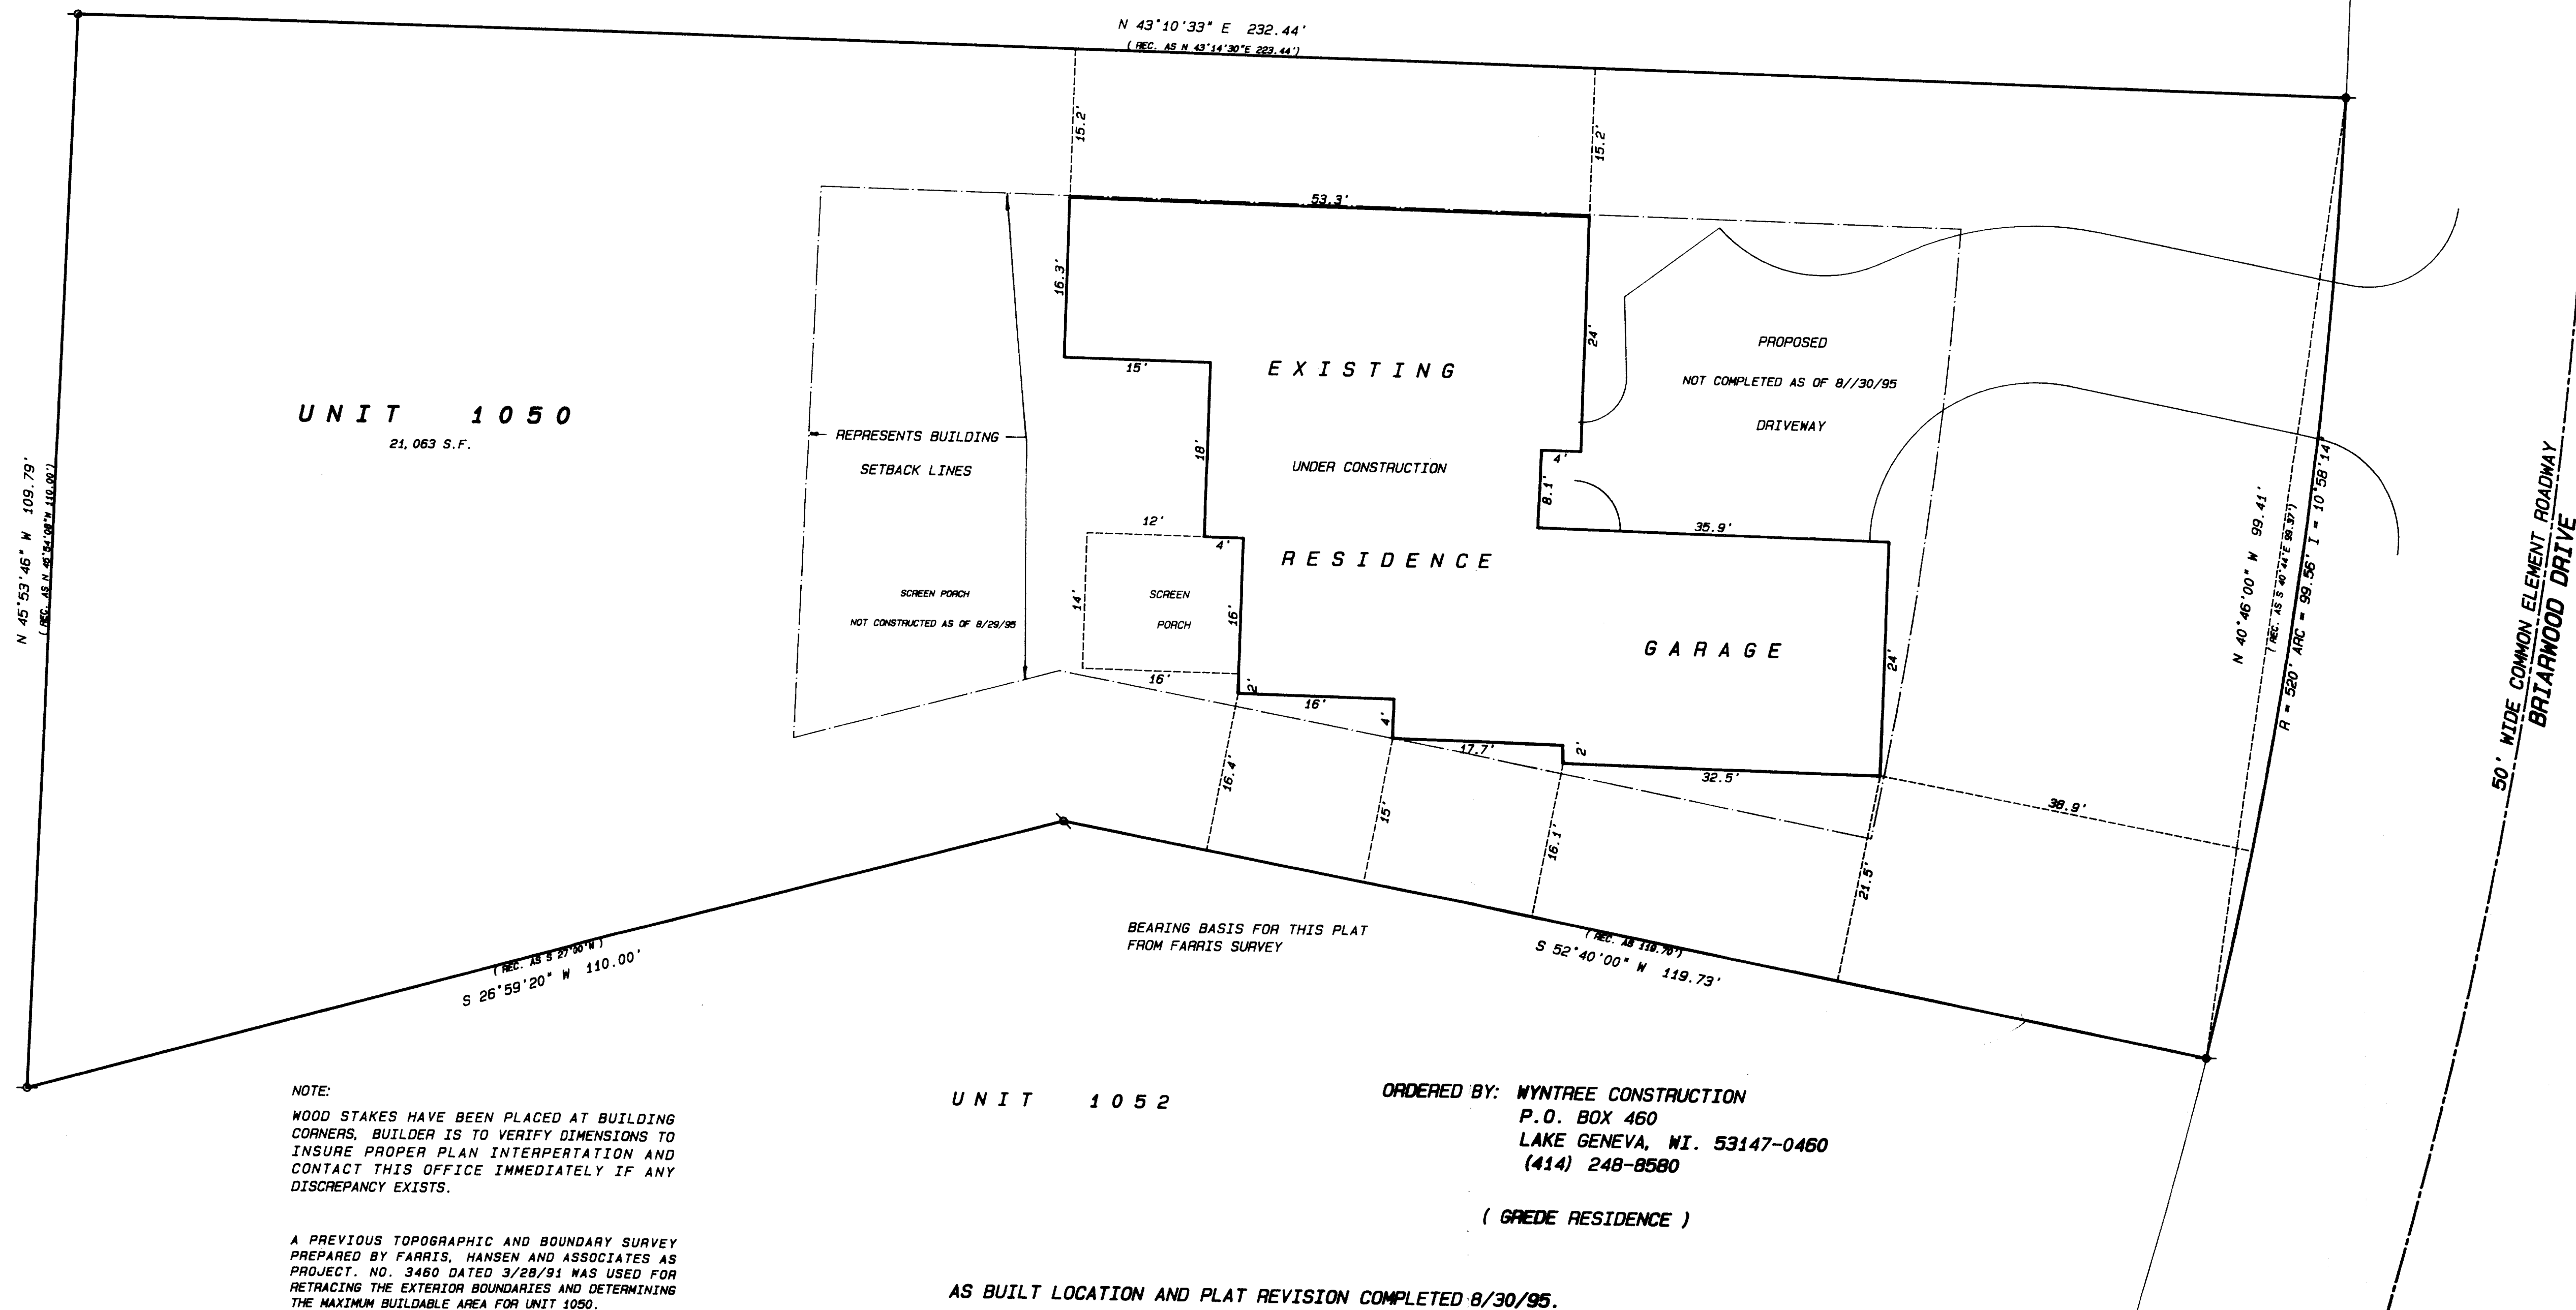


PLAT OF SURVEY

UNIT 1050 OF ABBEY SPRINGS CONDOMINIUM
NO. 8, LOCATED IN THE VILLAGE OF
FONTANA-ON-GENEVA LAKE, WALNORTH COUNTY,
WISCONSIN.


UNIT 1048

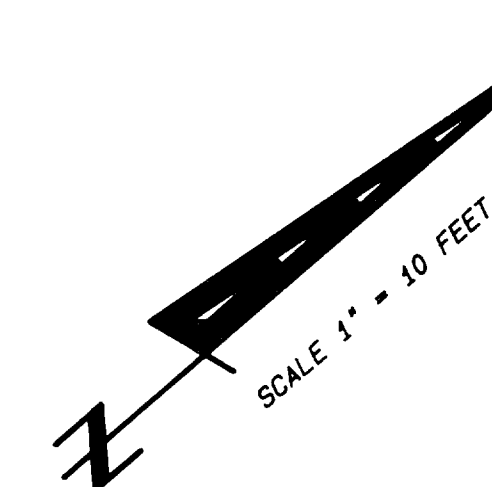

NOTE:

WOOD STAKES HAVE BEEN PLACED AT BUILDING
CORNERS. BUILDER IS TO VERIFY DIMENSIONS TO
INSURE PROPER PLAN INTERPERTATION AND
CONTACT THIS OFFICE IMMEDIATELY IF ANY
DISCREPANCY EXISTS.


A PREVIOUS TOPOGRAPHIC AND BOUNDARY SURVEY
PREPARED BY FARRIS, HANSEN AND ASSOCIATES AS
PROJECT. NO. 3460 DATED 3/28/91 WAS USED FOR
RETRACING THE EXTERIOR BOUNDARIES AND DETERMINING
THE MAXIMUM BUILDABLE AREA FOR UNIT 1050.

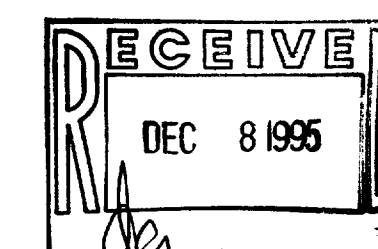

Legend

- FOUND IRON PIPE
- FOUND IRON ROD
- FOUND BRASS CAPPED MONUMENT
- FOUND CONCRETE MONUMENT
- CHISEL CUT IN CONCRETE
- SET IRON ROD, 24" LONG, WEIGHING
1.5 LBS./LINEAL FT., 3/4" DIA.
- SET IRON ROD, 30" LONG, WEIGHING
8.5 LBS./LINEAL FT., 1-11/16" DIA.
- RECORDED AS DIMENSION
- EXISTING FENCE

SCALE: 1" = 10 FEET

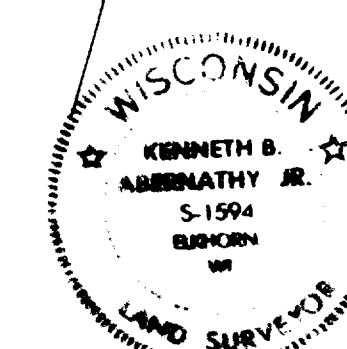

I hereby certify that the above described property has been surveyed
by me or under my direction and that the above map is a true
representation thereof and shows the size and location of the property,
its exterior boundaries, the location of all visible structures and
dimensions of all principal buildings thereon, boundary fences, apparent
easements, roadways and visible encroachments, if any.
This survey is made for the use of the present owners of the property,
and also those who purchase, mortgage, or guarantee the title thereto
within one year from date hereof.

Kenneth B. Abernathy Jr.
WISCONSIN REGISTERED LAND SURVEYOR,
S-1594

AS BUILT REVISION 8/30/95 Date: MAY 5, 1995 Job No. 75,425

SCDB8-1050

005-1495