

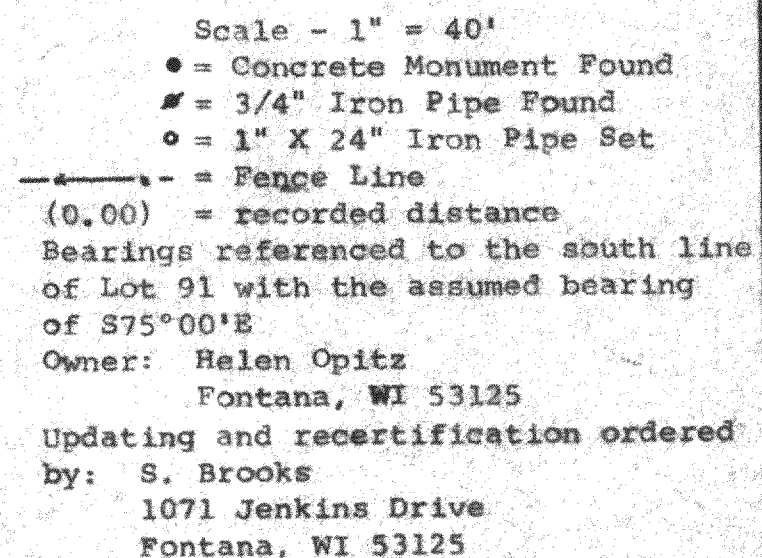


**SURVEYING & SUBDIVIDING
DEHAVAN, WISCONSIN 53115**

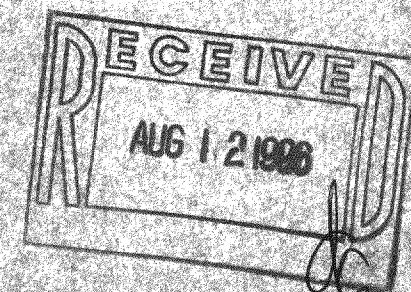

George T. Dunham
George T. Dunham, Surveyor

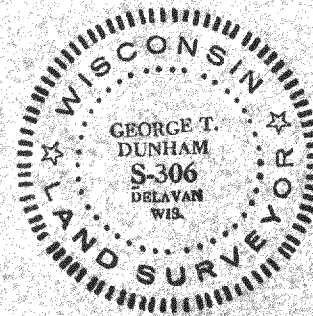

SL02-78
DPS-1500