
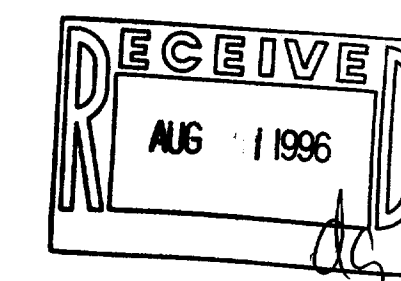


PLAT OF SURVEY

LOT 21 OF BLOCK 6 OF INDIAN HILLS
SUBDIVISION AND LOT 1 OF BLOCK 7 OF INDIAN
HILLS 1ST ADDITION TO THE VILLAGE OF FONTANA
- ON - GENEVA LAKE, WALWORTH COUNTY,
WISCONSIN.

OWNER: ROBERT BOUDART
3605 KILLARNEY CT.
ROLLING MEADOWS, IL. 60008

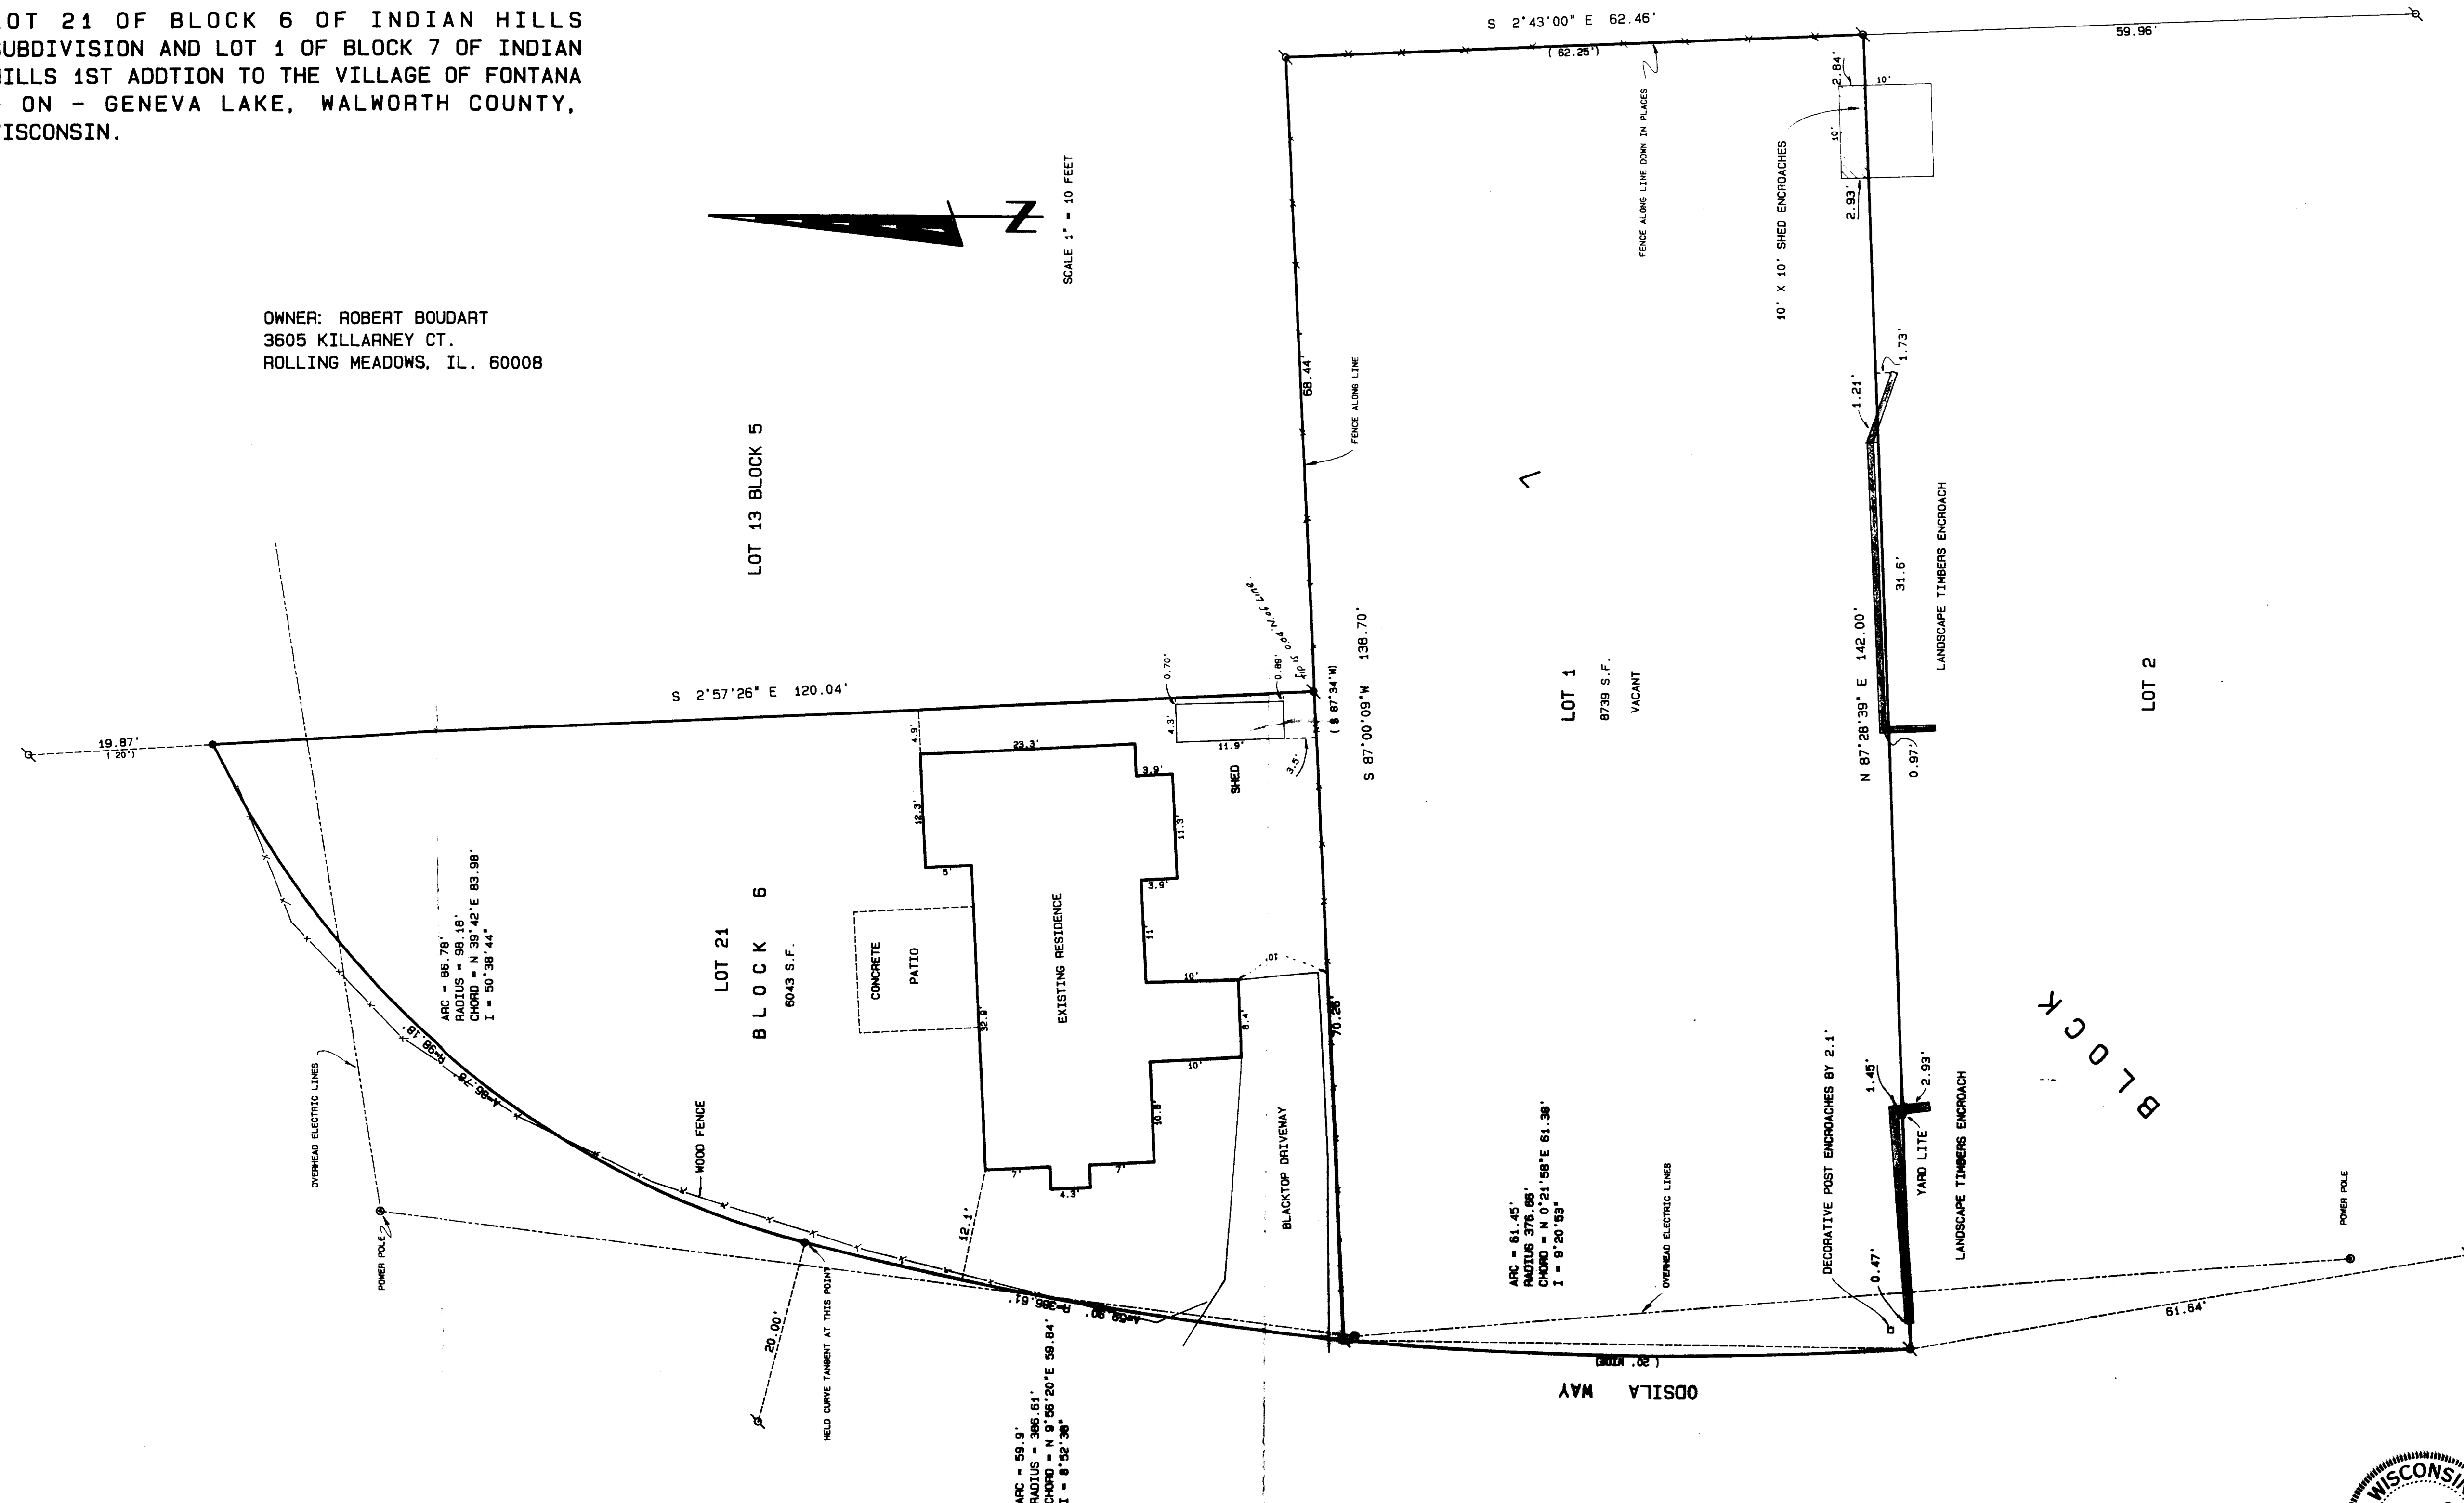

- Legend
- FOUND IRON PIPE
 - FOUND IRON ROD
 - FOUND BRASS CAPPED MONUMENT
 - FOUND CONCRETE MONUMENT
 - CHISEL CUT IN CONCRETE
 - SET IRON ROD, 24\"/>



SCALE: 1\"/>

"I hereby certify that the above described property has been surveyed
by me or under my direction and that the above map is a true
representation thereof and shows the size and location of the property,
its exterior boundaries, the location of all visible structures and
dimensions of all principal buildings thereon, boundary lines, apparent
easements, roadways and visible encroachments, if any."
"This survey is made for the use of the present owners of the property,
and also those who purchase, mortgage, or guarantee the title thereto
within one year from date hereof."

Kenneth B. Abernathy, Jr.
WISCONSIN REGISTERED LAND SURVEYOR,
S-1594

Date: July 15, 1996 Job No. 93-716