



PLAT OF SURVEY
UNIT 2
CLEAR SKY LODGE
A CONDOMINIUM LOCATED IN
GOVERNMENT LOT 4, SECTION 18
TOWN 1 NORTH, RANGE 17 EAST
VILLAGE OF FONTANA-ON-GENEVA LAKE
WALWORTH COUNTY, WISCONSIN

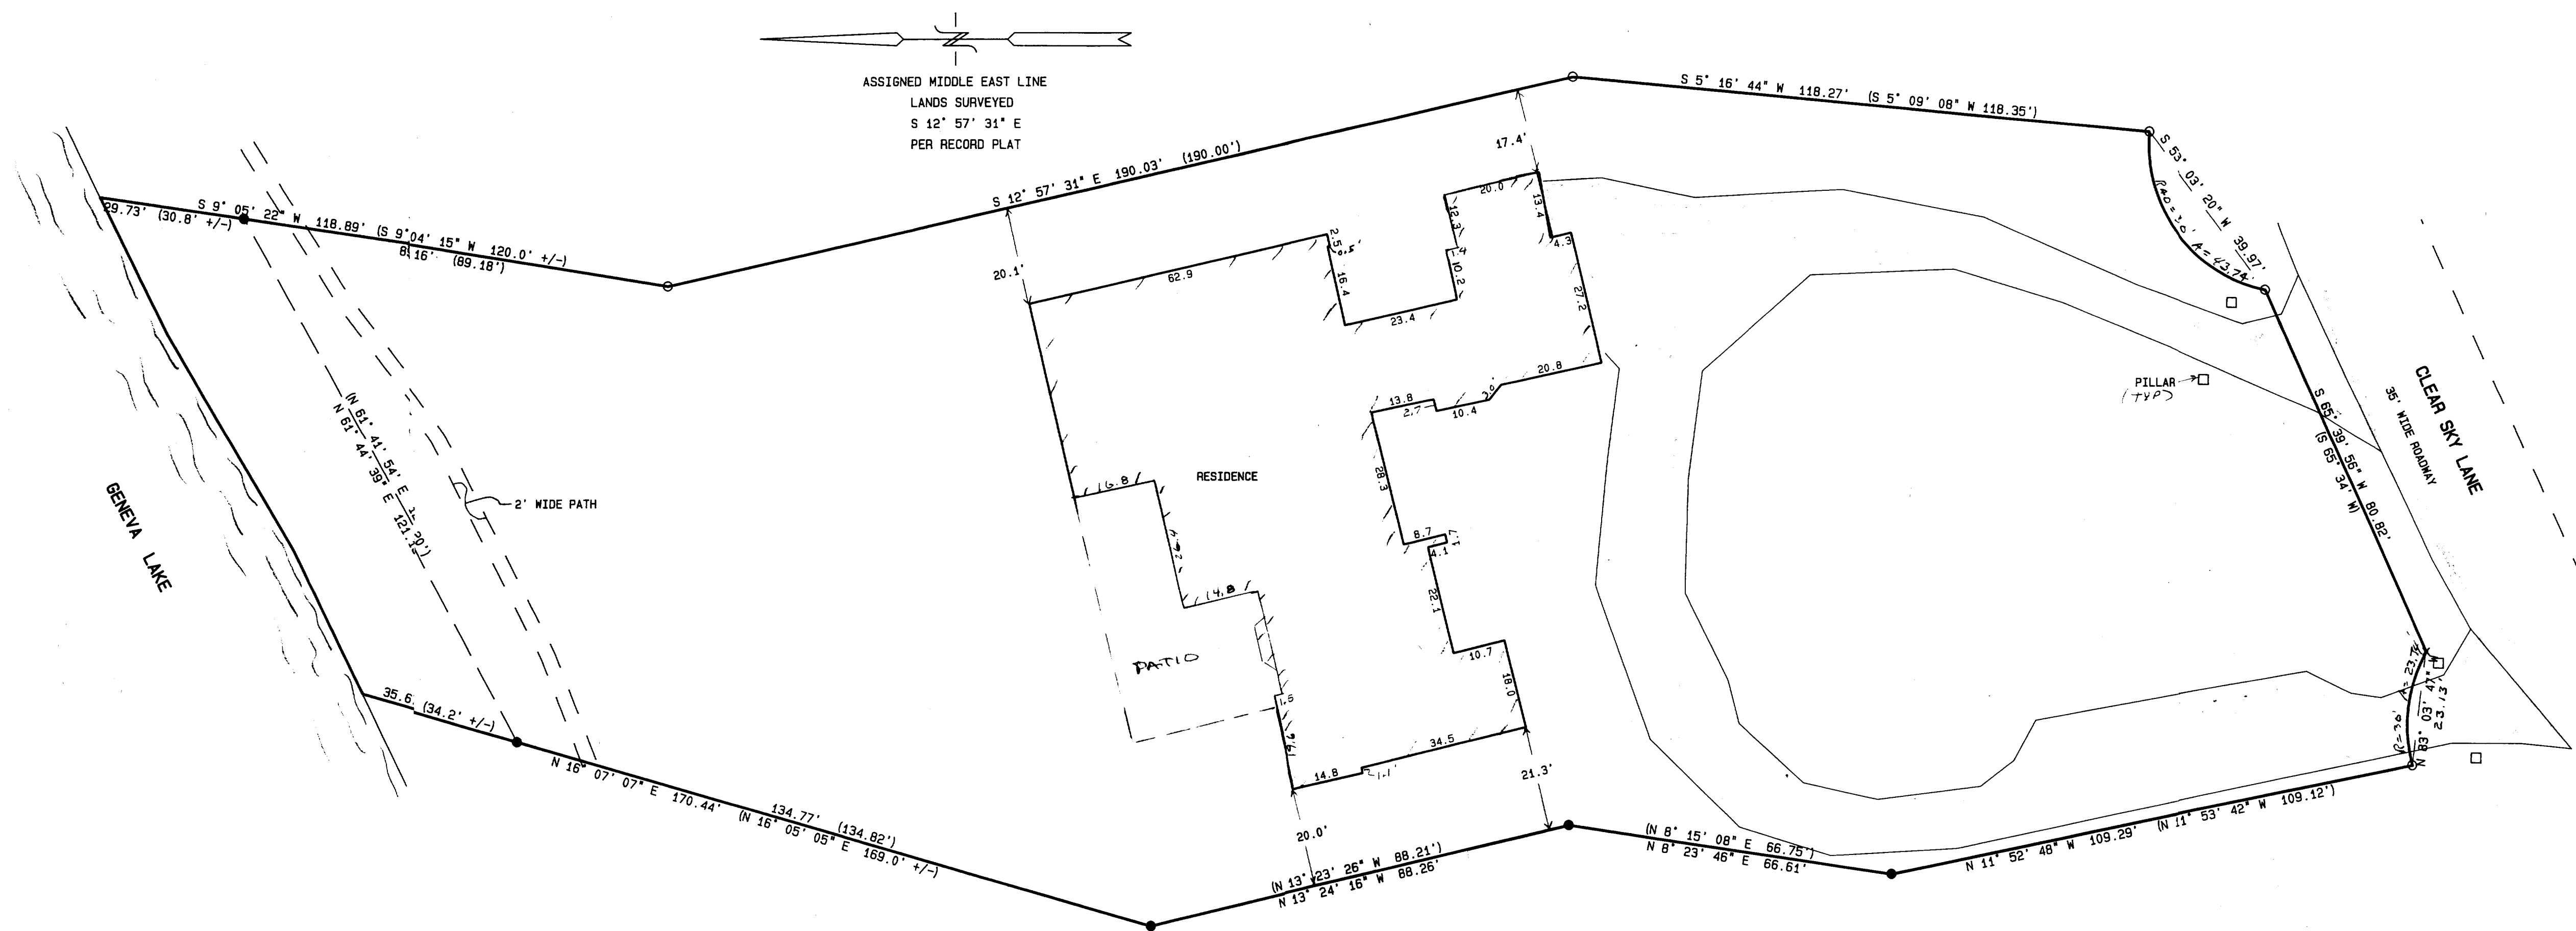

○ = FOUNDIRON PIPE STAKE
● = FOUNDIRON REBAR STAKE
x = SET ISELED X
(xxx) = RECID AS


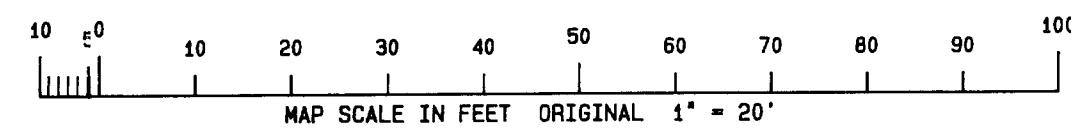


NOTE: COPIES OF THIS MAP TO WICH THE FOLLOWING CERTIFICATE WILL APPLY ARE BLUE LINE PRINTS SHOWING SURVEYOR'S ORIGINAL SEAL AND SIGNATURE IN BLACK INK. COPIES BY ANY OTHER MEANS MAY HAVE ALTERATIONS WHICH DO NOT REPRESENT THE SURVYOR'S WORK PRODUCT.

I HEREBY CERTIFY THAT THE ABOVE DESCRIBED PROPERTY HAS BEEN SURVEYED UNDER MY DIRECTION AND THAT THE ABOVE MAP IS A TRUE REPRESENTATION THEREOF AND SHOWS THE SIZE AND LOCATION OF THE PROPERTY AND ITS EXTERIOR BOUNDARIES. THIS SURVEY IS MADE FOR THE USE OF THE PRESENT OWNERS OF THE PROPERTY, AND ALSO THOSE WHO PURCHASE, MORTGAGE, OR GUARANTEE THE TITLE THERETO WITHIN ONE YEAR FROM THE DATE HEREOF.

DATED: 3-20-1996

Peter S. Gordon
PETER S. GORDON R.L.S. 2101

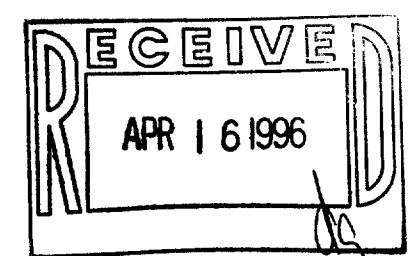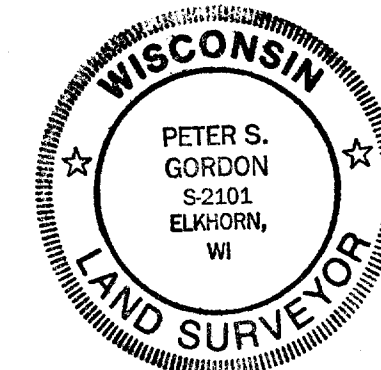

WORK ORDERED BY: SHELDON LANDSCAPING
P.O. BOX 169
FONTANA, WISCONSIN 53125

FARRIS, HANSEN & ASSOCIATES, INC.
Engineering, Architecture, Surveying
7 Ridgway Court P.O. Box 437
ELKHORN, WISCONSIN 53121
Office: (414) 723-2098
Fax: (414) 723-5686

REVISIONS

PROJECT NO.
4483
DATE
03/20/96
SHEET NO.
1 OF 1

SCL-2
005-1518