

ROBERS & FISCHER INC.

HOGANSON & ROBERS, INC.


CONSULTING ENGINEERS & LAND SURVEYORS

PHONE (414) 763-2652

116 E. CHESTNUT ST.

BURLINGTON, WIS. 53105

LOT 18, BLOCK "E", COUNTRY CLUB ESTATES
SUB. UNIT 3, VILLAGE OF FONTANA,
WALWORTH COUNTY, WISCONSIN.

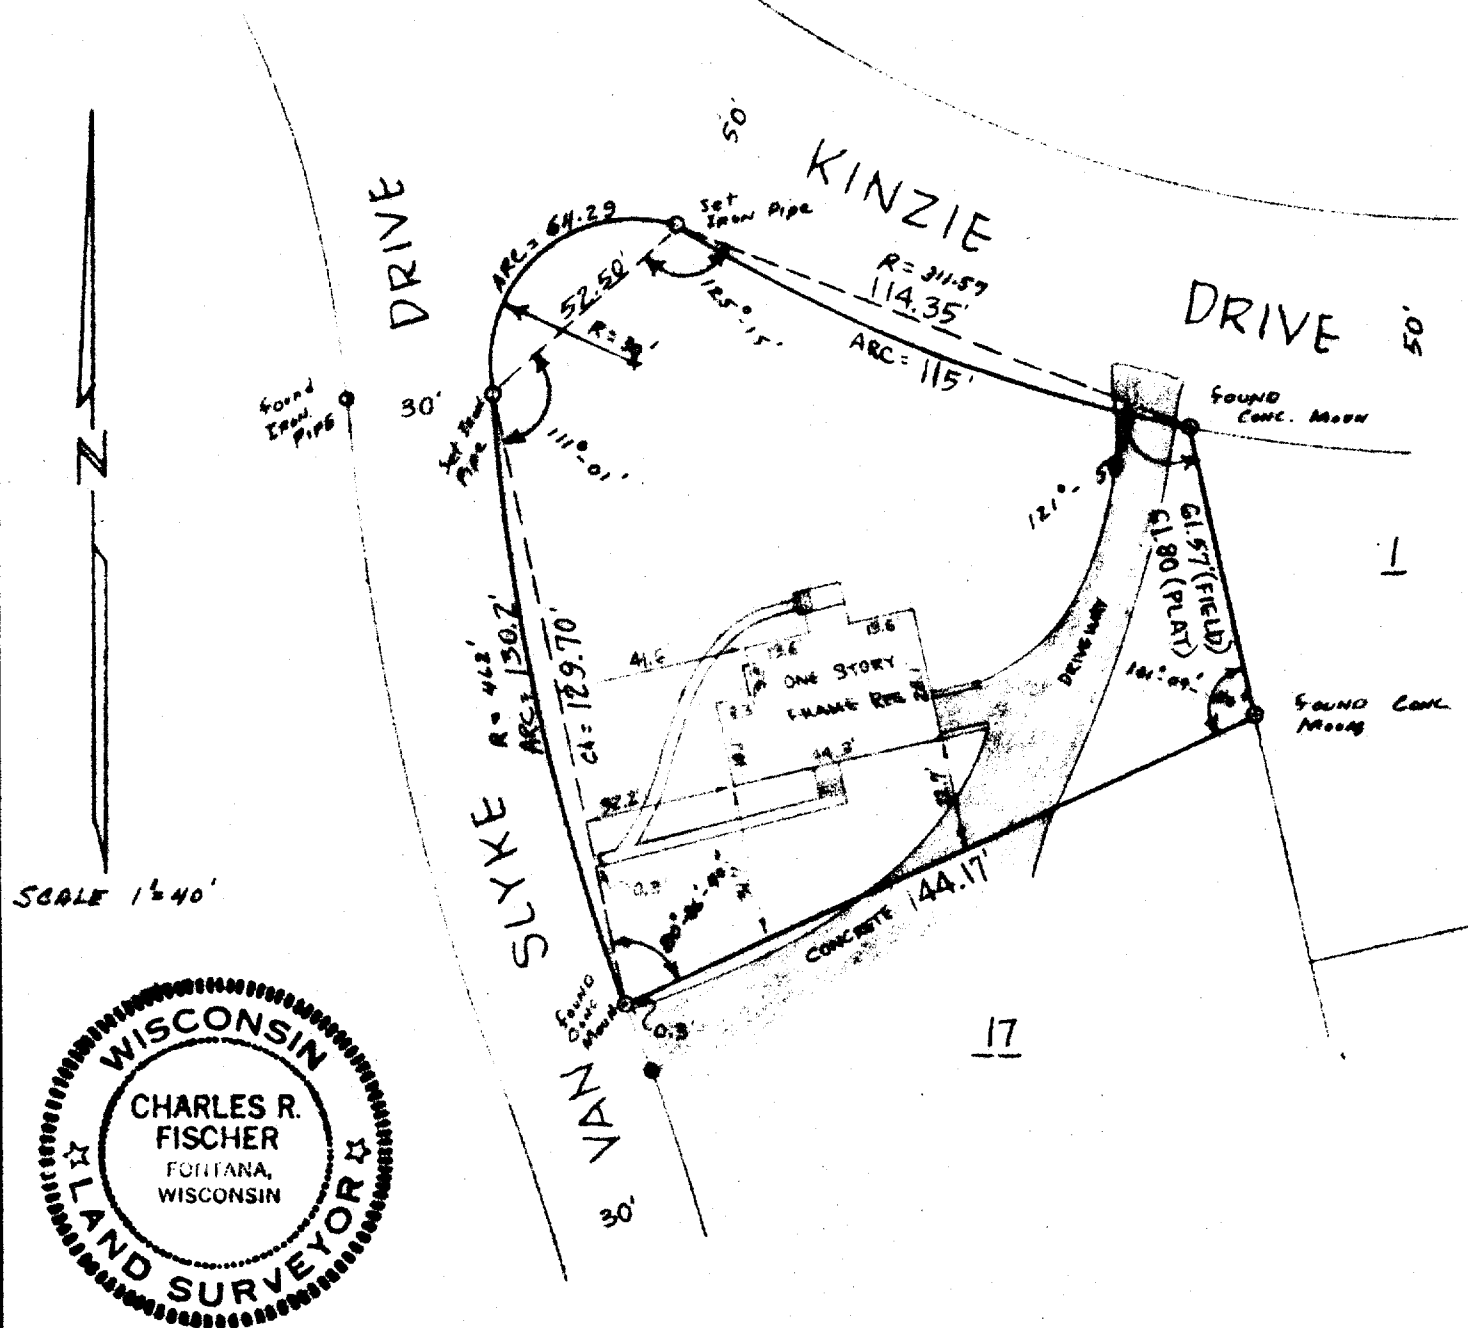

5003-95