
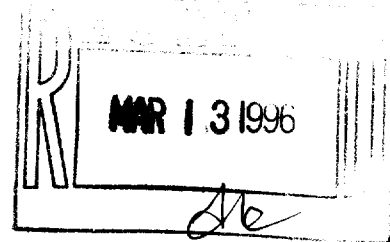


**ABELL
SURVEYING & MAPPING
DELANAN, WISCONSIN 53115
414-728-6737**

ORDERED BY: STEBNITZ BUILDERS
P.O. BOX 526
DELANAN, WI 53115

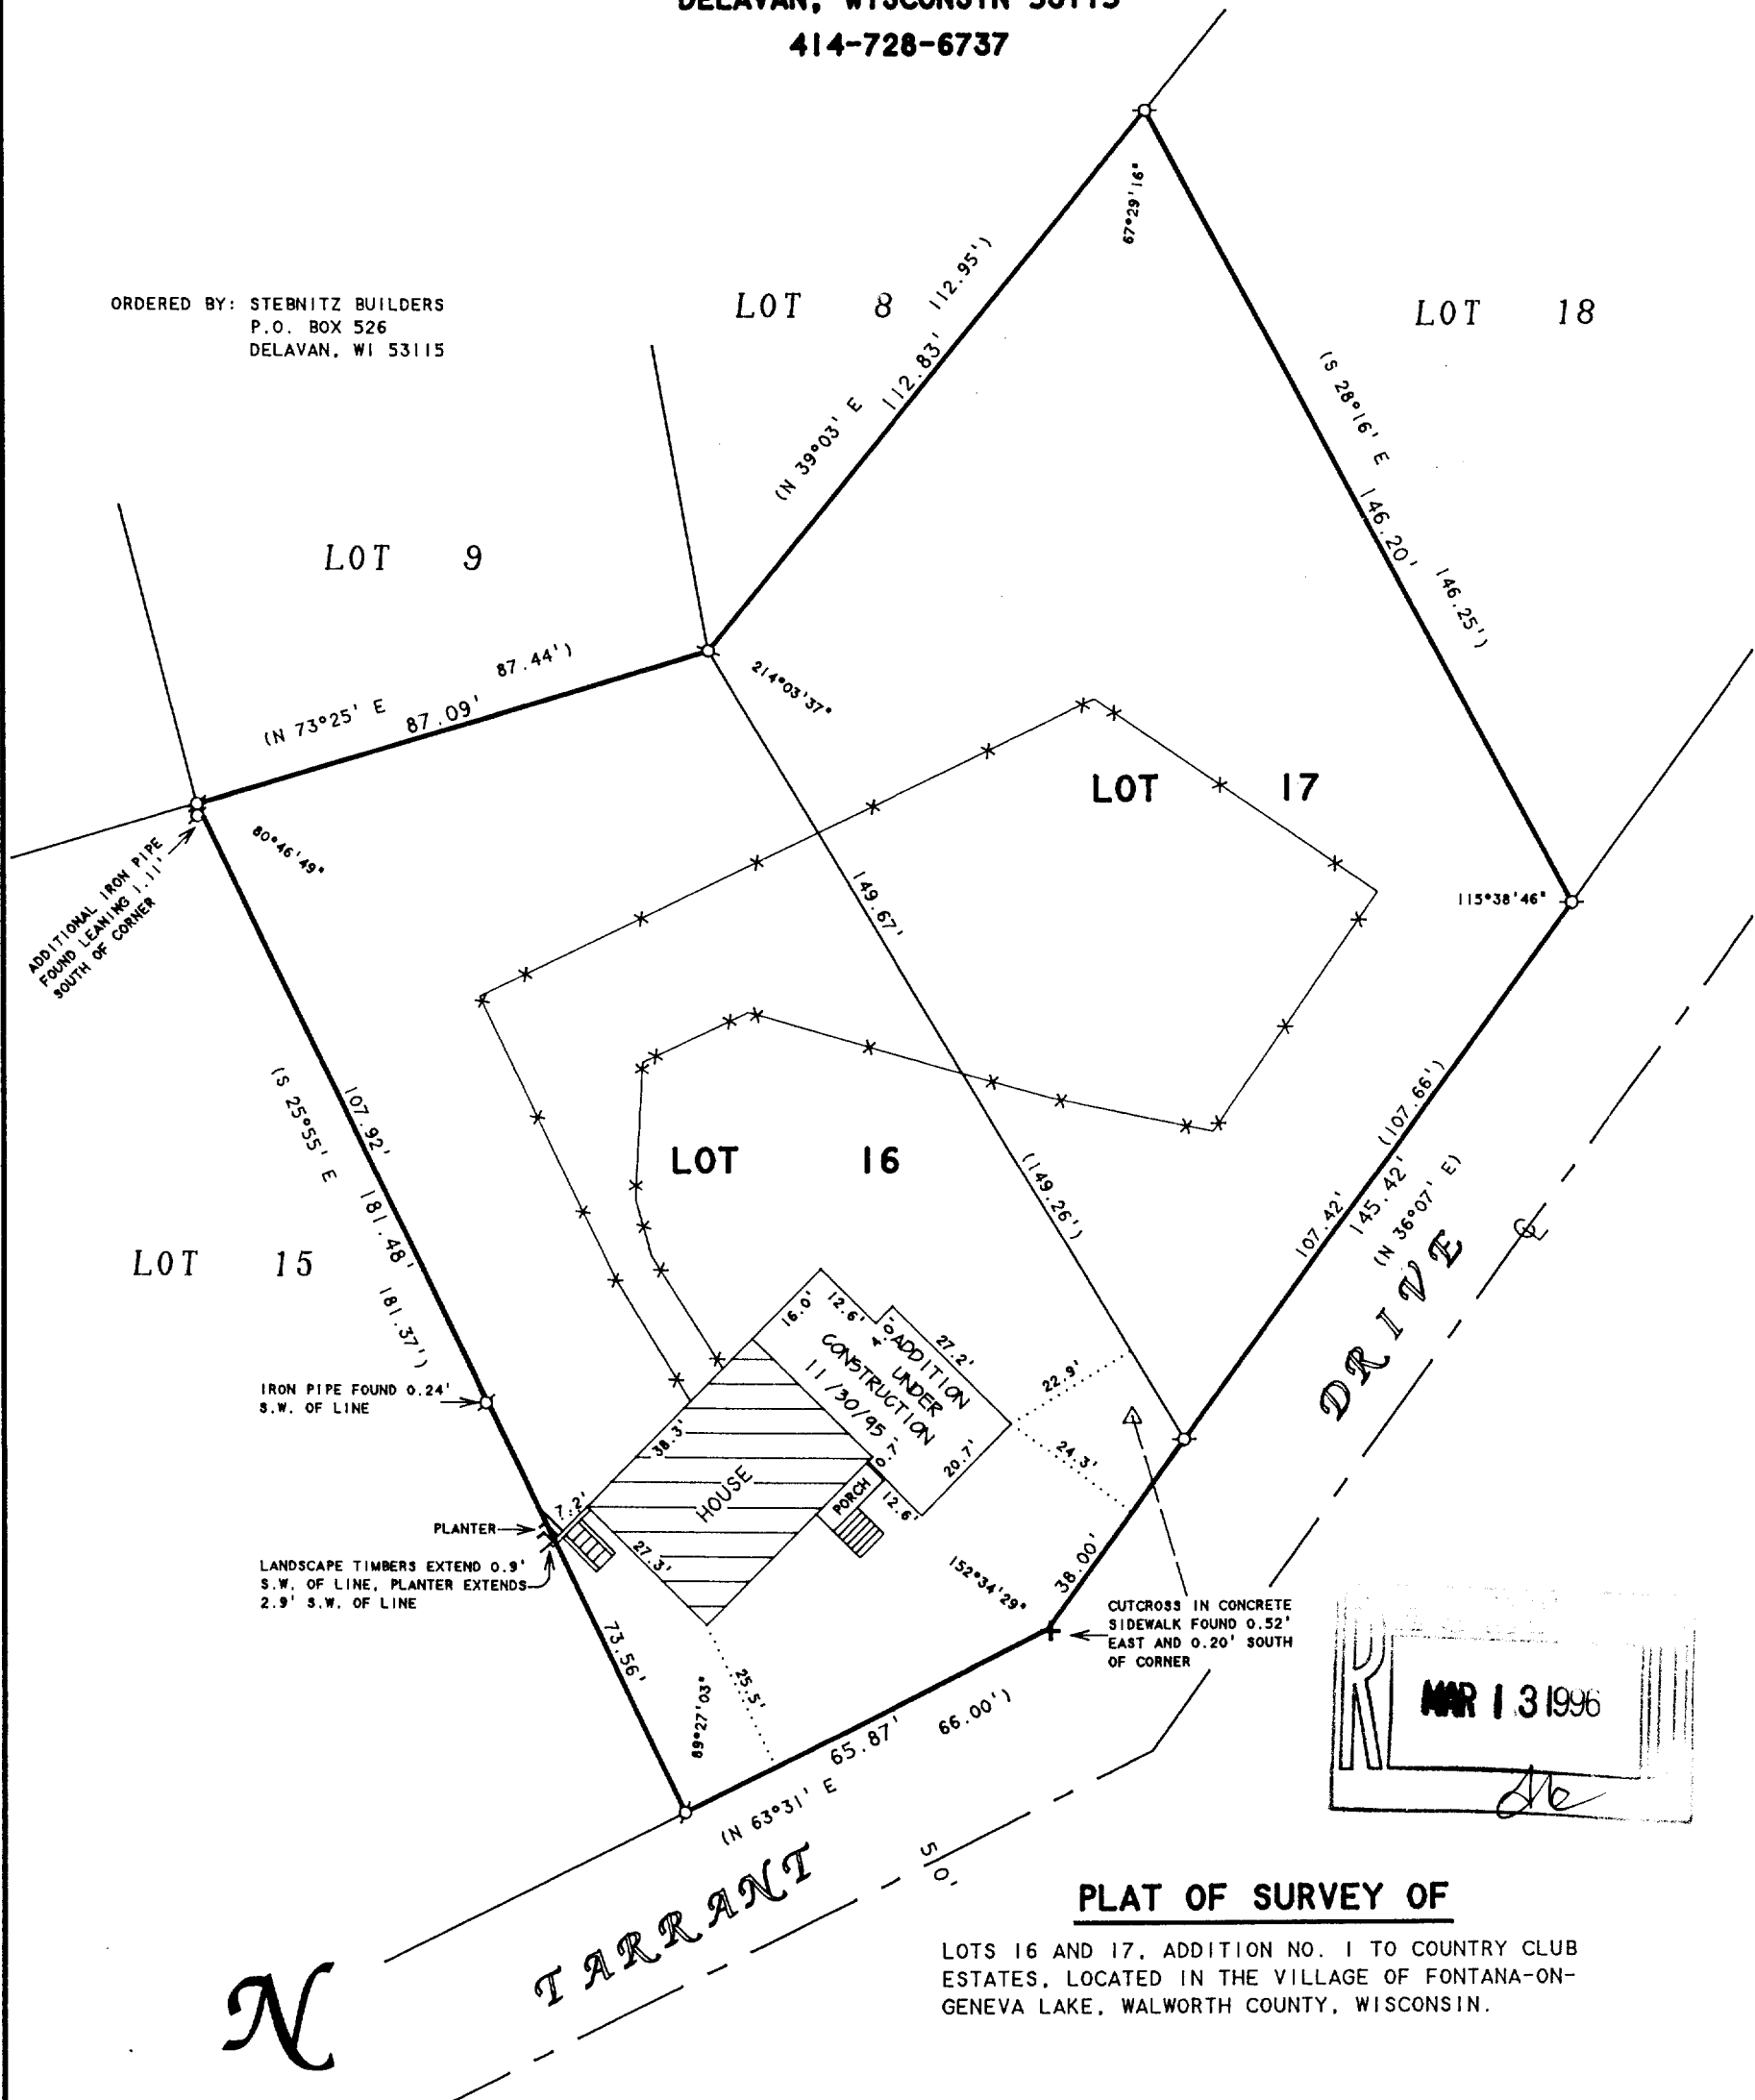

SCALE 1"=30'

LEGEND

- ⊙ -IRON PIPE FOUND
- ✕ -CUTCROSS IN CONCRETE FOUND
- △ -UTILITY POLE
- -OVERHEAD UTILITY LINES
- * -CHAINLINK FENCE
- () -RECORDED AS

I HEREBY CERTIFY THAT I HAVE SURVEYED THE ABOVE DESCRIBED PROPERTY AND THAT THE ABOVE MAP IS A TRUE REPRESENTATION THEREOF AND SHOWS THE SIZE AND LOCATION OF THE PROPERTY, ITS EXTERIOR BOUNDARIES, THE LOCATION OF ALL VISIBLE STRUCTURES AND DIMENSIONS OF ALL PRINCIPAL BUILDINGS THEREON, BOUNDARY FENCES, APPARENT EASEMENTS, ROADWAYS AND VISIBLE ENCROACHMENTS, IF ANY, TO THE BEST OF MY KNOWLEDGE AND BELIEF.

THIS SURVEY IS MADE FOR THE USE OF THE PRESENT OWNERS OF THE PROPERTY, AND ALSO THOSE WHO PURCHASE, MORTGAGE, OR GUARANTEE THE TITLE THERETO WITHIN ONE (1) YEAR FROM DATE HEREON.

David F. Abell

DAVID F. ABELL
WISCONSIN REGISTERED LAND SURVEYOR, S-1596

December 1, 1995

DATE: _____ JOB NUMBER - 95209
NOTE: THIS IS NOT A CERTIFIED COPY UNLESS SEALED.

SCT-16

005-1538