


ABELL
SURVEYING & MAPPING
DELAVAN, WISCONSIN 53115
414-728-6737

ORDERED BY: ROBERT LANGE
1929 WEXFORD CIRCLE
WHEATON, IL 60187




FOUND IRON PIPE IN BLACKTOP
DRIVE LEANING 0.33' SOUTH
AND 0.38' EAST OF CORNER

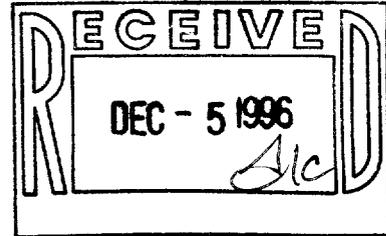

SCALE 1"=20'

LEGEND

- ⊘ - IRON PIPE FOUND
- * - WOOD FENCE
- () - RECORDED AS

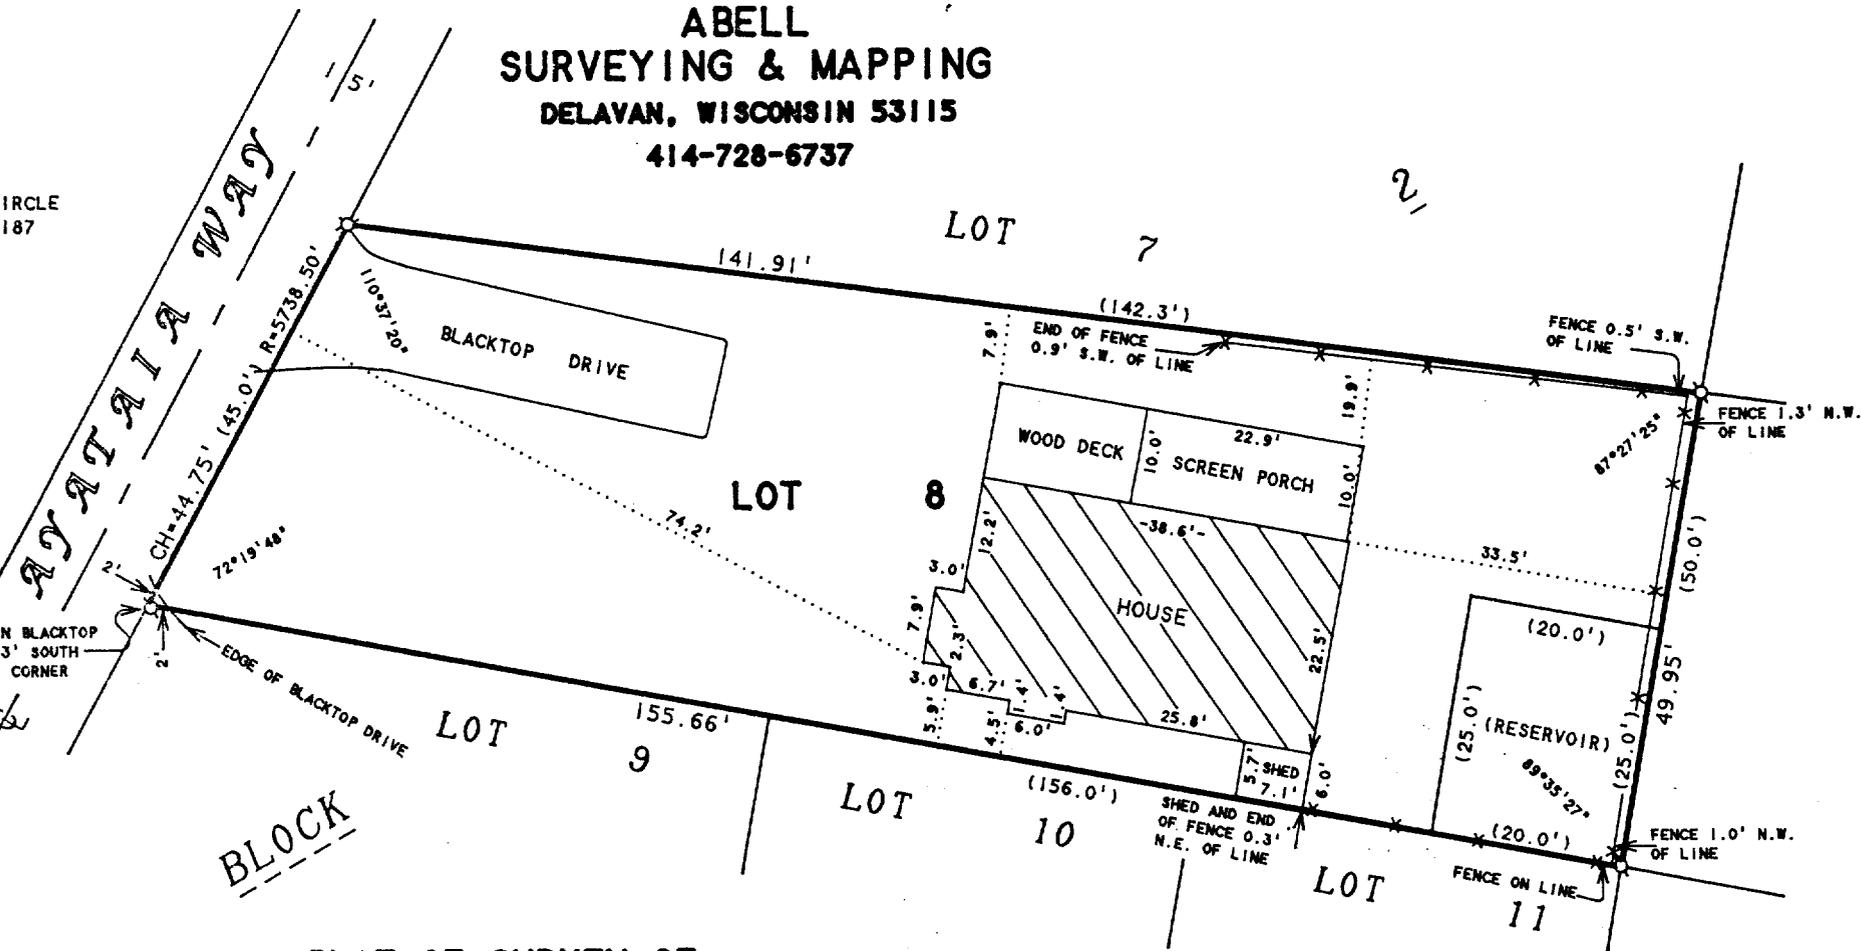

PLAT OF SURVEY OF

LOT 8, BLOCK 2, INDIAN HILLS, LOCATED IN
THE VILLAGE OF FONTANA, WALWORTH COUNTY,
WISCONSIN.

I, DAVID F. ABELL, DO HEREBY CERTIFY THAT I HAVE SURVEYED THE PROPERTY HEREON
DESCRIBED ACCORDING TO THE OFFICAL RECORDS AND THAT THE PLAT HEREON IS A
CORRECT REPRESENTATION OF THE PROPERTY LINES TO THE BEST OF MY KNOWLEDGE AND
BELIEF.

David F. Abell

DAVID F. ABELL
WISCONSIN REGISTERED LAND SURVEYOR, S-1596

June 29, 1996

DATE: June 29, 1996 JOB NUMBER - 96098
NOTE: THIS IS NOT A CERTIFIED COPY UNLESS SEALED.

514-38
005-1549