


GENEVA LAKE

LOT # 3
1ST ADDITION

LOT # 2

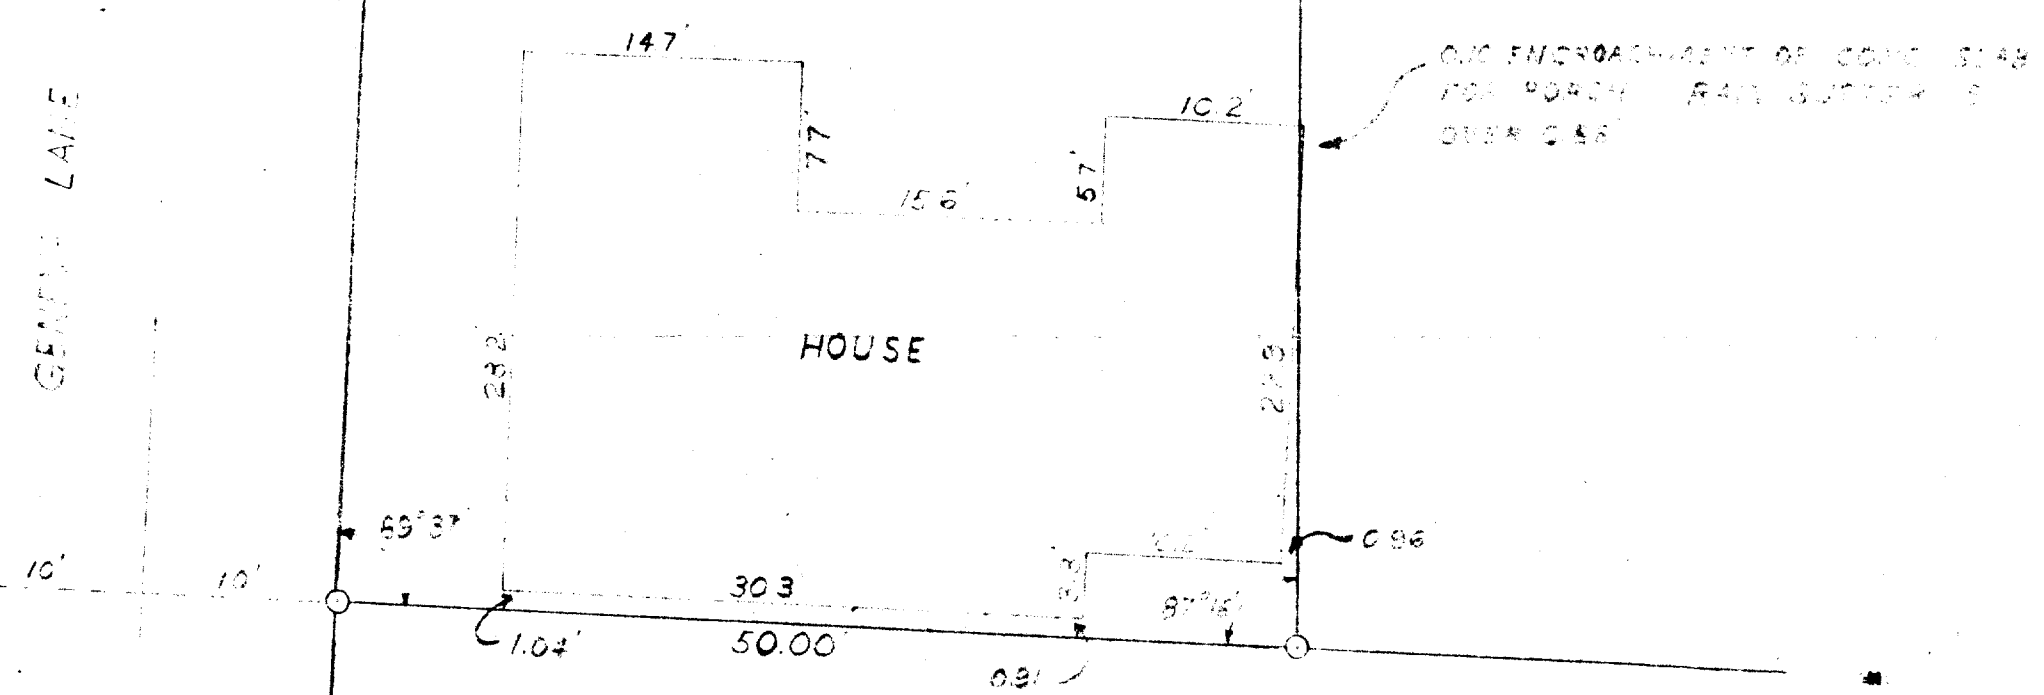

PLAT OF SURVEY
OF

LOT # 3 BLOCK # 3 OF INDIAN
HILLS 1ST ADDITION

Floyd S. Jensen
SURVEYOR

SCALE 1" = 10'

DATE JUNE 24, 1959