


PLAT OF SURVEY


LOT 21 OF BLOCK 6 OF INDIAN HILLS
SUBDIVISION AND LOT 1 OF BLOCK 7 OF INDIAN
HILLS 1ST ADDITION TO THE VILLAGE OF FONTANA
- ON - GENEVA LAKE, WALWORTH COUNTY,
WISCONSIN.

OWNER: ROBERT BOUDART
3605 KILLARNEY CT.
ROLLING MEADOWS, IL. 60008

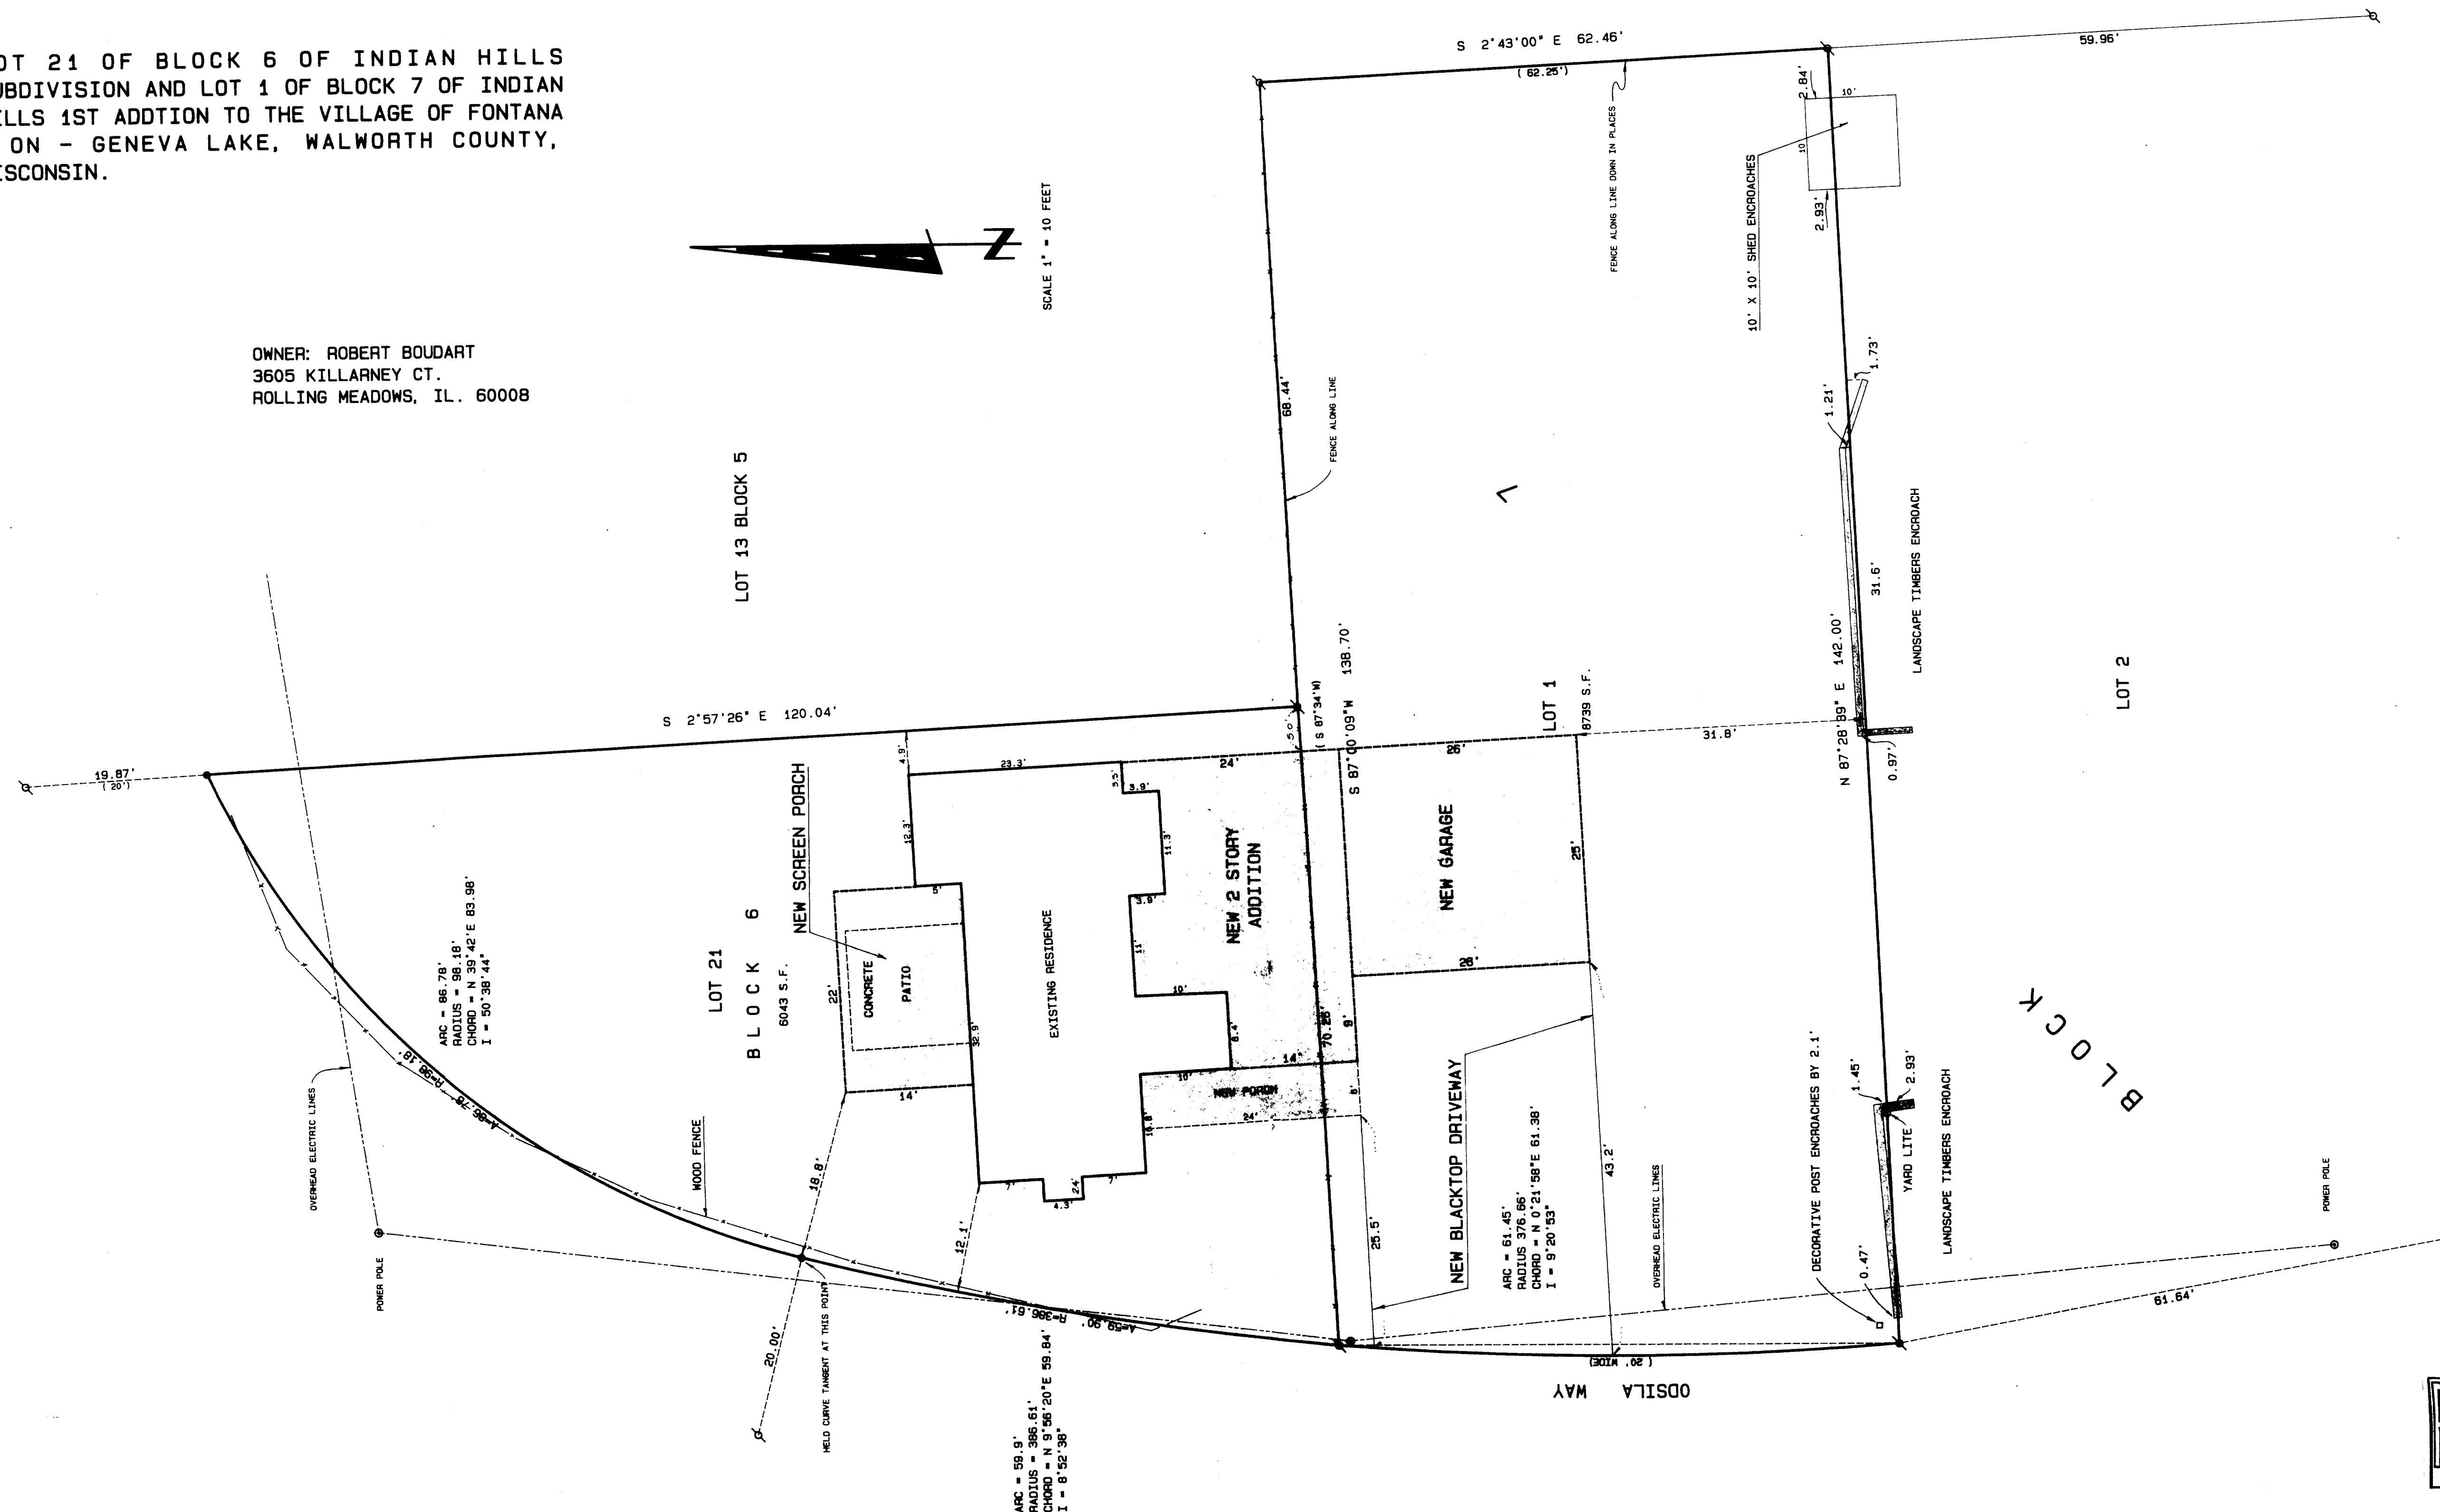

Legend

- FOUND IRON PIPE
- FOUND IRON ROD
- FOUND BRASS CAPPED MONUMENT
- FOUND CONCRETE MONUMENT
- CHISEL CUT IN CONCRETE
- SET IRON ROD, 24" LONG, WEIGHING 1.5 LBS./LINEAL FT., 2 1/4" DIA.
- SET IRON ROD, 30" LONG, WEIGHING 4.5 LBS./LINEAL FT., 1 1/16" DIA.
- RECORDED AS DIMENSION
- EXISTING FENCE

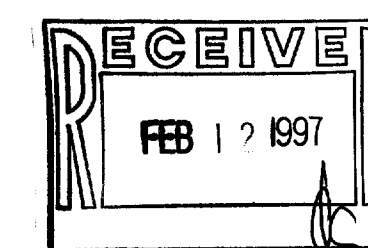

SCALE: 1" = 10 FEET

REVISED 12/23/96



I hereby certify that the above described property has been surveyed by me or under my direction and that the above map is a true representation thereof and shows the size and location of the property, its exterior boundaries, the location of all visible structures and dimensions of all principal buildings thereon, boundary fences, apparent easements, roadways and visible encroachments, if any.

This survey is made for the use of the present owners of the property, and also those who purchase, mortgage, or guarantee the title thereto within one year from date hereof.

Kenneth B. Abernathy, Jr.
KENNETH B. ABERNATHY, JR.
WISCONSIN REGISTERED LAND SURVEYOR,
S-1594

Date: July 15, 1996 Job No. 99716