

ROBERS and FISCHER, INC.

~~HOGANSON & ROBERS, INC.~~


CONSULTING ENGINEERS & LAND SURVEYORS

PHONE (414) 763-2652

116 E. CHESTNUT ST.

BURLINGTON, WIS. 53105

Plat of Survey and House Location
of
Lot 95 Buena Vista Park
Village of Fontana-on-Geneva Lake
Walworth County, Wisconsin

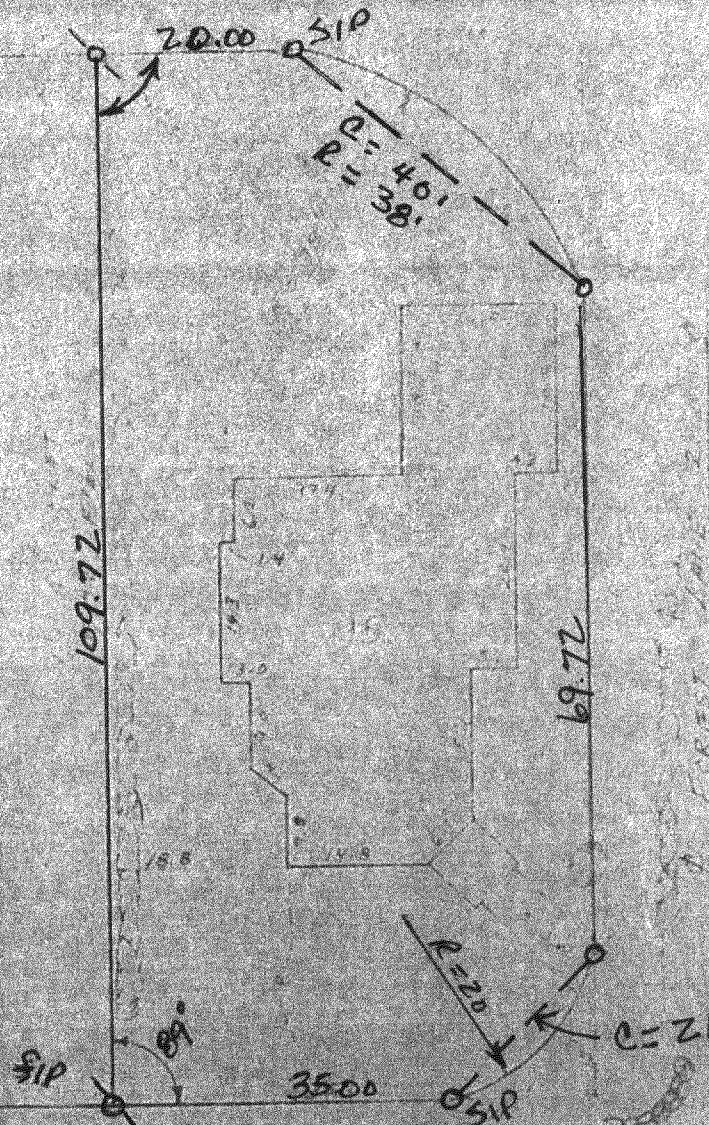

SCALE 1" = 20'
R SIP 4" IRON PIPE
O SIP 5/8" IRON PIPE

FIRST AVE

1st FIRST AVE

66' R.O.W

NOTE: DIMENSIONS SHOWN TAKEN FROM ORIG PLAT &
GATHERED FROM ORIG OF THIS SURVEY - ADDED BY THIS
OFFICE 8-19-94 JLM

I HEREBY CERTIFY THAT WE HAVE SURVEYED THE LANDS DESCRIBED
ABOVE ACCORDING TO OFFICIAL RECORDS AND THAT THE PLAT
DRAWN HEREON IS A CORRECT REPRESENTATION OF SAID SURVEY.

Charles R. Fischer
WIS. REG. LAND SURVEYOR 5-821

DATE

5/20/70

5-158

JOB NO.

*70047

580-68