
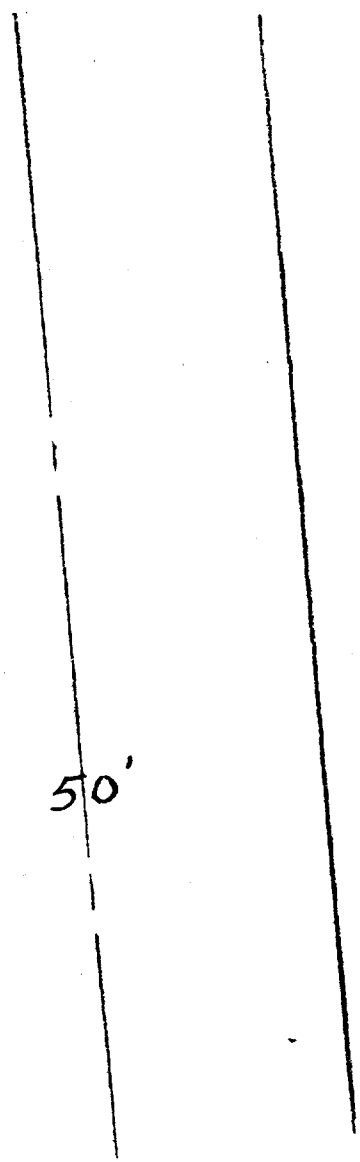


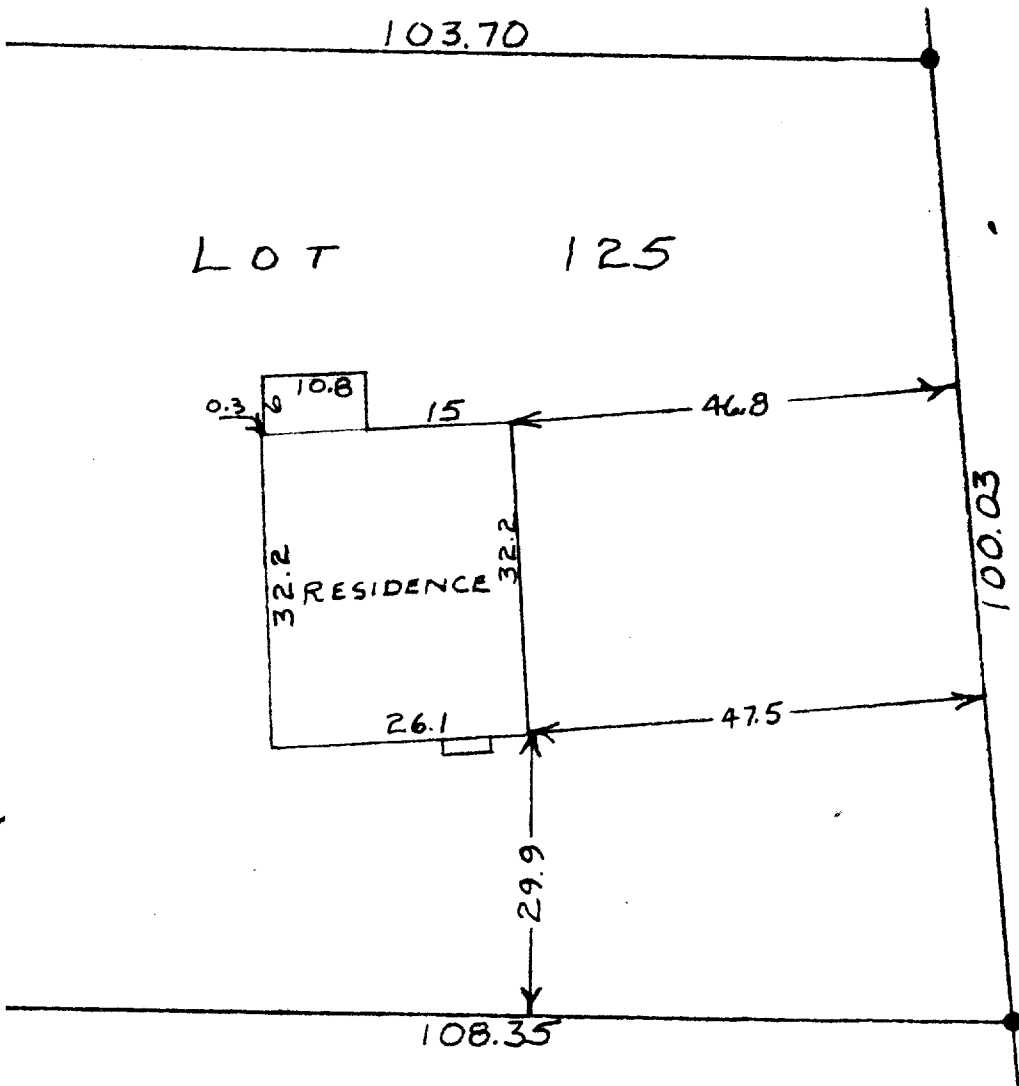

SCALE 1" = 50'
 ● = CONC. M.

STATE OF WISCONSIN)
 WALWORTH COUNTY)

I, GEORGE T. DUNHAM, DO HEREBY CERTIFY THAT I HAVE SURVEYED THE
 PROPERTY DESCRIBED AS FOLLOWS:

LOT 125 OF SUBDIVISION OF COUNTY CLUB ESTATES UNIT NO. 2 LOCATED IN
 THE VILLAGE OF FONTANA, WALWORTH COUNTY, WISCONSIN.

AND THAT THE PLAT SHOWN ABOVE IS A CORRECT REPRESENTATION OF THE PROPERTY
 LINES AND OF THE IMPROVEMENTS LOCATED THEREON
 MAY 28, 1958

SC02-118

George T. Dunham
 GEORGE T. DUNHAM, SURVEYOR 5-1
 DELAWARE, WISCONSIN