



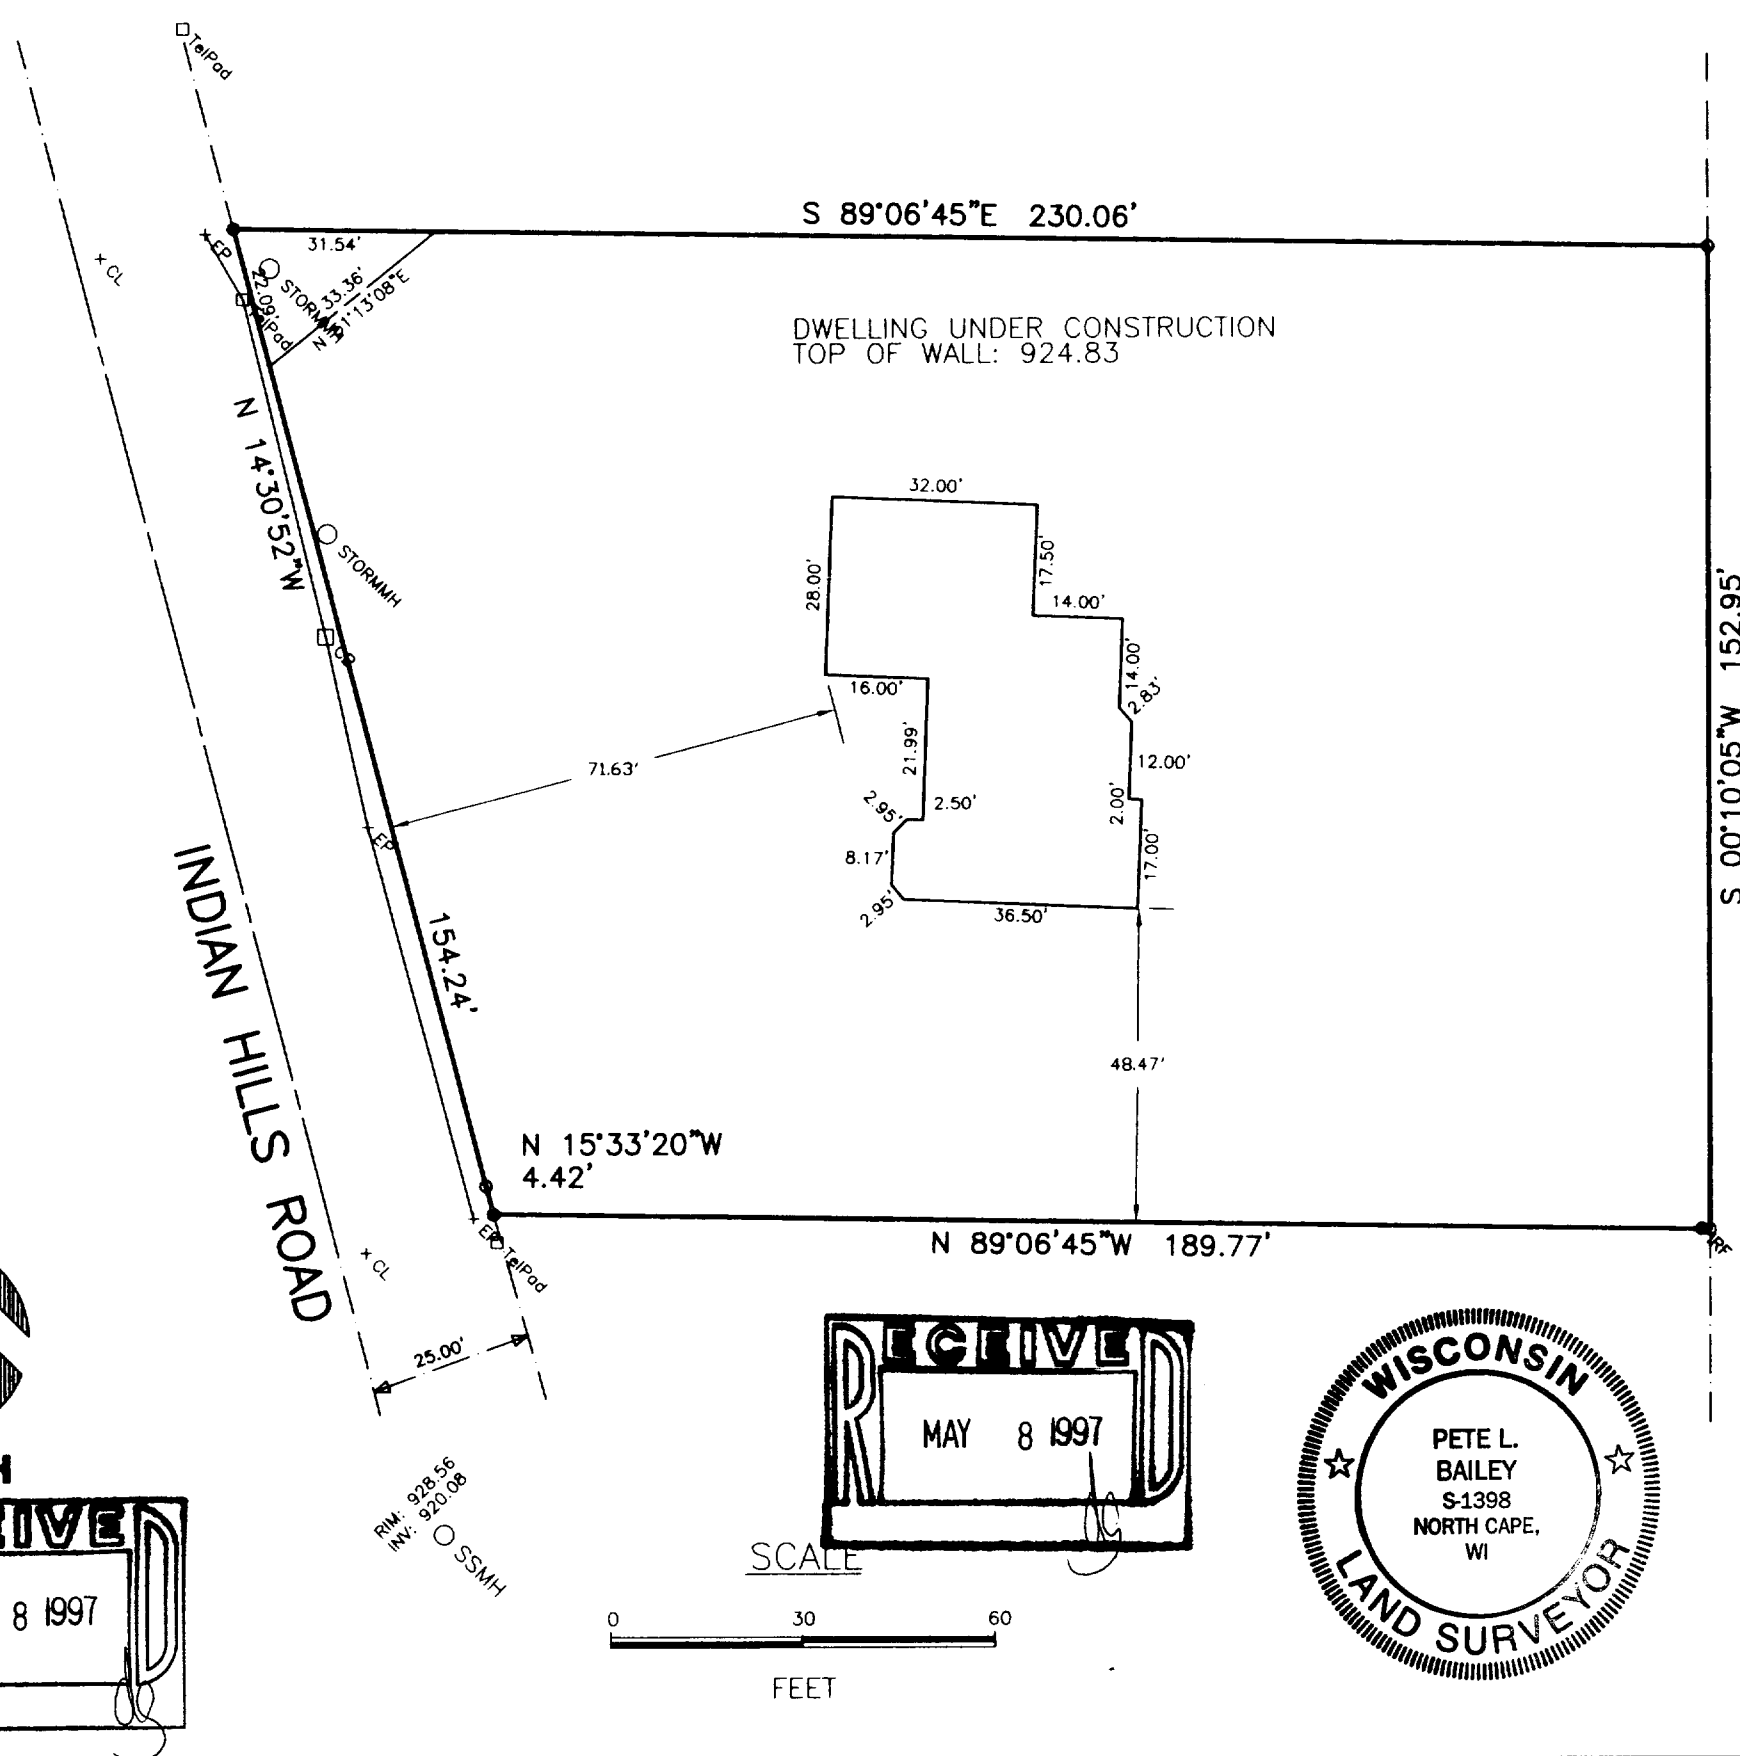

12207 C.T.H. "K" FRANKSVILLE, WISCONSIN 53126
TEL. (414) 835-4774 FAX: (414) 835-2379

PREPARED FOR: PEMBROOKE HOMES, LLC

DESCRIPTION: LOT 2 OF CERTIFIED SURVEY MAP NO. _____, BEING A PART OF THE SOUTHEAST 1/4 OF THE SOUTHEAST 1/4 OF SECTION 14, TOWN 1 NORTH, RANGE 16 EAST, IN THE VILLAGE OF FONTANA, COUNTY OF WALWORTH, STATE OF WISCONSIN.

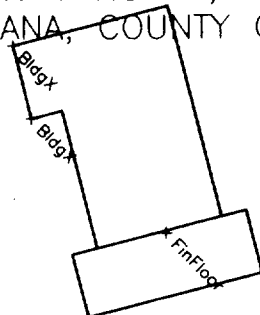

STATE OF WISCONSIN
COUNTY OF RACINE

The above described property has been surveyed under my direction and the above map is a correct representation thereof.

Dated at North Cape, WI, this 20TH day of NOVEMBER, 1996.

Recertified: FEBRUARY 16TH, 1997

Pete L. Bailey R.L.S. 1398

JOB NO. 96321
DRAWING NAME: JN96532

005-1605
SA ²⁷¹³ ~~1605~~-2