

**HOGANSON & ROBERS, INC.**  
CONSULTING ENGINEERS & LAND SURVEYORS

PHONE (414) 763-2652


116 E. CHESTNUT ST.

BURLINGTON, WIS. 53105

PLAT OF SURVEY

Lot "W" of the Gardens, Subdivision No. 2, of Fontana-on-Geneva Lake, Wisconsin.

— LEGEND —  
O IRON PIPE SET  
SCALE 1" = 40'

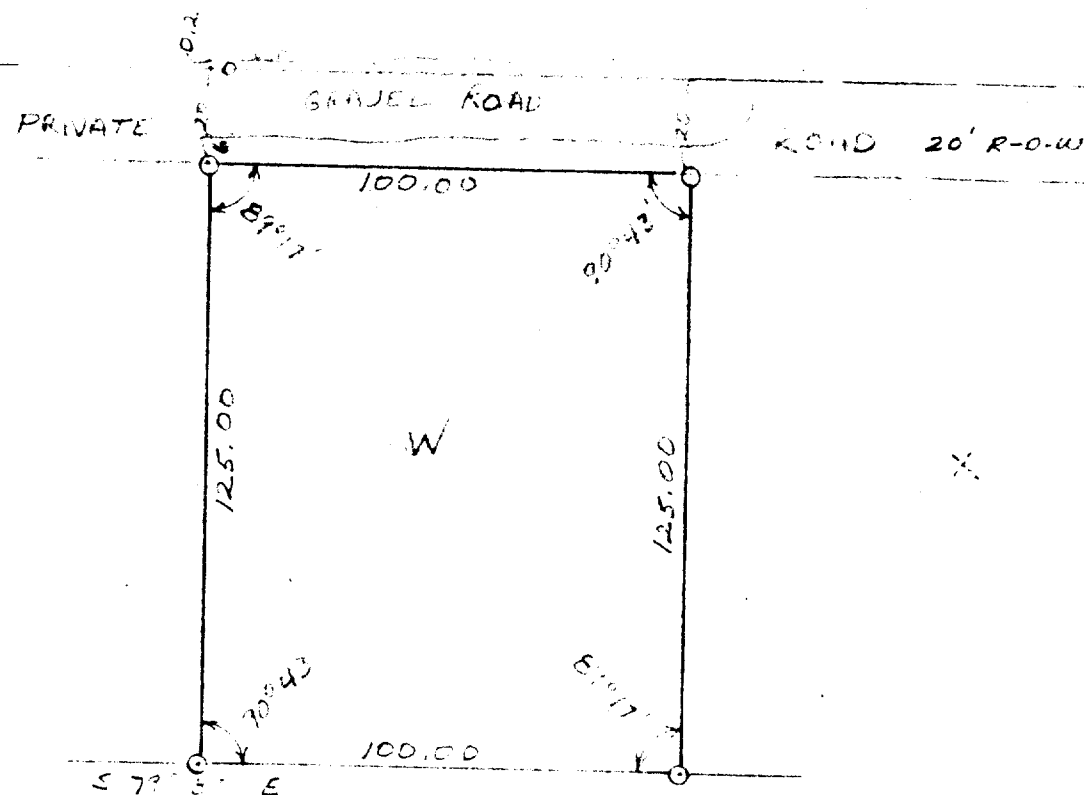

I HEREBY CERTIFY THAT WE HAVE SURVEYED THE LANDS DESCRIBED ABOVE ACCORDING TO OFFICIAL RECORDS AND THAT THE PLAT DRAWN HEREON IS A CORRECT REPRESENTATION OF SAID SURVEY.

*Charles A. Huls*  
WIS. REG. LAND SURVEYOR

DATE *5-16-79*

JOB NO. *70053*

