


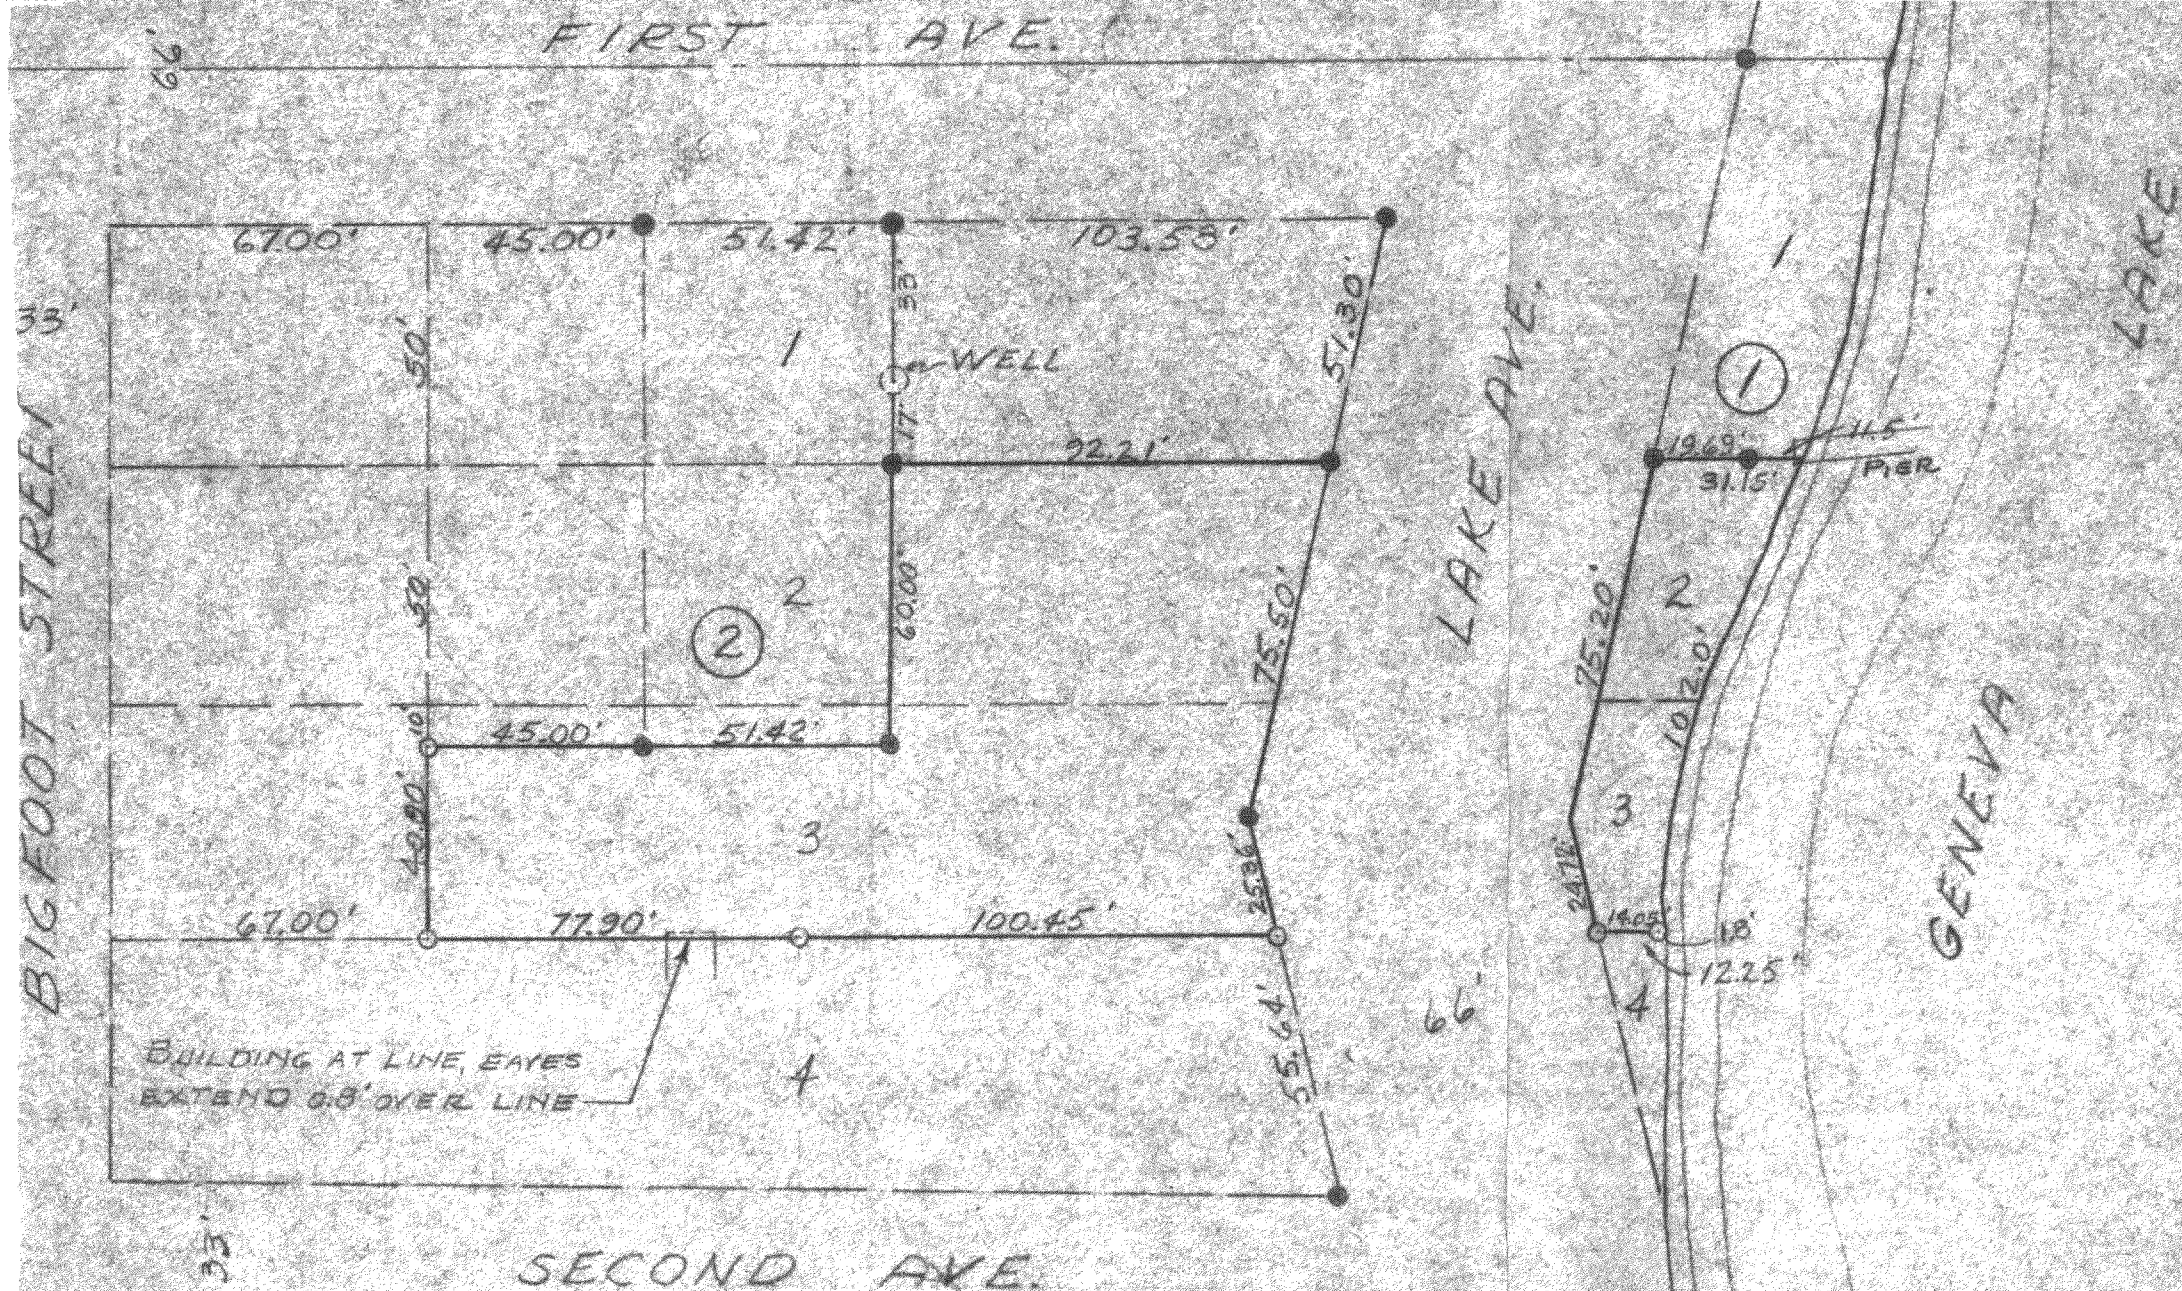

Note: The well shown on the above plat is a drilled well and was assumed to be the well that is mentioned in the descriptions in the deeds for the several properties in Block 2 of D. A. Reid's Addition to Reid's Park.

SCALE 1"=40'
●=CONC. MONU.
○=IRON PIPE

PLAT OF SURVEY OF

PART OF LOTS 2 AND 3, BLOCK 2,
LOTS 2 AND 3, BLOCK 1, D. A. REID'S
ADDITION TO REID'S PARK SUBD.

Floyd L. Jensen
SURVEYOR

SCALE 1" = 40'

DATE AUGUST 3, 1960

SRA-1, 2, 3, 4, 5 (well location)
and
SRA-9

5-161 J