


GEORGE T. DUNHAM
SURVEYING & SUBDIVIDING
DELAVER, WISCONSIN

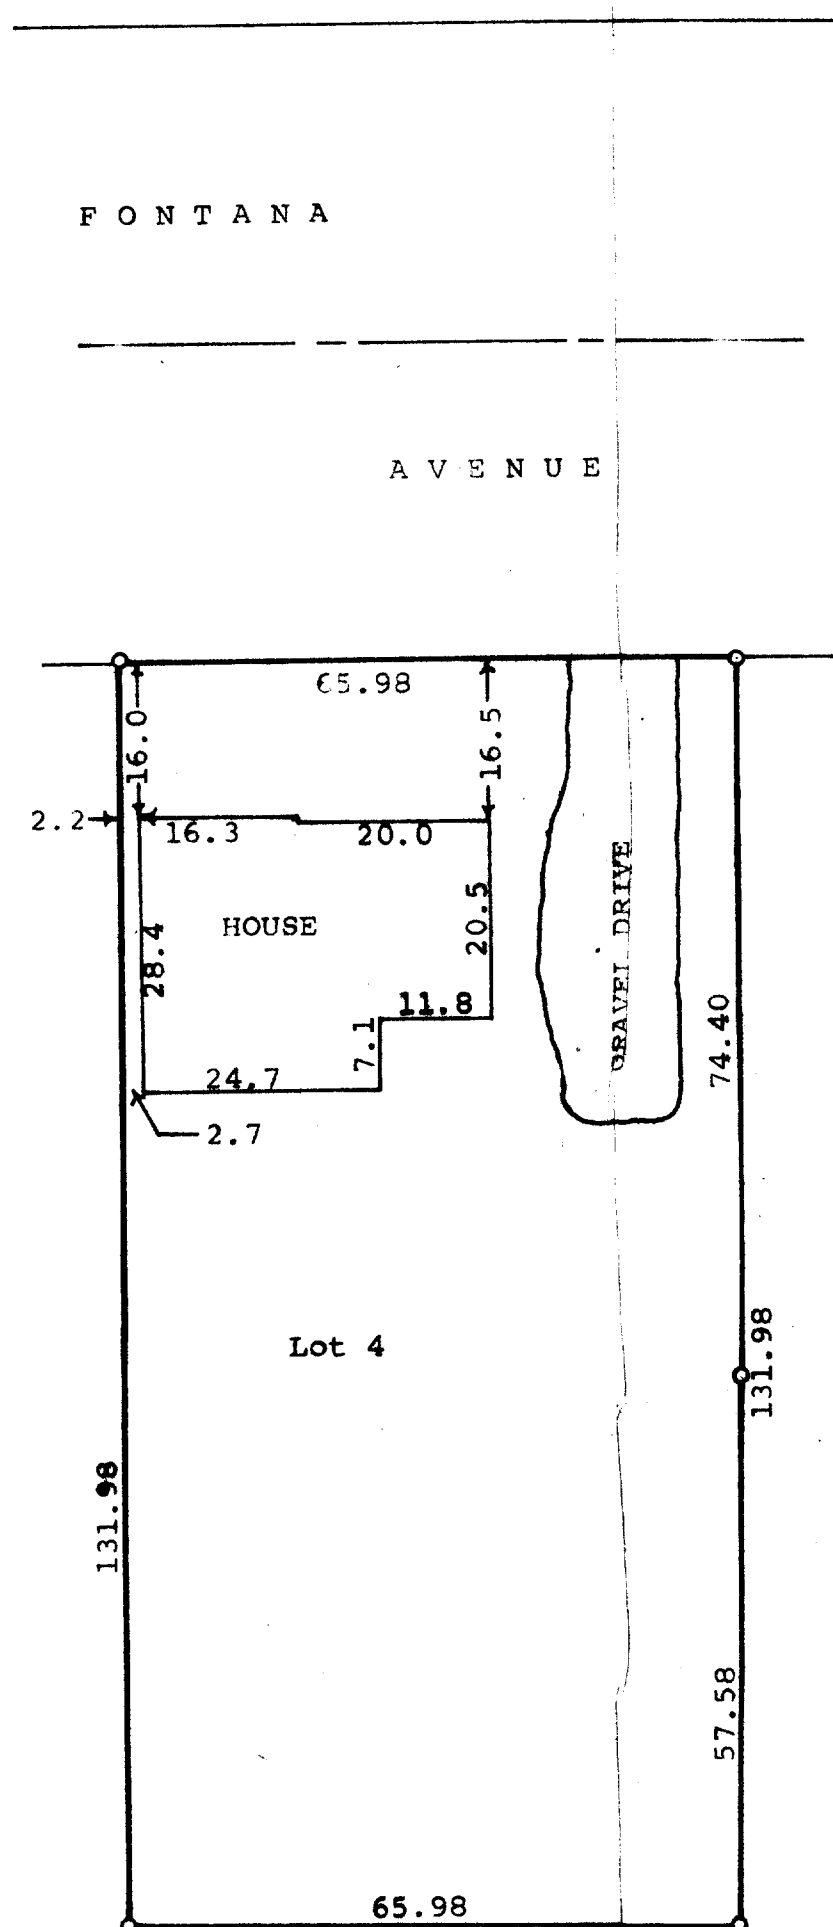

Scale - 1" = 20'
O = Iron Pipe

STATE OF WISCONSIN)
COUNTY OF WALWORTH) SS

I, George T. Dunham, Surveyor certify that I have surveyed the property described as follows,

Lot 4, Block 5, C. L. Douglas Subdivision, Part of Assessor's Plat No. 1, Village of Fontana, Walworth County, Wisconsin and that the above plat is an accurate survey and a true representation thereof and correctly shows the exterior boundary lines and location of buildings on said property and the correct measurements thereof.
May 14, 1974

George T. Dunham
George T. Dunham, Surveyor

