




**ABELL
SURVEYING & MAPPING**
1140 SEQUOIA STREET • DELAVAN, WISCONSIN 53115
414-728-6737

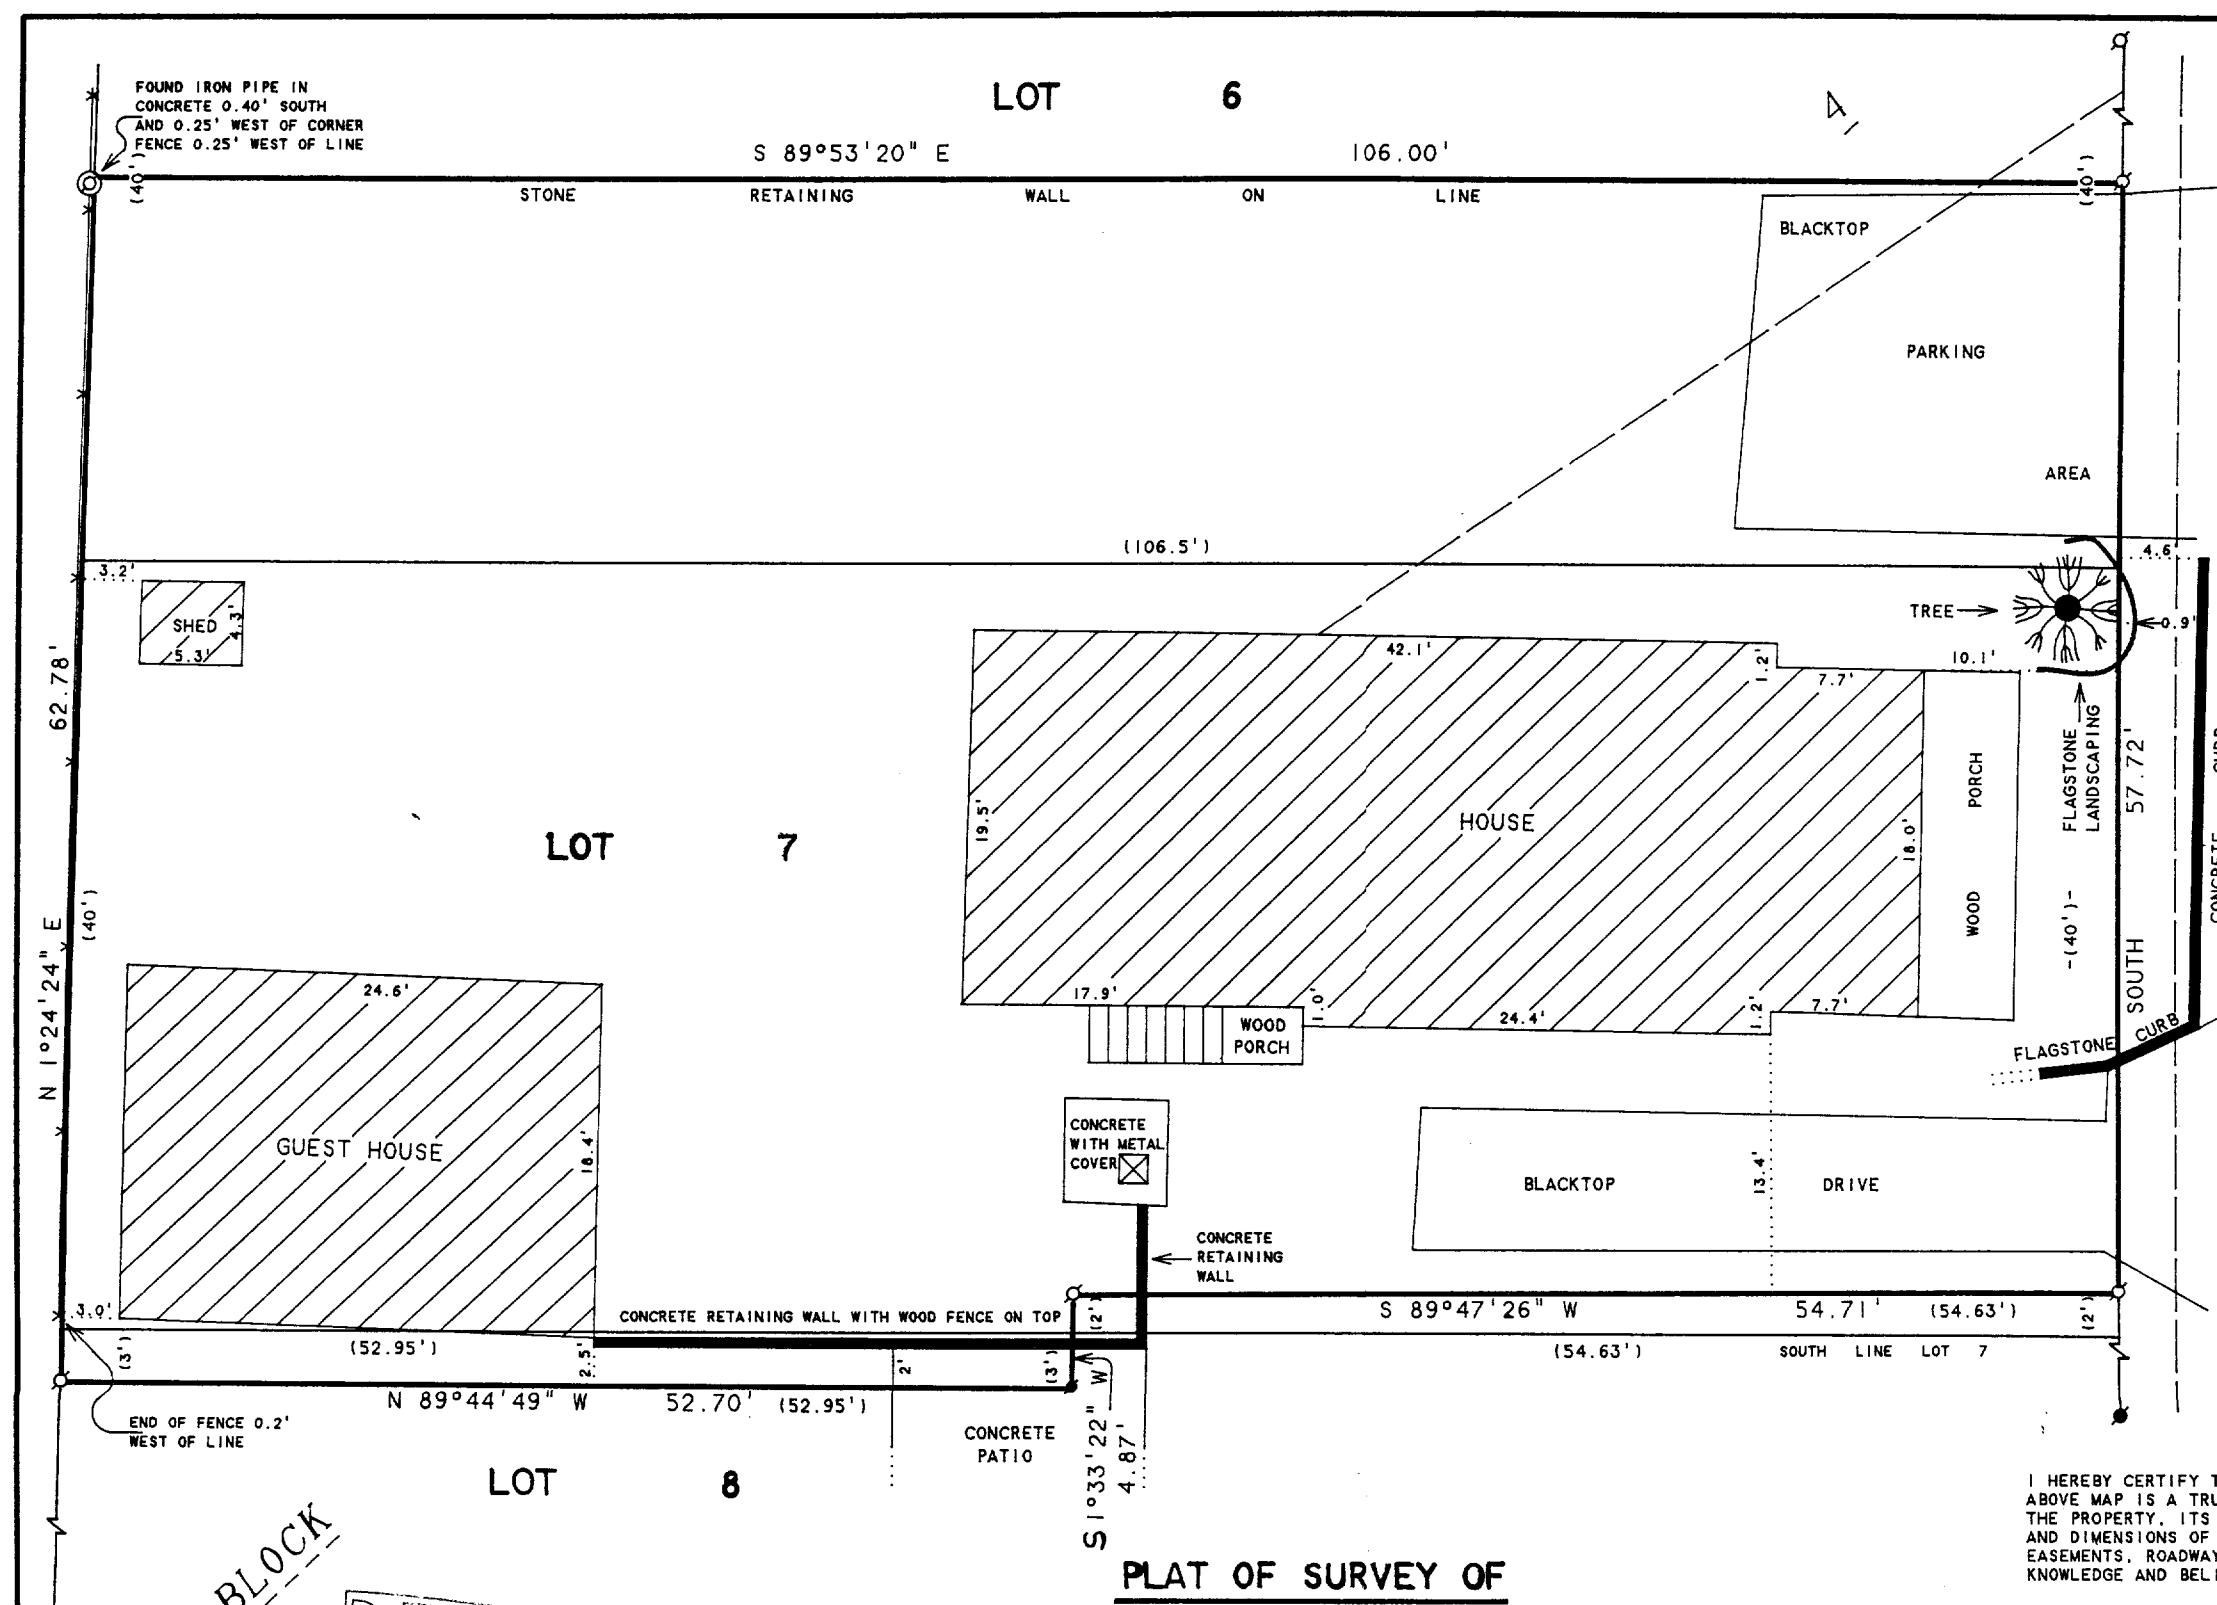

SCALE 1"=10'

LEGEND

- ⊙ - IRON PIPE FOUND
- ⊙ - IRON PIPE IN CONCRETE FOUND
- - IRON PIN FOUND
- - IRON ROD FOUND
- * - WOOD FENCE
- - OVERHEAD UTILITY LINES
- () - RECORDED AS

ORDERED BY: KEEFE REAL ESTATE
P.O. BOX 460
LAKE GENEVA, WI 53147

NOTE: THE BEARING OF THE WEST
LINE OF REID STREET IS
ASSUMED NORTH-SOUTH.

PLAT OF SURVEY OF

The South 1/2 of Lot 6 in Block 4; Lot 7 in Block 4 excluding the South 2 feet of the East 54.63 feet; the North 3 feet of the West 52.95 feet of Lot 8 in Block 4 of D. A. Reids Addition to Reids Park, in the Village of Fontana, Walworth County, Wisconsin.


Tax Key No. SRA 00025

I HEREBY CERTIFY THAT I HAVE SURVEYED THE ABOVE DESCRIBED PROPERTY AND THAT THE ABOVE MAP IS A TRUE REPRESENTATION THEREOF AND SHOWS THE SIZE AND LOCATION OF THE PROPERTY, ITS EXTERIOR BOUNDARIES, THE LOCATION OF ALL VISIBLE STRUCTURES AND DIMENSIONS OF ALL PRINCIPAL BUILDINGS THEREON, BOUNDARY FENCES, APPARENT EASEMENTS, ROADWAYS AND VISIBLE ENCROACHMENTS, IF ANY, TO THE BEST OF MY KNOWLEDGE AND BELIEF.

THIS SURVEY IS MADE FOR THE USE OF THE PRESENT OWNERS OF THE PROPERTY, AND ALSO THOSE WHO PURCHASE, MORTGAGE, OR GUARANTEE THE TITLE THERETO WITHIN ONE (1) YEAR FROM DATE HEREON.

David F. Abell
DAVID F. ABELL
WISCONSIN REGISTERED LAND SURVEYOR, S-1596

December 15, 1997
DATE: _____ JOB NUMBER - 97226
NOTE: THIS IS NOT A CERTIFIED COPY UNLESS SEALED.

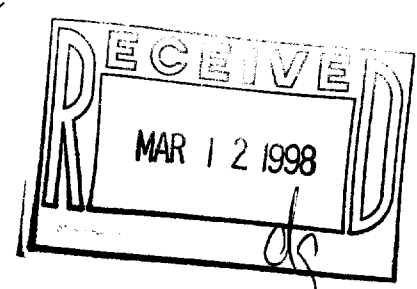

SRA-25

005-1641