


5. THEORY

21-56 Ice Gardens (revised plat)
 1000 ft. Fortuna-on-Geneva Lake
 Waubesa County, Wisconsin

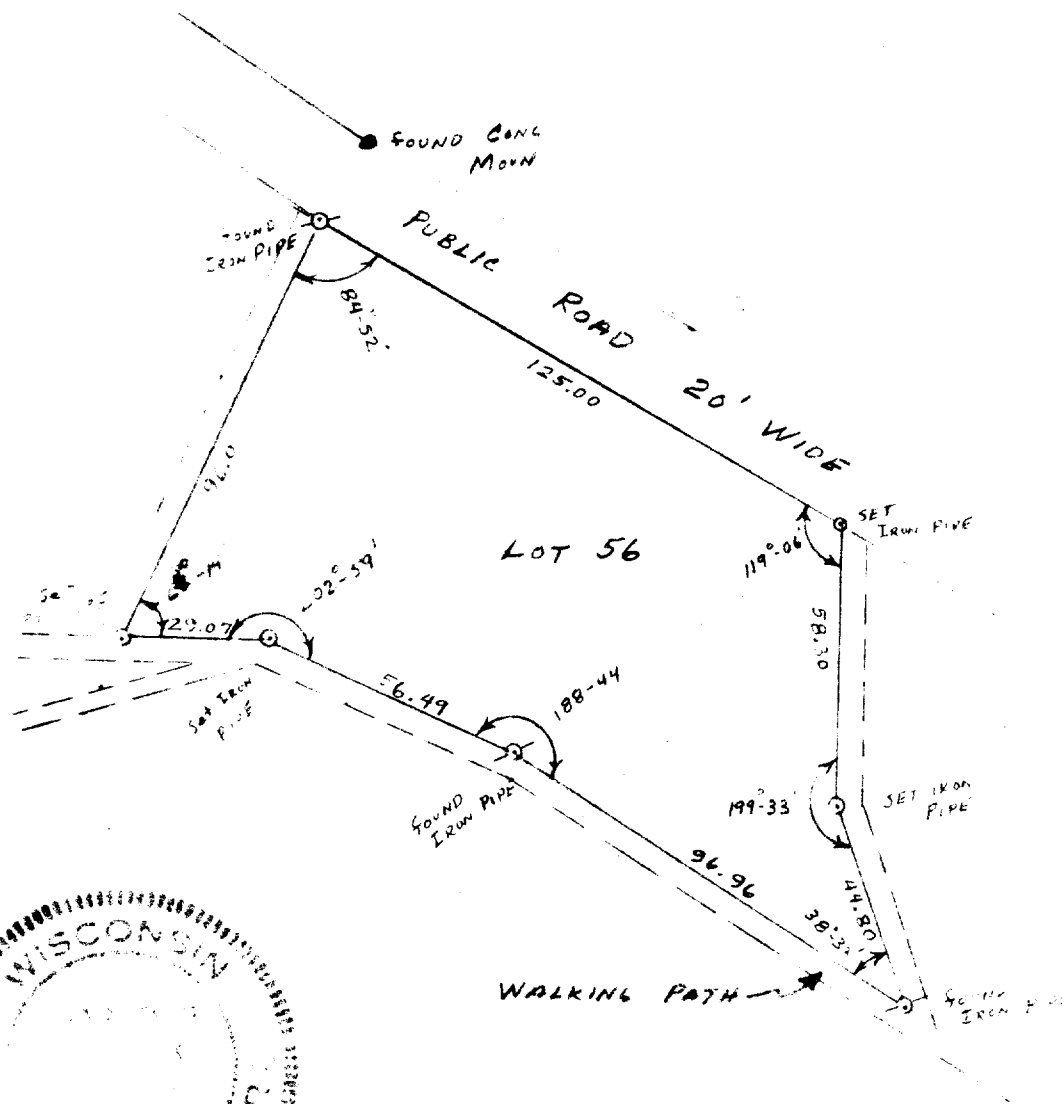

SCALE 1"=40'

NOTE: PLANT GATE OUT
WALKING PATH IN
LOT LINE. GATE
SHOULD LOT LINE
AS PATH ENDS
THIS PLACE

! HEREBY CERTIFY THAT WE HAVE SURVEYED THE LANDS DESCRIBED ABOVE ACCORDING TO OFFICIAL RECORDS AND THAT THE PLAT DRAWN HEREON IS A CORRECT REPRESENTATION OF SAID SURVEY.

WIS. REG. LAND SURVEYOR

DATE _____

4/15/70

JOB NO.

100

36-55