


PLAT OF SURVEY

DATE: 11-24-1999


ORDERED BY: KEEFE REAL ESTATE INC
751 GENEVA PARKWAY
LAKE GENEVA, WI 53147

PATHFINDER SURVEYING
FORMERLY KOLB LAND CONSULTING
929 WILLIAMS STREET LAKE GENEVA, WI. 53147
(414) 248-3697

DESCRIPTION: LOT 5, BLOCK 2 OF BROOKWOOD SUBDIVISON T1N, R17E, VILLAGE
OF FONTANA-ON-GENEVA-LAKE, WALWORTH COUNTY, WISCONSIN.

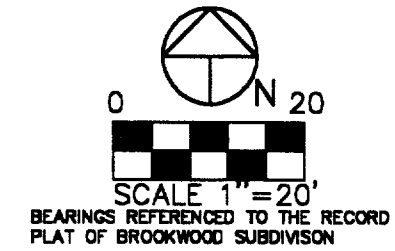


C.L. LAKELAND DRIVE (66') WIDE

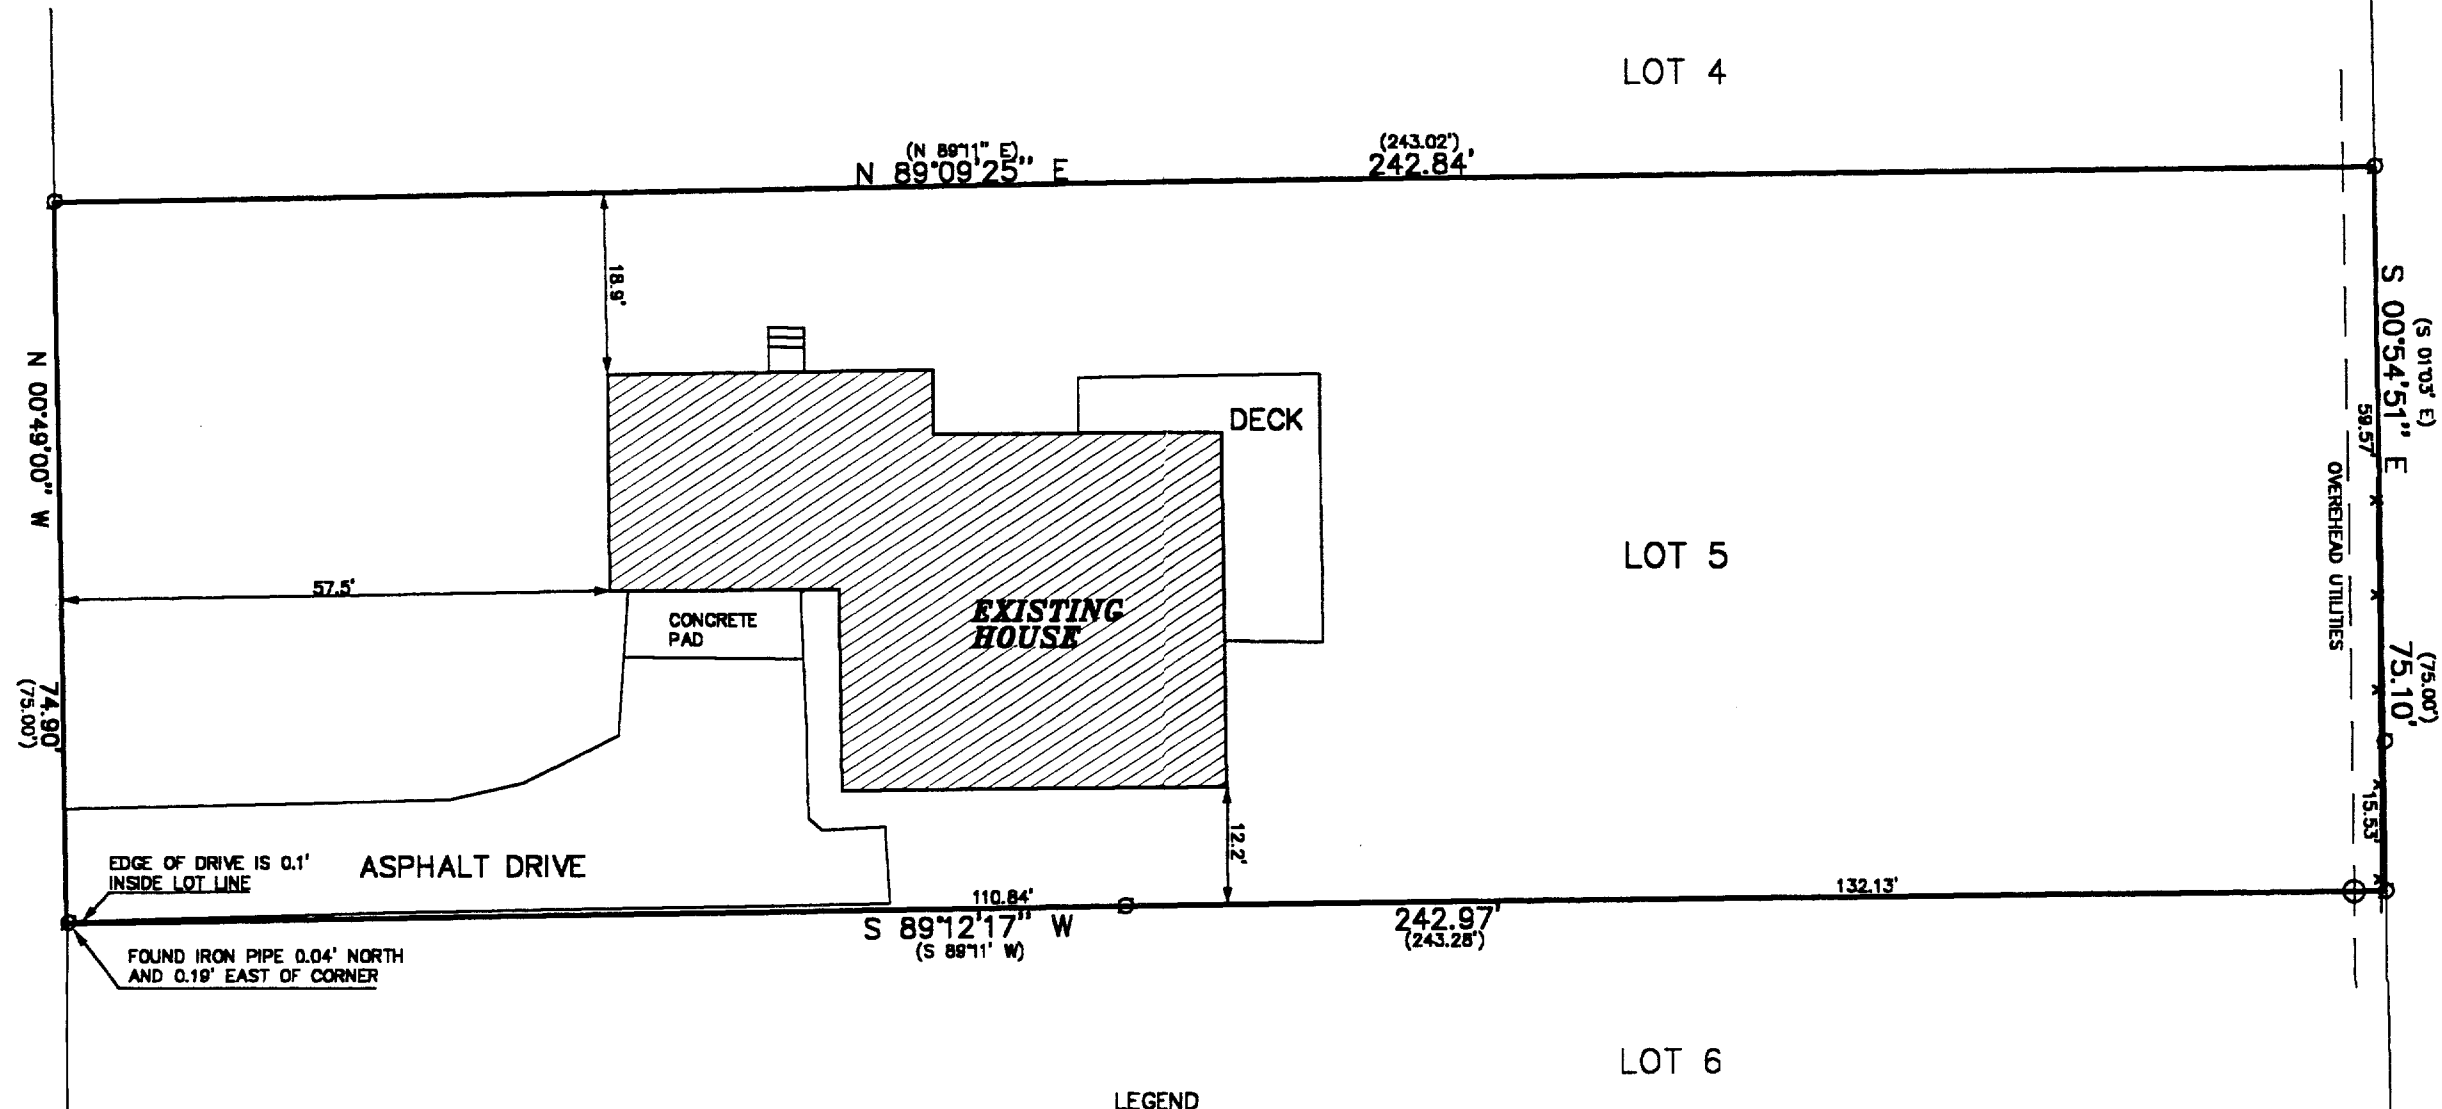

LEGEND


- FOUND IRON PIPE
- ⊙ POWER POLE
- (XXXX) RECORDED AS
- X— FENCE

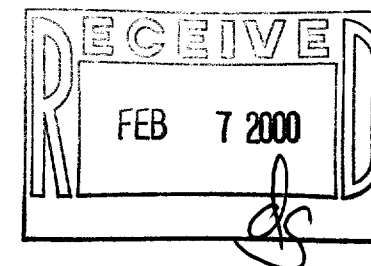

THE ABOVE MAP IS A TRUE REPRESENTATION THEREOF AND SHOWS THE SIZE AND LOCATION OF ALL THE PROPERTY, EXTERIOR BOUNDARIES, THE LOCATION OF ALL VISIBLE BOUNDARY FENCES, APPARENT EASEMENTS, ROADWAYS AND VISIBLE ENCROACHMENTS, IF ANY

THIS SURVEY IS MADE FOR THE USE OF THE PRESENT OWNERS OF THE PROPERTY, AND ALSO THOSE WHO PURCHASE, MORTGAGE OR GUARANTEE TITLE THERETO WITHIN ONE (1) YEAR FROM DATE HERETO.

John P. Krott
JOHN P. KROTT, R.L.S. 2258

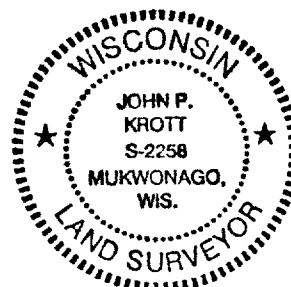

NOTE: THIS IS NOT A CERTIFIED COPY
UNLESS SEAL IS IN RED.
JOB NUMBER 99282 F- SBS 00018

005-1778

SBS-18