
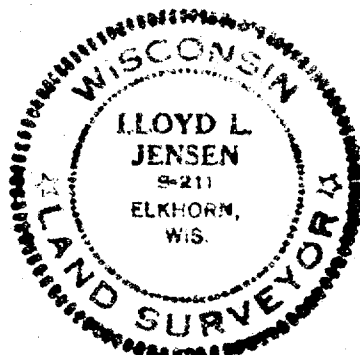


PLAT OF SURVEY

OF

LOT 46, REVISED PLAT OF THE
GARDENS, SECTION 11, T1N, R16E
VILLAGE OF FONTANA, WALWORTH
COUNTY, WISCONSIN.

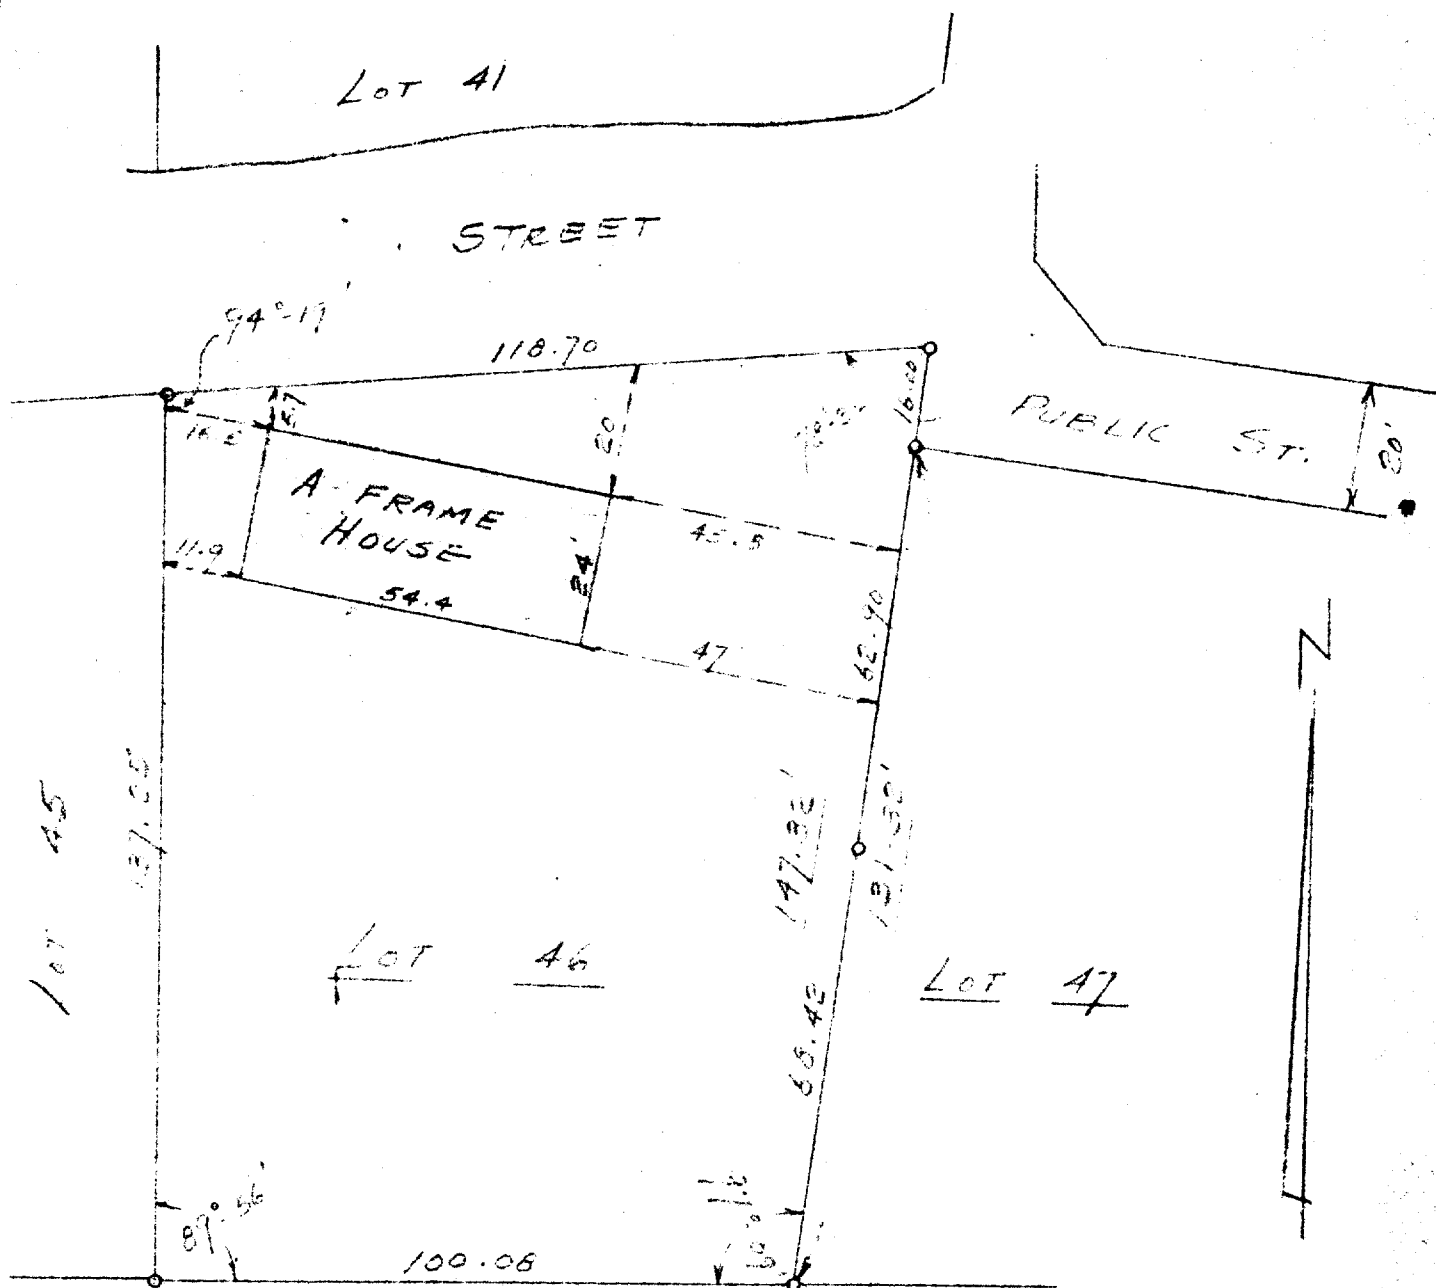

LEGEND

- — Iron Pipe
 - — Concrete Monument
- Scale 1" = 30'

SURVEY AND PLAT BY
JENSEN & JOHNSON
CIVIL ENGINEERS AND SURVEYORS
Elkhorn, Wisconsin

WE CERTIFY: That we have surveyed the above described property and that the plat shown hereon is an accurate survey and a true representation thereof and correctly shows the exterior boundary lines and all divisions of said property, and all buildings located thereon.

Date Nov. 5, 1964

Lloyd L. Jensen
LLOYD L. JENSEN, Partner

Wisconsin Registered Land Surveyor, No. S-211

SG-47