
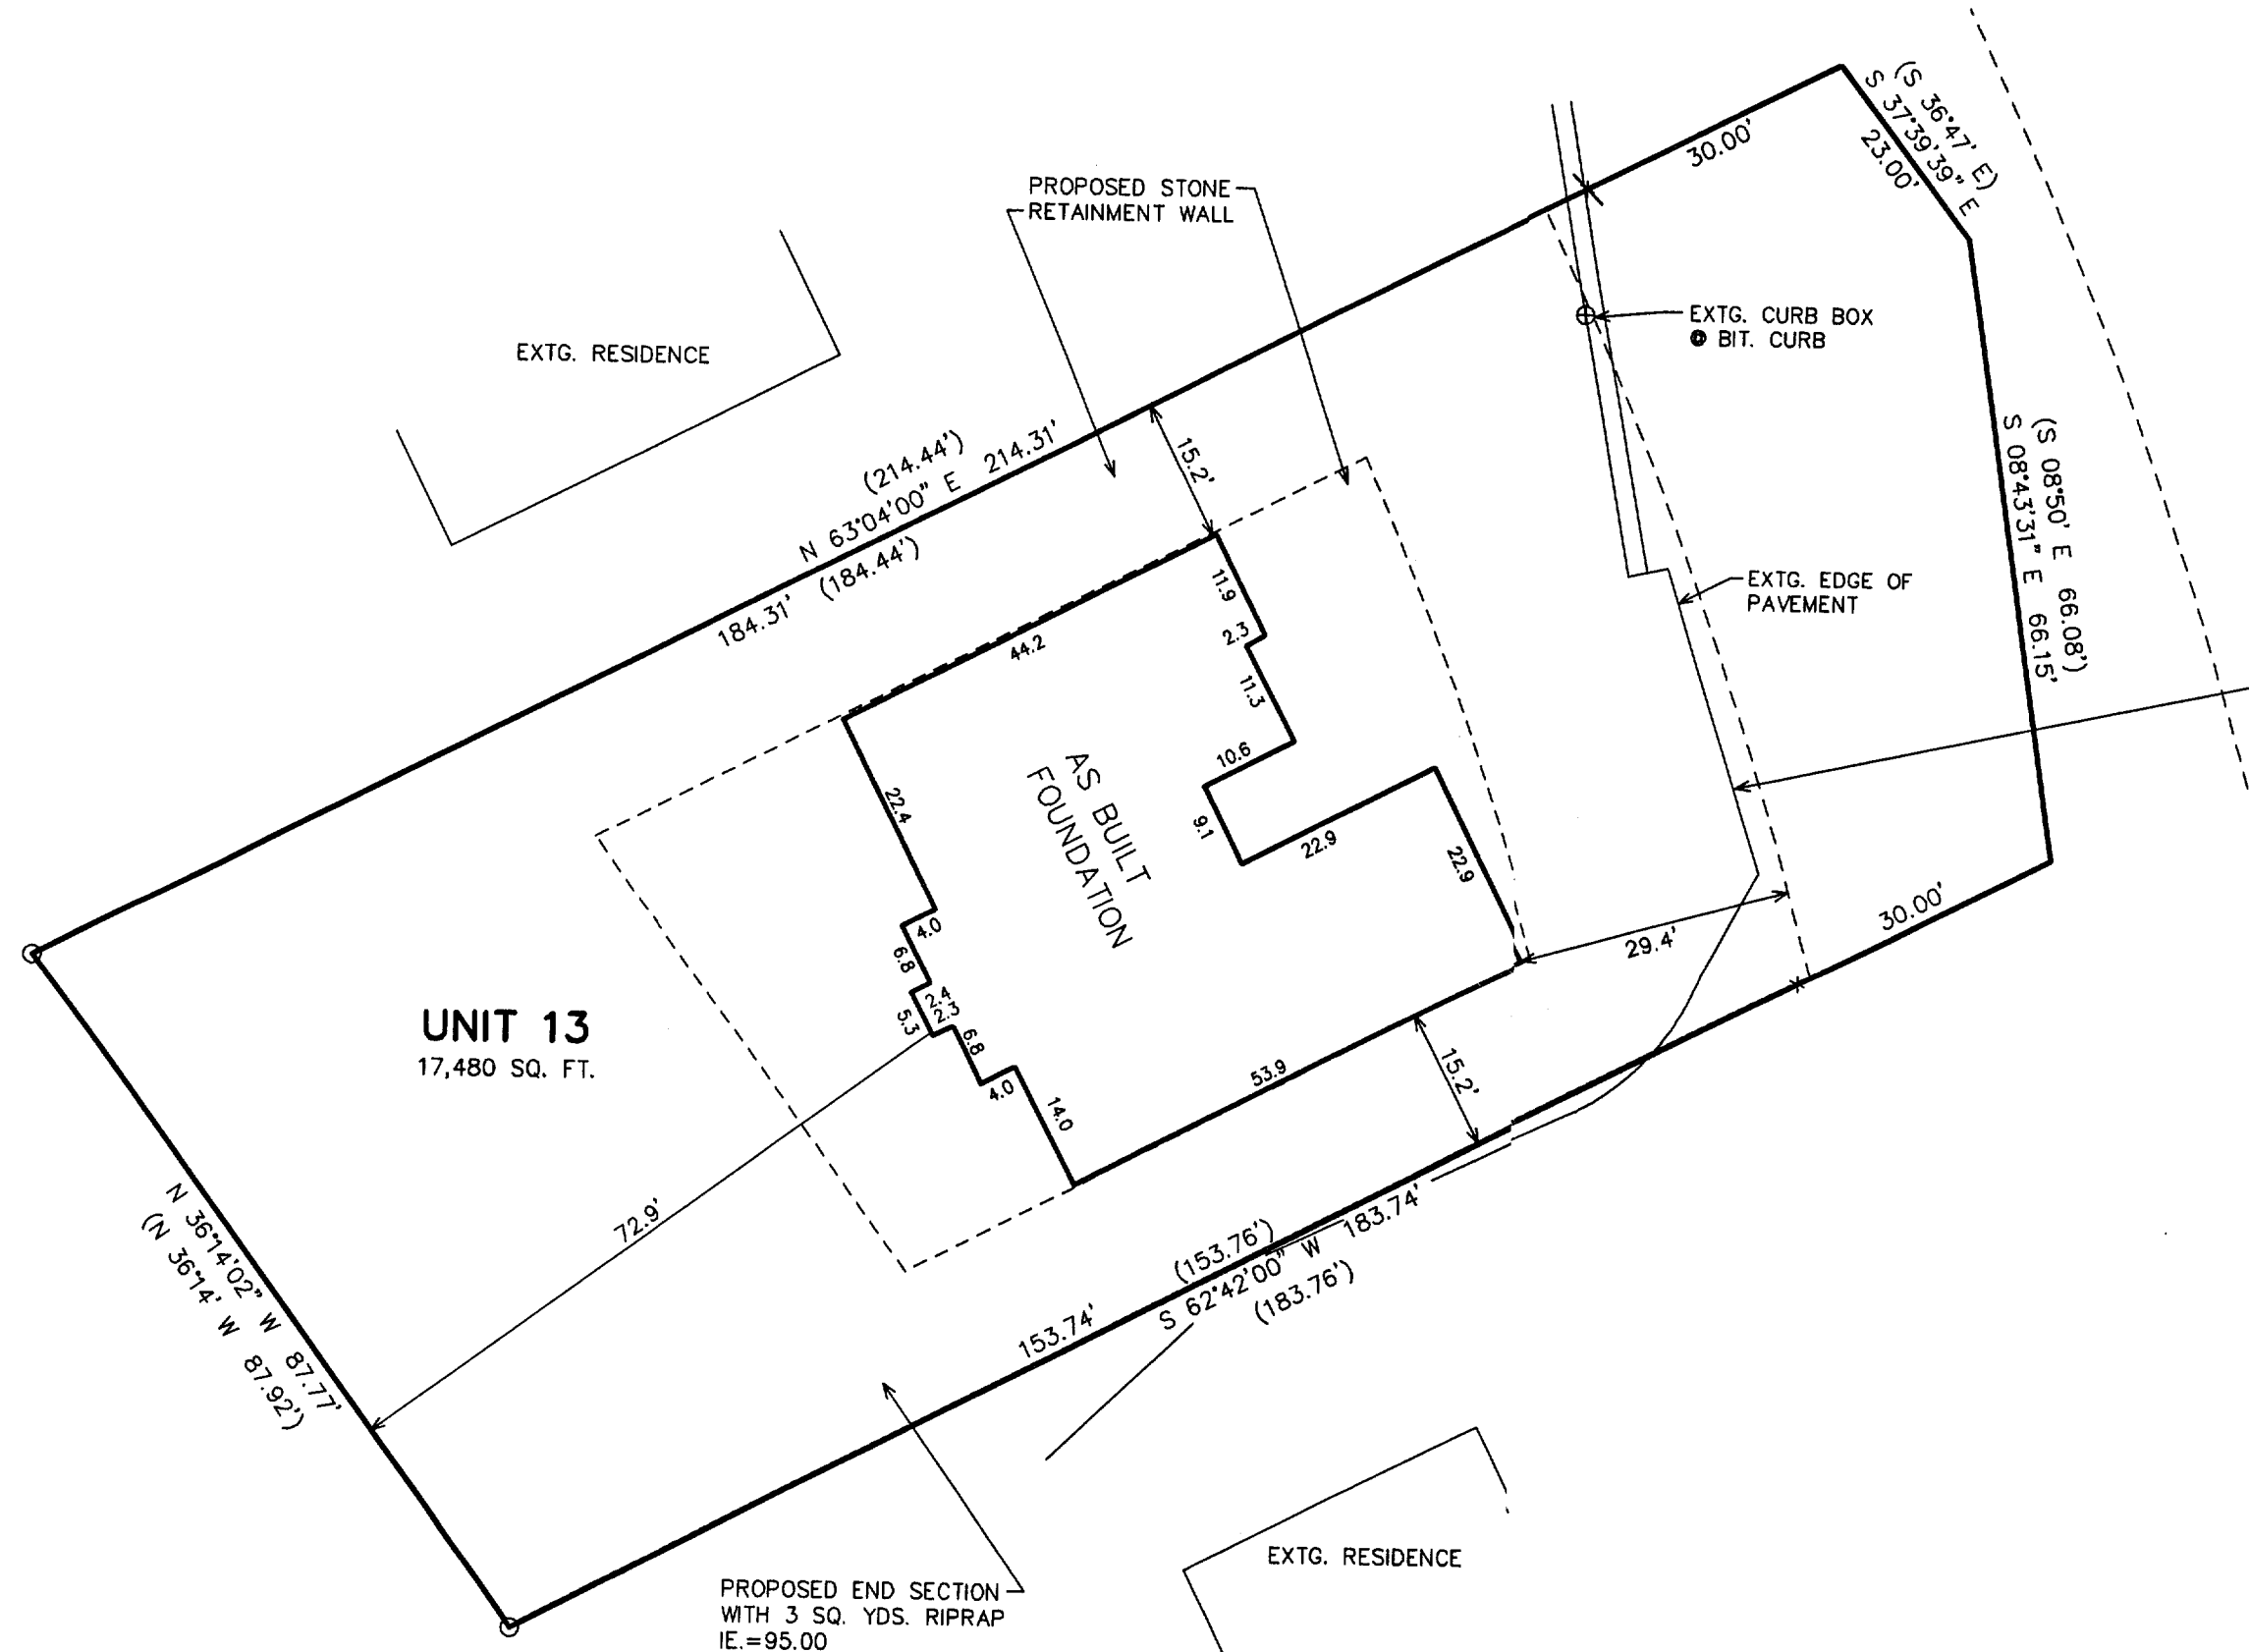



SITE, GRADING, DRAINAGE, & EROSION CONTROL PLAN

UNIT 13 OF ABBEY SPRINGS

A PARCEL OF LAND LOCATED IN THE SOUTH 1/2 OF SECTION 13, TOWN 1 NORTH, RANGE 16 EAST, VILLAGE OF FONTANA-ON-GENEVA LAKE, WALWORTH COUNTY, WISCONSIN

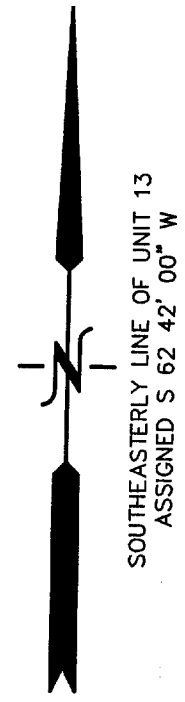



- LEGEND
- = FOUND IRON PIPE STAKE
 - * = FOUND "PK" NAIL IN PAVEMENT
 - ✱ = SET "PK" NAIL IN PAVEMENT
 - (XXX) = "RECORDED AS"
 - = = EXISTING CONTOURS
 - = = PROPOSED CONTOURS
 - B.E.=XXX.X = PROPOSED BASEMENT ELEVATION
 - T.F.=XXX.X = PROPOSED TOP OF FOUNDATION ELEVATION
 - F.F.=XXX.X = PROPOSED FINISHED FLOOR ELEVATION
 - G.E.=XXX.X = PROPOSED GARAGE ENTRY ELEVATION
 - = = EXISTING TREE TO BE REMOVED

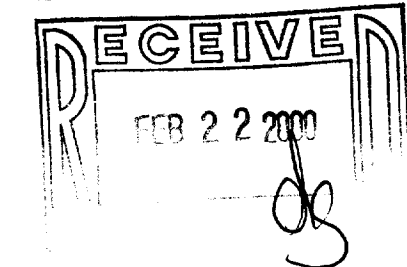

NOTE: COPIES OF THIS MAP TO WHICH THE FOLLOWING CERTIFICATE WILL APPLY SHOW SURVEYOR'S ORIGINAL SEAL AND SIGNATURE IN RED INK. COPIES BY ANY OTHER MEANS MAY HAVE ALTERATIONS WHICH DO NOT REPRESENT THE SURVEYOR'S WORK PRODUCT.

I HEREBY CERTIFY THAT THE ABOVE DESCRIBED PROPERTY HAS BEEN SURVEYED UNDER MY DIRECTION AND THAT THE ABOVE MAP IS A TRUE REPRESENTATION THEREOF AND SHOWS THE SIZE AND LOCATION OF THE PROPERTY AND ITS EXTERIOR BOUNDARIES. THIS SURVEY IS MADE FOR THE USE OF THE PRESENT OWNERS OF THE PROPERTY, AND ALSO THOSE WHO PURCHASE, MORTGAGE, OR GUARANTEE THE TITLE THERETO WITHIN ONE YEAR FROM THE DATE HEREOF.

DATED: 11-30-99
 PETER S. GORDON R.L.S. 2101
 2/10/2000
 To Show AS-BUILT Foundation

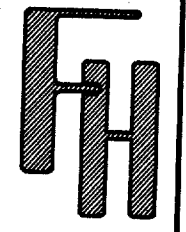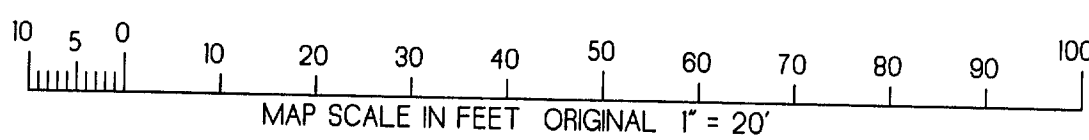

SITE, GRADING, DRAINAGE, & EROSION CONTROL PLAN
 VILLAGE OF FONTANA-ON-GENEVA LAKE
 WALWORTH COUNTY, WISCONSIN

WORK ORDERED BY -
 JOHN BAKKEN
 GENEVA HOMES, INC.
 P.O. BOX 877
 WILLIAMS BAY, WI. 53191

FARRIS, HANSEN & ASSOCIATES, INC.
 ENGINEERING - ARCHITECTURE - SURVEYING
 7 RIDGWAY COURT P.O. BOX 437
 ELKHORN, WISCONSIN 53121
 OFFICE: (262) 723-2098 FAX: (262) 723-5886

REVISIONS
 12/6/99
 ADD RET. WALL
 ADJ. CONTOURS

PROJECT NO.
 5447
 DATE:
 11/30/99
 SHEET NO.
 1 OF 1