


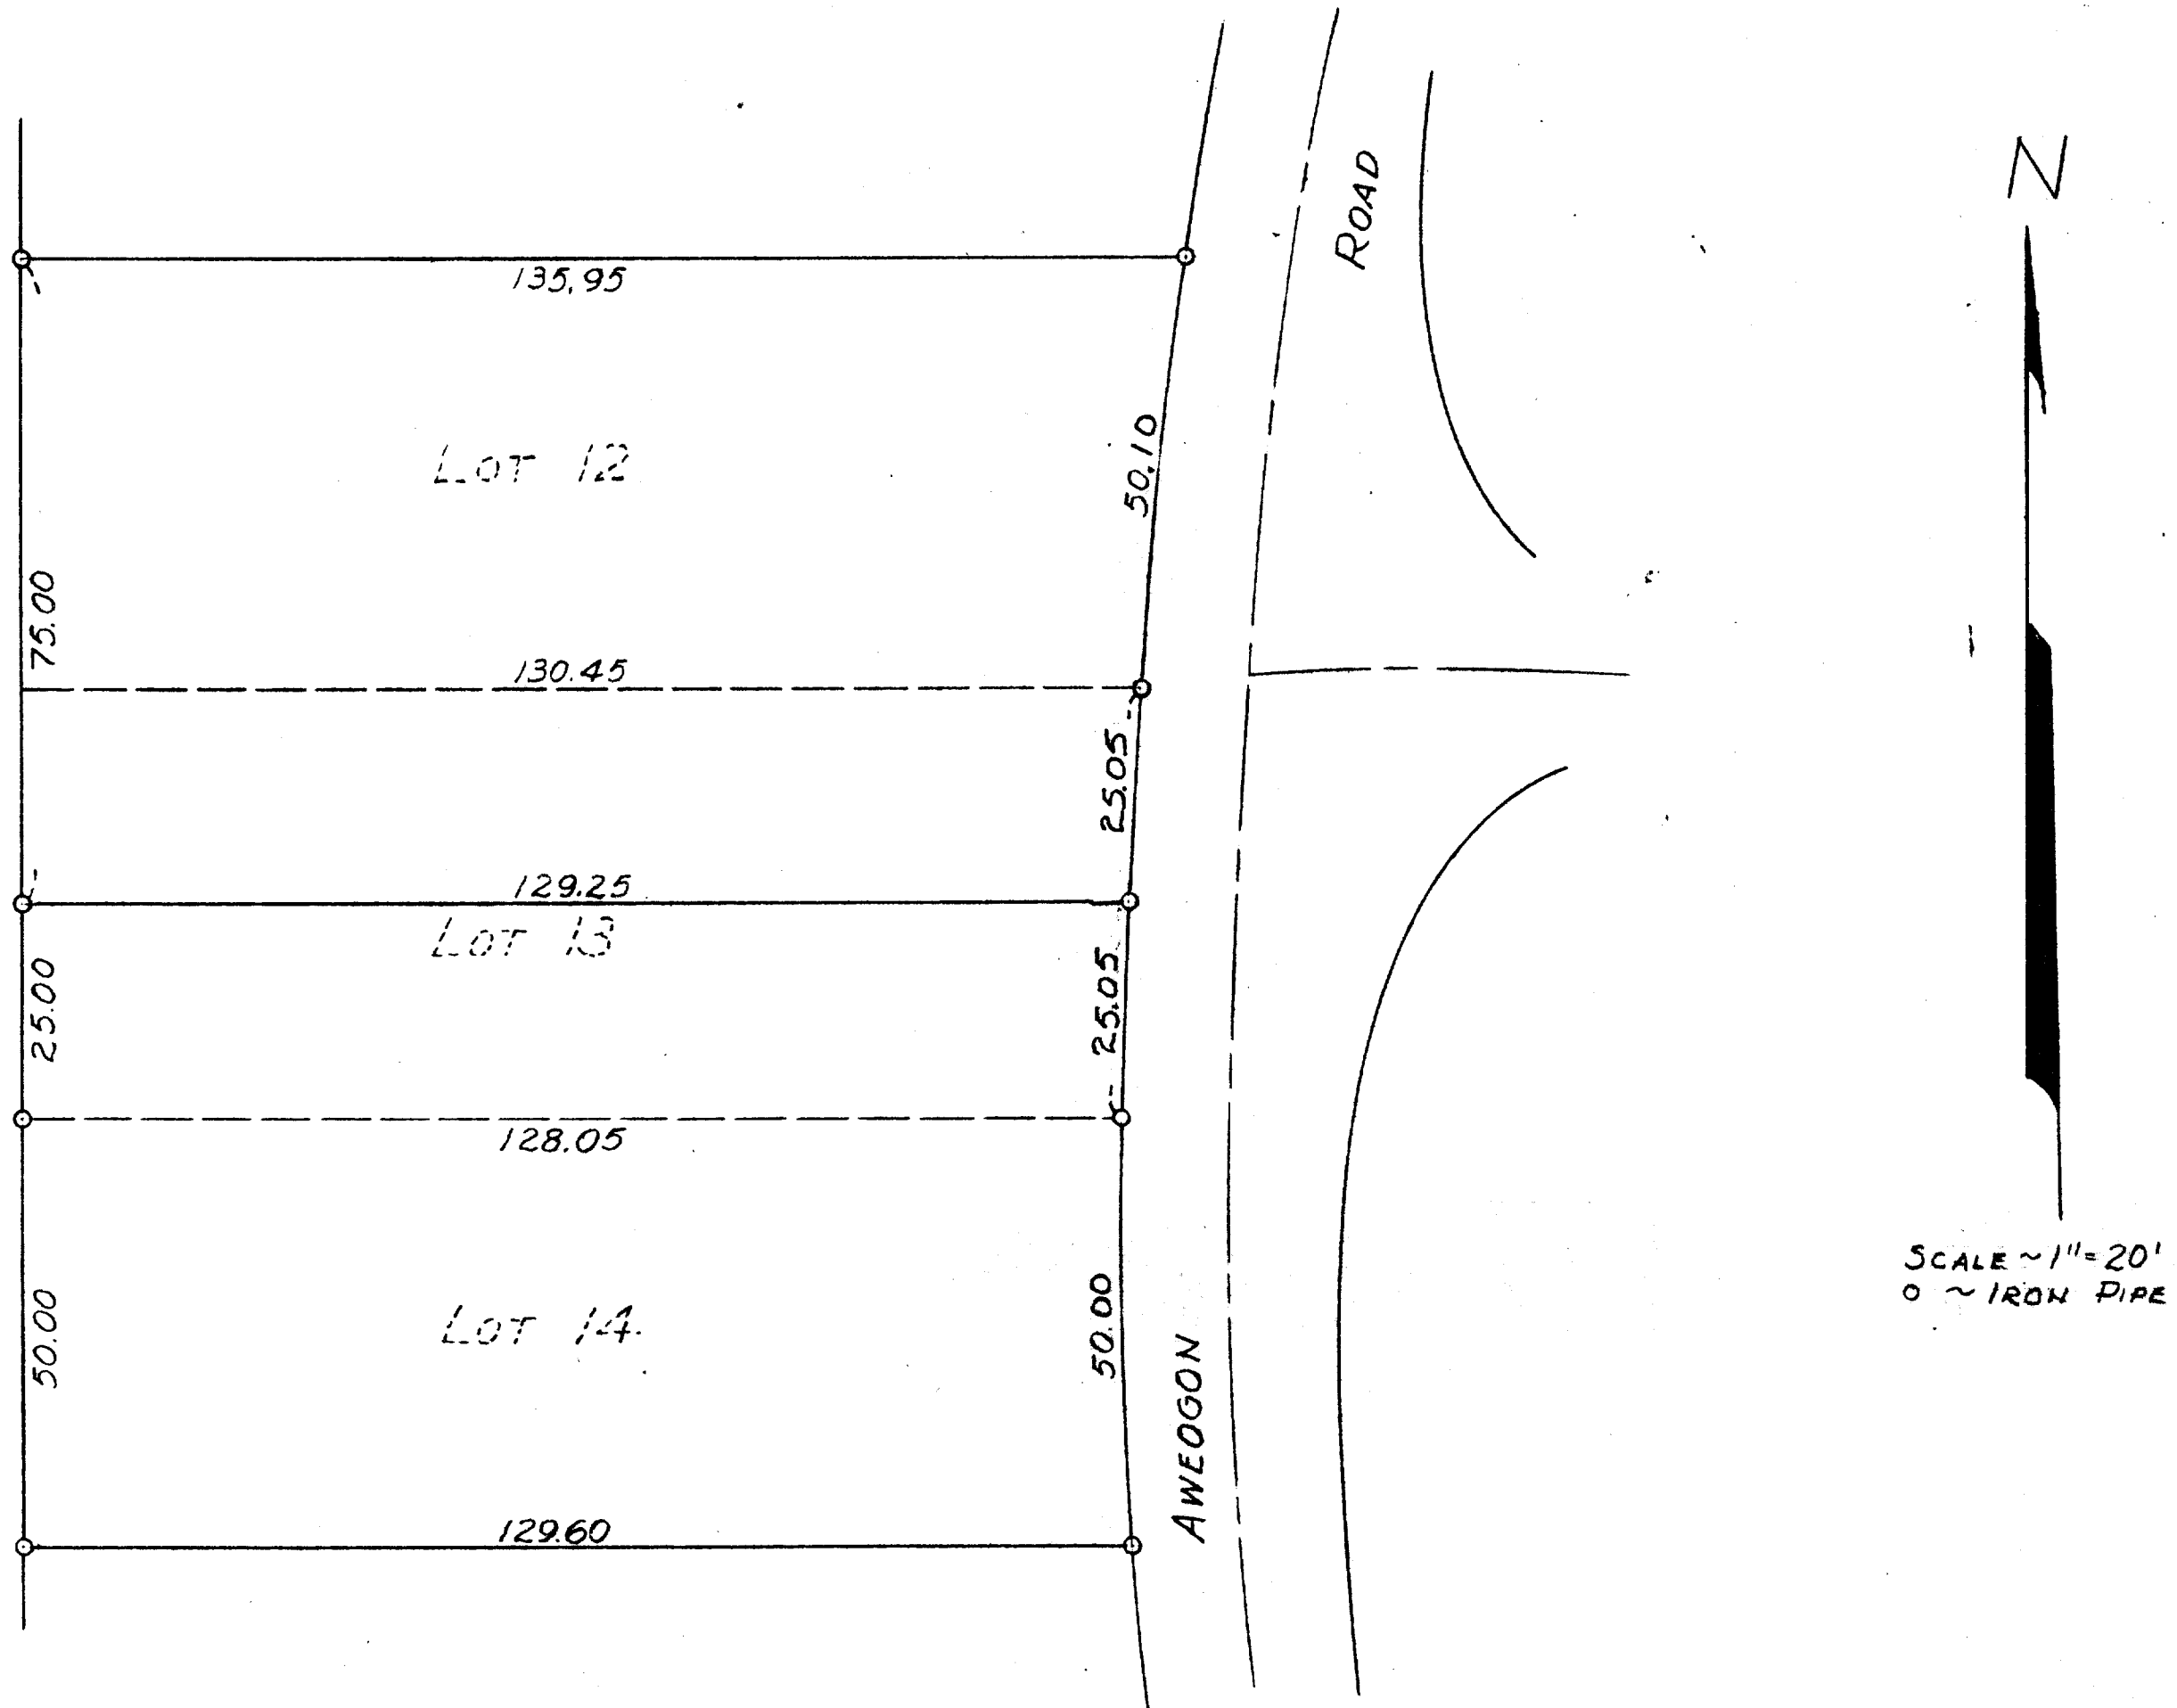

PLAT OF SURVEY OF LOTS 12, 13, AND 14, BLOCK 6, INDIAN HILLS, A SUBDIVISION
 LOCATED IN THE VILLAGE OF FONTANA, WALWORTH COUNTY, WISCONSIN
 JULY 23, 1958

SIHR-11

George T. Dunham
 GEORGE T. DUNHAM, SURVEYOR
 DELAVAN, WISCONSIN

5-18