



PLAT OF SURVEY

LOT 36 AND 37 OF GLENWOOD TERRACE
SUBDIVISION, LOCATED IN THE NORTH
1/2 OF THE NORTHEAST 1/4 OF THE
NORTHEAST 1/4 OF SECTION 23, TOWN
1 NORTH, RANGE 16 EAST, VILLAGE
OF FONTANA, WALWORTH COUNTY,
WISCONSIN.

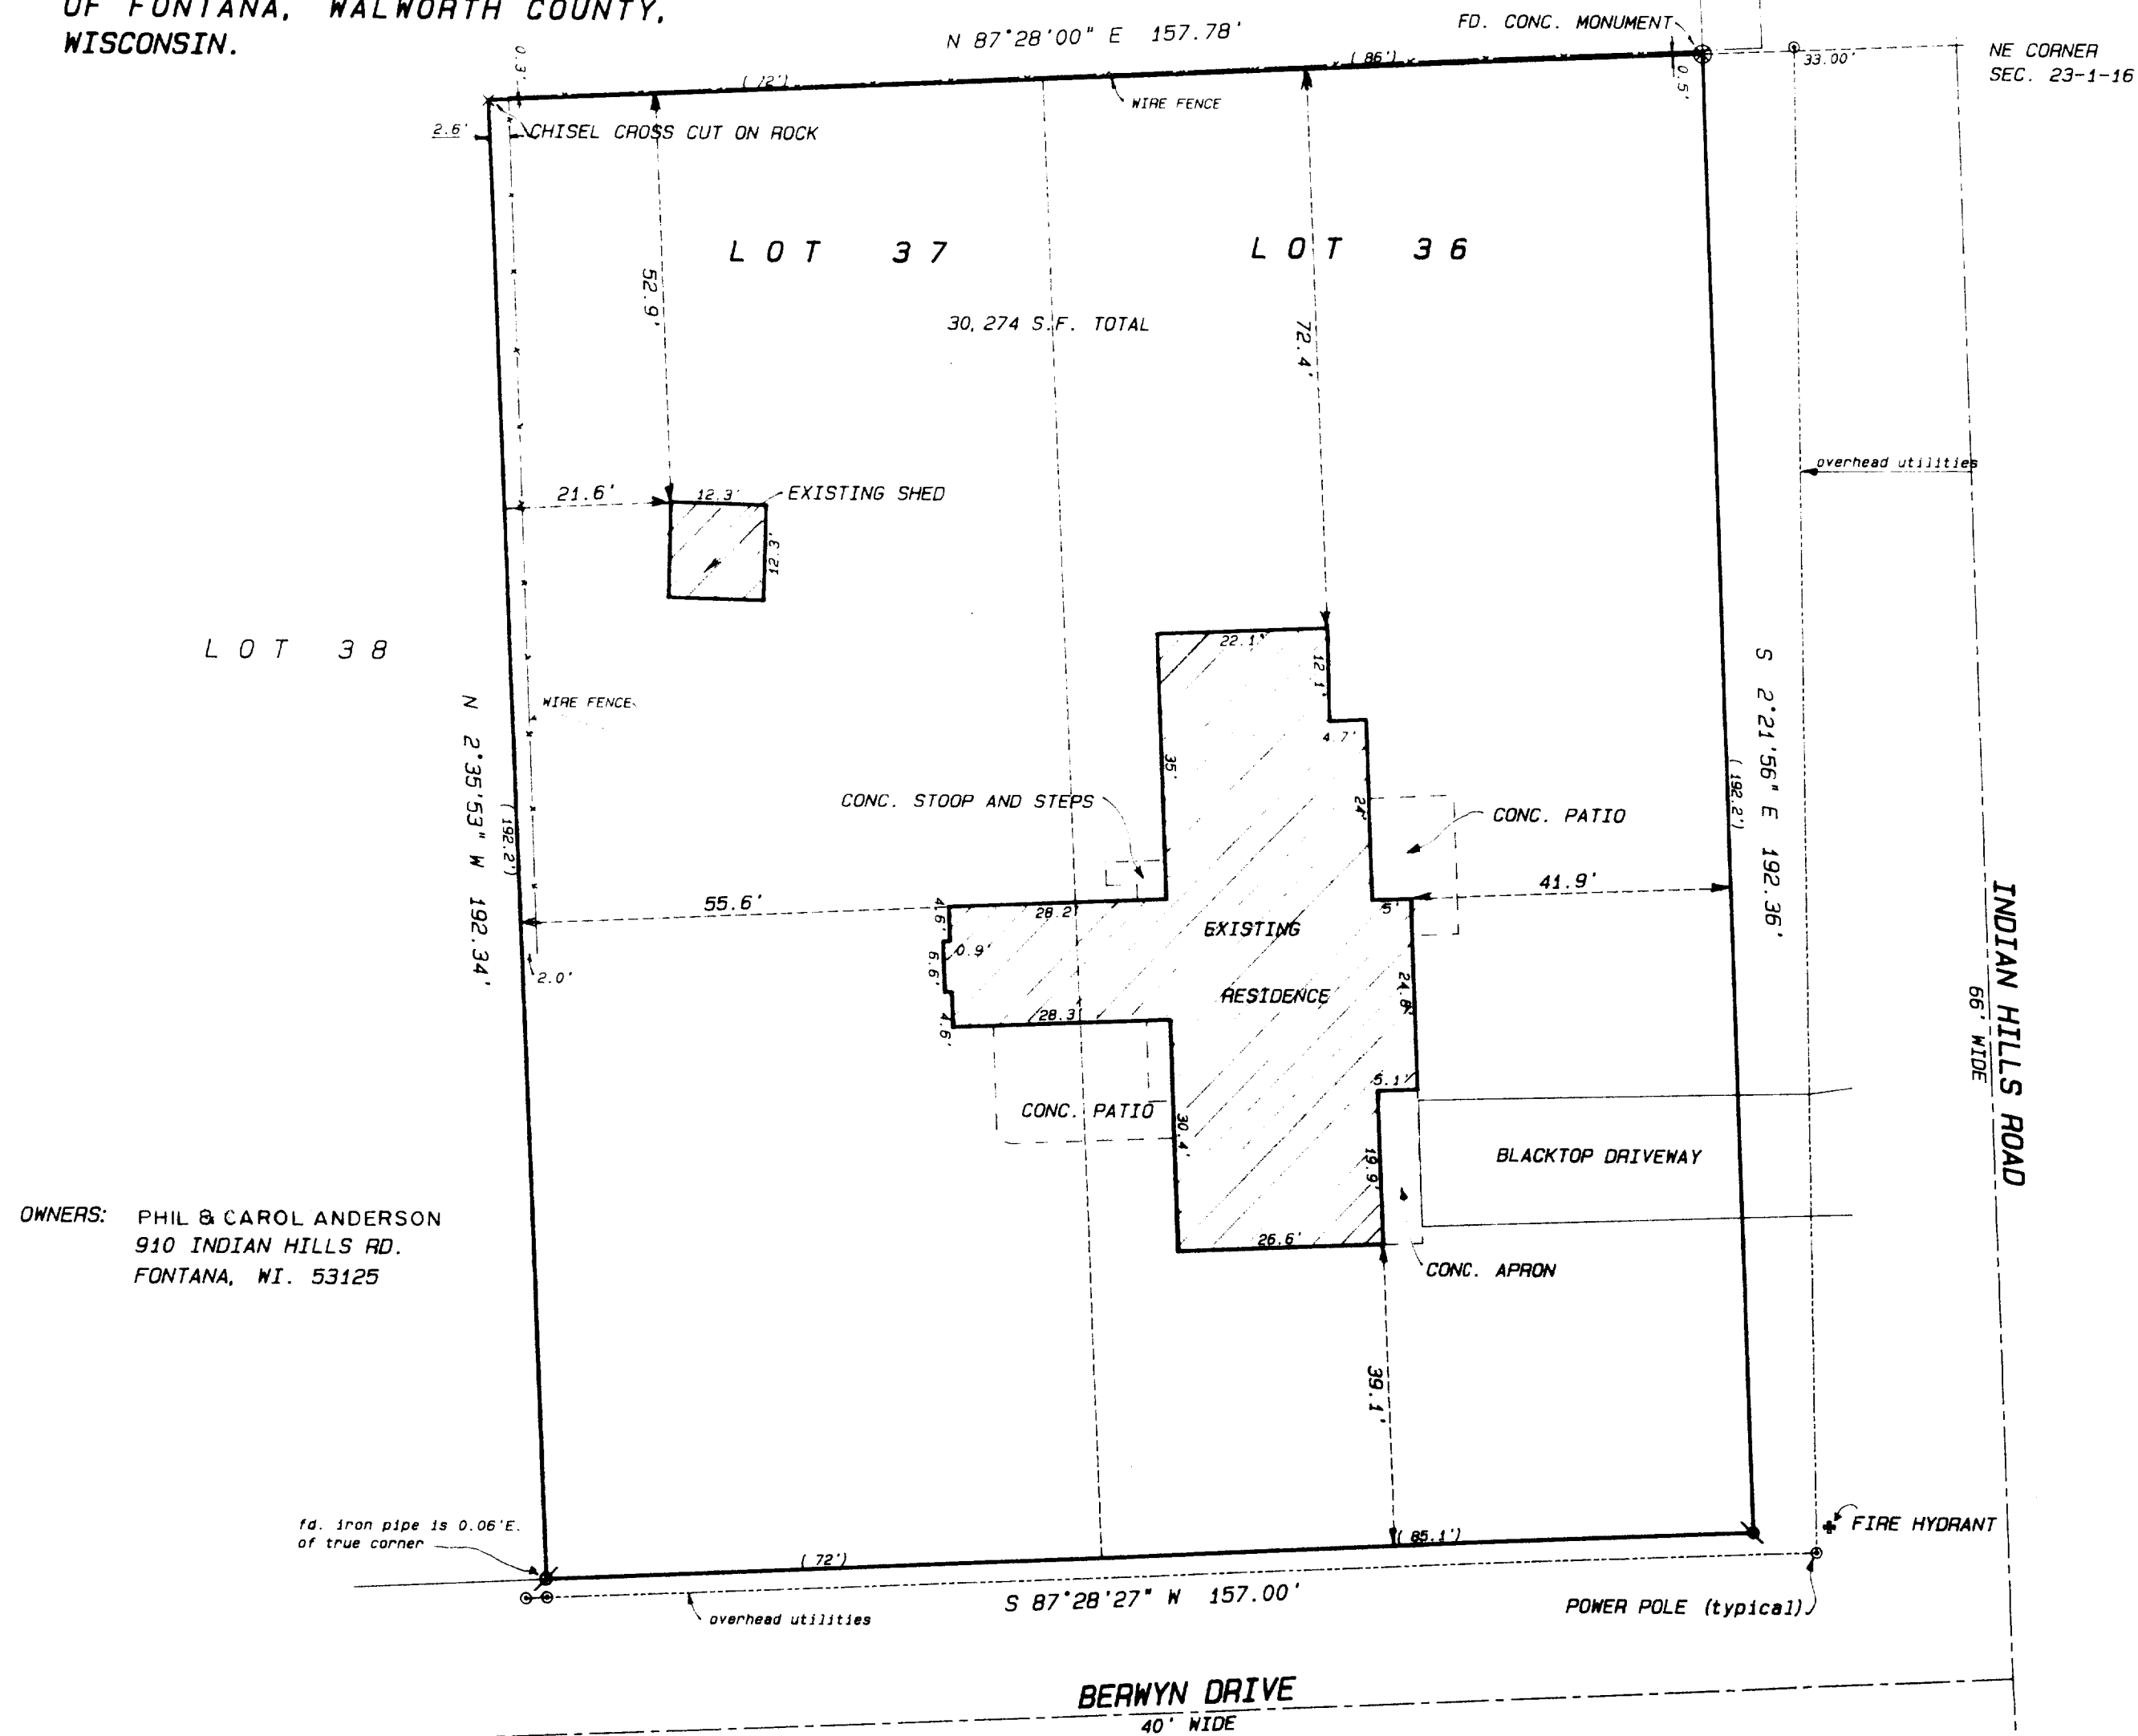


OWNERS: PHIL & CAROL ANDERSON
910 INDIAN HILLS RD.
FONTANA, WI. 53125

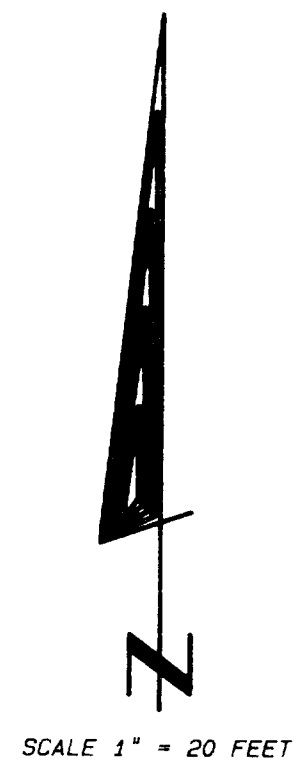

Legend

- FOUND IRON PIPE
- FOUND IRON ROD
- FOUND BRASS CAPPED MONUMENT
- FOUND CONCRETE MONUMENT
- CHISEL CUT IN CONCRETE
- SET IRON ROD, 24" LONG, WEIGHING 1.5 LBS./LINEAL FT., 3/4" DIA.
- SET IRON ROD, 30" LONG, WEIGHING 4.5 LBS./LINEAL FT., 1-11/16" DIA.
- RECORDED AS DIMENSION
- EXISTING FENCE

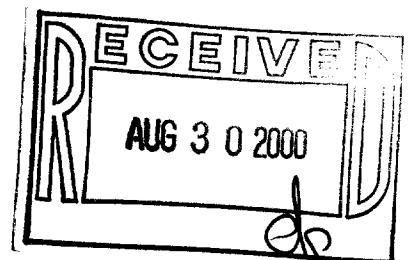

SCALE: 1" = 20 FEET



"I hereby certify that the above described property has been surveyed by me or under my direction and that the above map is a true representation thereof and shows the size and location of the property, its exterior boundaries, the location of all visible structures and dimensions of all principal buildings thereon, boundary fences, apparent easements, roadways and visible encroachments, if any."
"This survey is made for the use of the present owners of the property, and also those who purchase, mortgage, or guarantee the title thereto within one year from date hereof."

Kenneth B. Abernathy, Jr.
KENNETH B. ABERNATHY, JR.
WISCONSIN REGISTERED LAND SURVEYOR,
S-1594
Date: 12-10-97 Job No. 97-1206

REVISED 7/10/00

SGT-12 005-1841