

ABERNATHY and ASSOCIATES

Kenneth B. Abernathy Jr.

Wisconsin Registered Land Surveyor S-1594

Rt. 3, Box 273
Elkhorn, Wisconsin 53121
Phone: (414) 723-4260 (office)
(414) 723-7209 (FAX)

PLAT OF SURVEY

Mesita Road

20' Wide

Lot 13 of Block 6 of Indian Hills 1st Addition Subdivision, located in part of the Southeast 1/4 of Section 14, Town 1 North, Range 16 East, Village of Fontana, County of Walworth, State of Wisconsin.

OWNERS: DANIEL AND MARY MAUS
539 MESITA
FONTANA, WI. 53125

Lot
12

Block

Lot
13

SPLIT RAIL FENCE

0.15 Acres $\pm$

BLACKTOP
DRIVEWAY

WOOD DECK
ABOVE


CONCRETE

Existing
Dwelling

WOOD
DECK

UPPER
DECK

East Line of Indian Hills 1st Addition Subdivision
BEARING BASIS THIS PLAT
S 2°43'00" E
126.98'
(127.00')

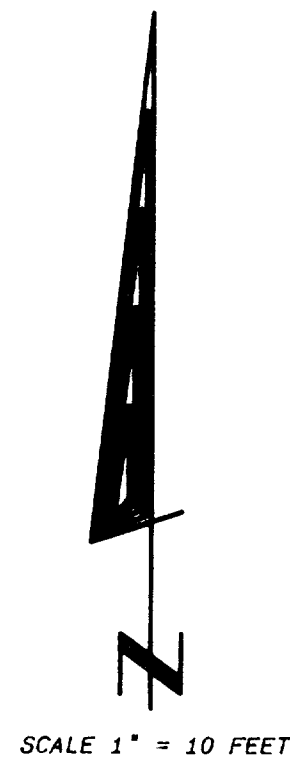

SCALE 1" = 10 FEET

Legend

- FOUND IRON PIPE
- FOUND IRON ROD
- FOUND BRASS CAPPED MONUMENT
- FOUND CONCRETE MONUMENT
- CHISEL CUT IN CONCRETE
- SET IRON ROD, 24" LONG, WEIGHING 1.5 LBS., LINEAL FT., 3/4" DIA.
- SET IRON ROD, 30" LONG, WEIGHING 4.5 LBS., LINEAL FT., 1 11/16" DIA.
- (xx) RECORDED AS DIMENSION
- EXISTING FENCE



SCALE: 1" = 10 FEET


"I hereby certify that the above described property has been surveyed by me or under my direction and that the above map is a true representation thereof and shows the size and location of the property, its exterior boundaries, the location of all visible structures and dimensions of all principal buildings thereon, boundary fences, apparent easements, roadways and visible encroachments, if any."

"This survey is made for the use of the present owners of the property, and also those who purchase, mortgage or guarantee the title thereto within one year from date hereof."

Kenneth B. Abernathy, Jr.

KENNETH B. ABERNATHY, JR.
WISCONSIN REGISTERED LAND SURVEYOR,
S-1594

Date: 9-27-00 Job No. 96704

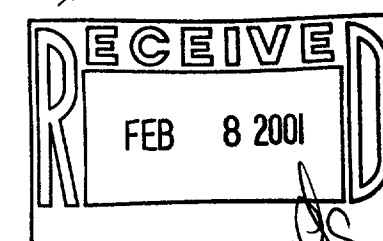

South Line of Indian Hills 1st Addition Subdivision

005-1872
SIHF-60A