


737 Upper Brookwood Drive

All that part of the SW $\frac{1}{4}$ of Sec. 18, T1N, R17E, Walworth County, Wisconsin, bounded and described as follows: Commencing at the SW corner of Brookwood Subdivision which point is S 0° 42' E 744.22 ft of the W $\frac{1}{4}$ Section corner of said Section 18 and run thence due East along the South line of said Subdivision 612.29 ft.; thence S 15° 28' E 161.60 ft. to the place of beginning of the parcel hereinafter described. Thence run S 10° 52' 30" W 331.99 ft; thence S 76° 26' 30" W 162.25 ft; thence N 62° 26' 30" W 154.02 ft; thence N 24° 28' 30" W 192.16 ft; thence N 69° 17' E 332.67 ft to the place of beginning, Village of Fontana-on-Geneva Lake, County of Walworth, Wisconsin.


○ = FOUND IRON PIPE STAKE
(XXX) = RECORDED AS

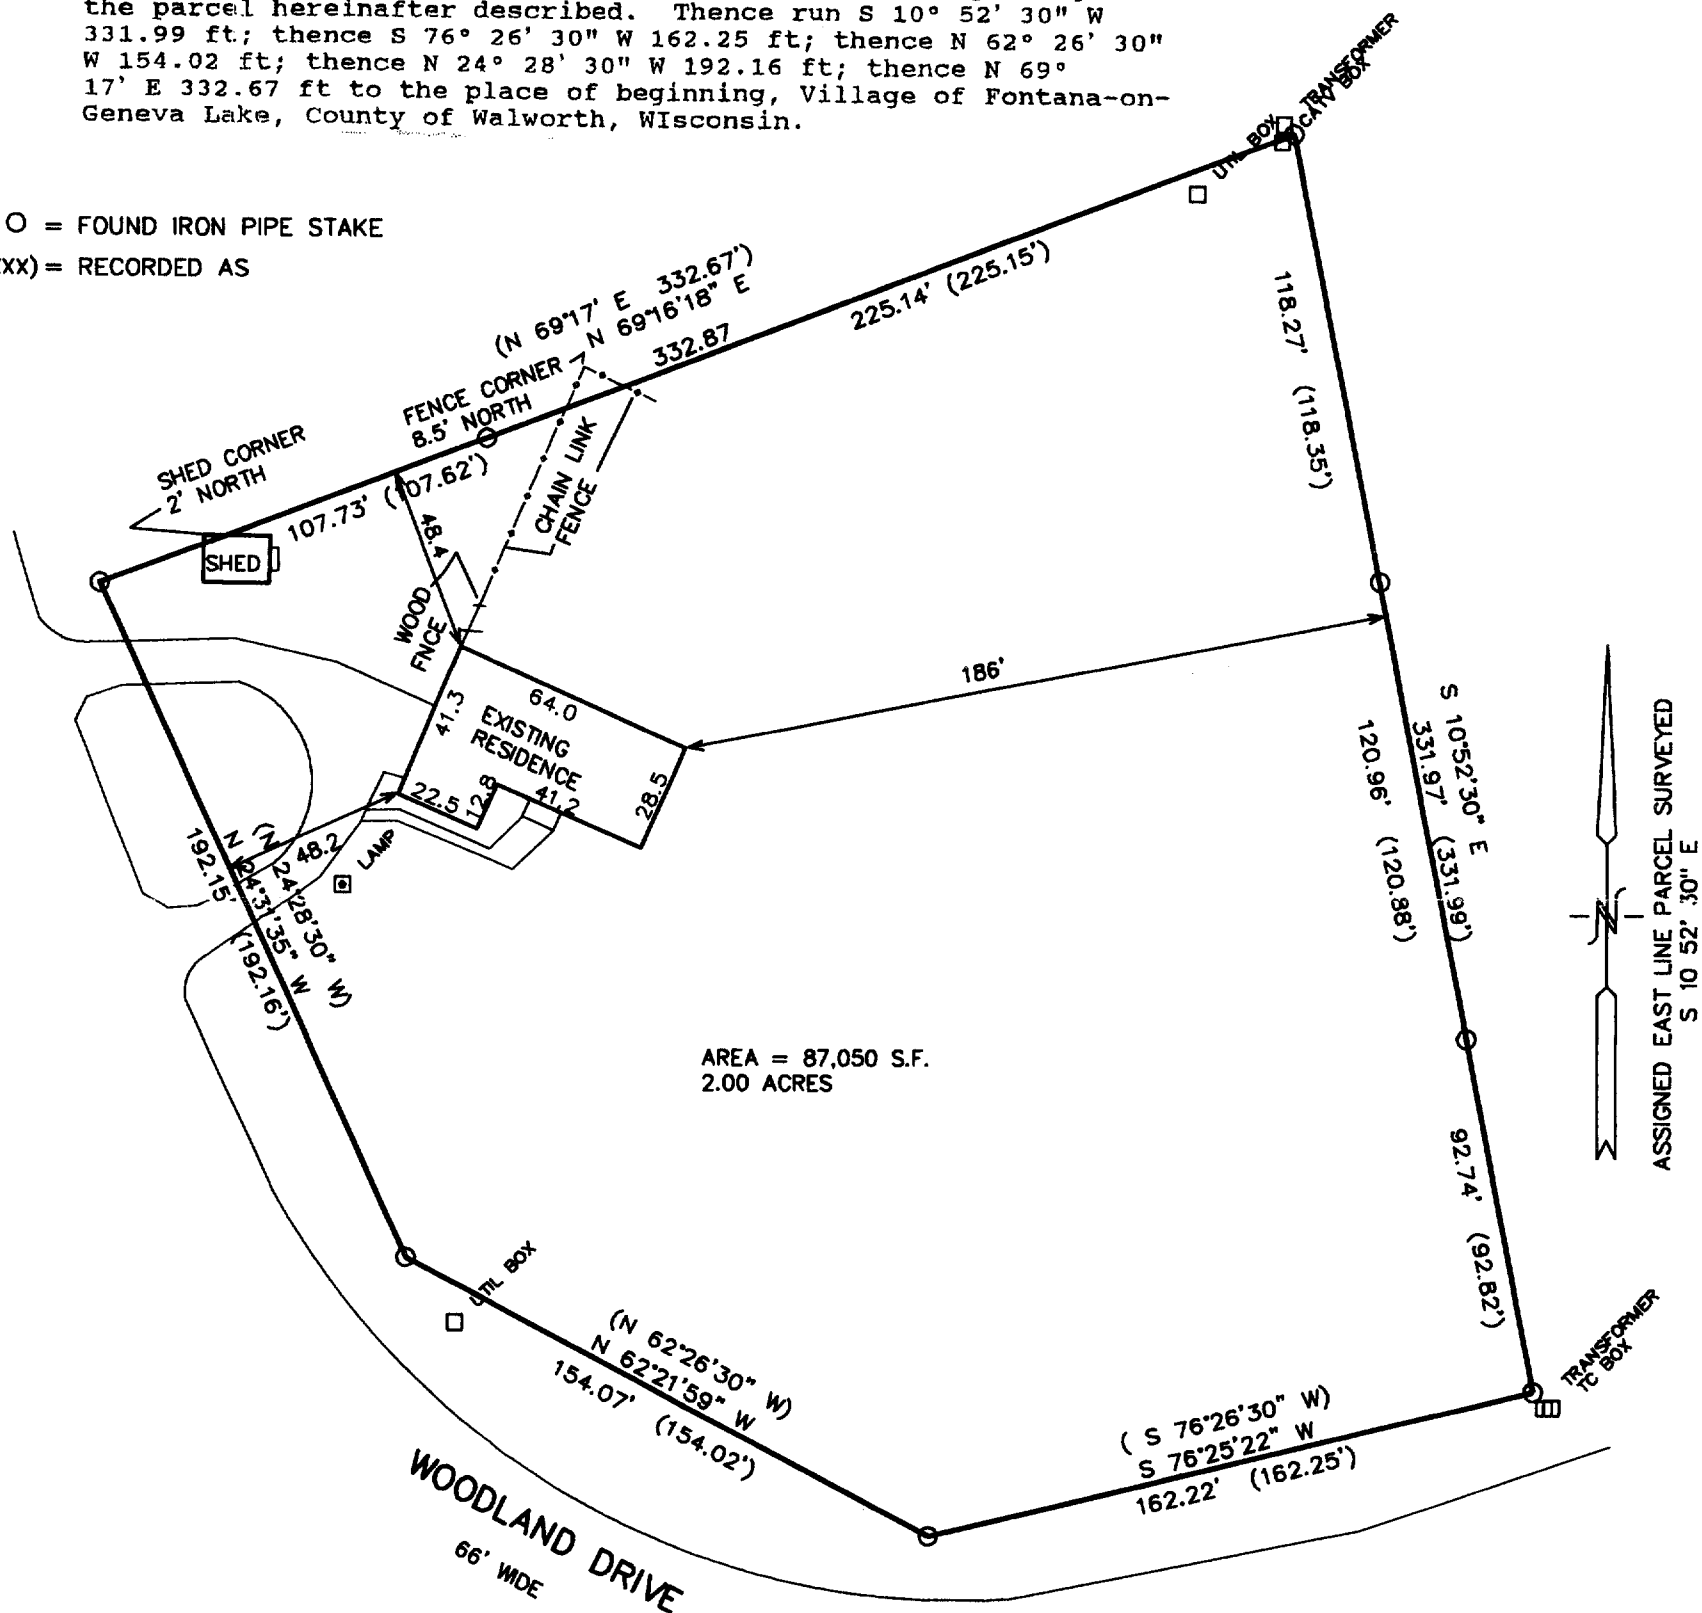

**AREA = 87,050 S.F.
2.00 ACRES**

ASSIGNED EAST LINE PARCEL SURVEYED
S 10 52' 30" E

- WORK ORDERED BY -
LYNN RICHTER
737 UPPER BROOKWOOD DRIVE
FONTANA, WI. 53125

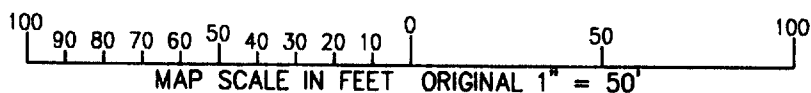


NOTE: COPIES OF THIS MAP TO WHICH THE FOLLOWING CERTIFICATE WILL APPLY SHOW SURVEYOR'S ORIGINAL SEAL AND SIGNATURE IN RED INK. COPIES BY ANY OTHER MEANS MAY HAVE ALTERATIONS WHICH DO NOT REPRESENT THE SURVEYOR'S WORK PRODUCT.

I HEREBY CERTIFY THAT THE ABOVE DESCRIBED PROPERTY HAS BEEN SURVEYED UNDER MY DIRECTION AND THAT THE ABOVE MAP IS A TRUE REPRESENTATION THEREOF AND SHOWS THE SIZE AND LOCATION OF THE PROPERTY AND ITS EXTERIOR BOUNDARIES. THIS SURVEY IS MADE FOR THE USE OF THE PRESENT OWNERS OF THE PROPERTY, AND ALSO THOSE WHO PURCHASE, MORTGAGE, OR GUARANTEE THE TITLE THERETO WITHIN ONE YEAR FROM THE DATE HEREOF.

DATED: 1-31-2001


PETER S. GORDON R.L.S. 2101

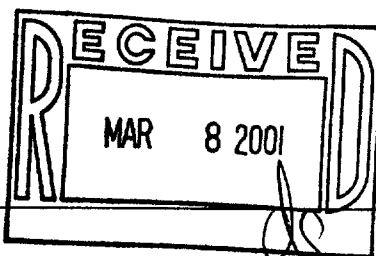

PROJECT 5738
DATE: 01-30-2001
SHEET 1 OF 1

SUP-1E

1005-1881

JAN 11 2011