




Notes: 1) This survey plat is not certified unless signed and sealed in red ink.
2) This survey is subject to Wisconsin lien laws. This Plat of Survey is the notice of intent to file lien. Lien waiver required.


Surveyed for: **Hugh Plunkett**
2500 West Golf Road
Hoffman Estates, Illinois. 60194

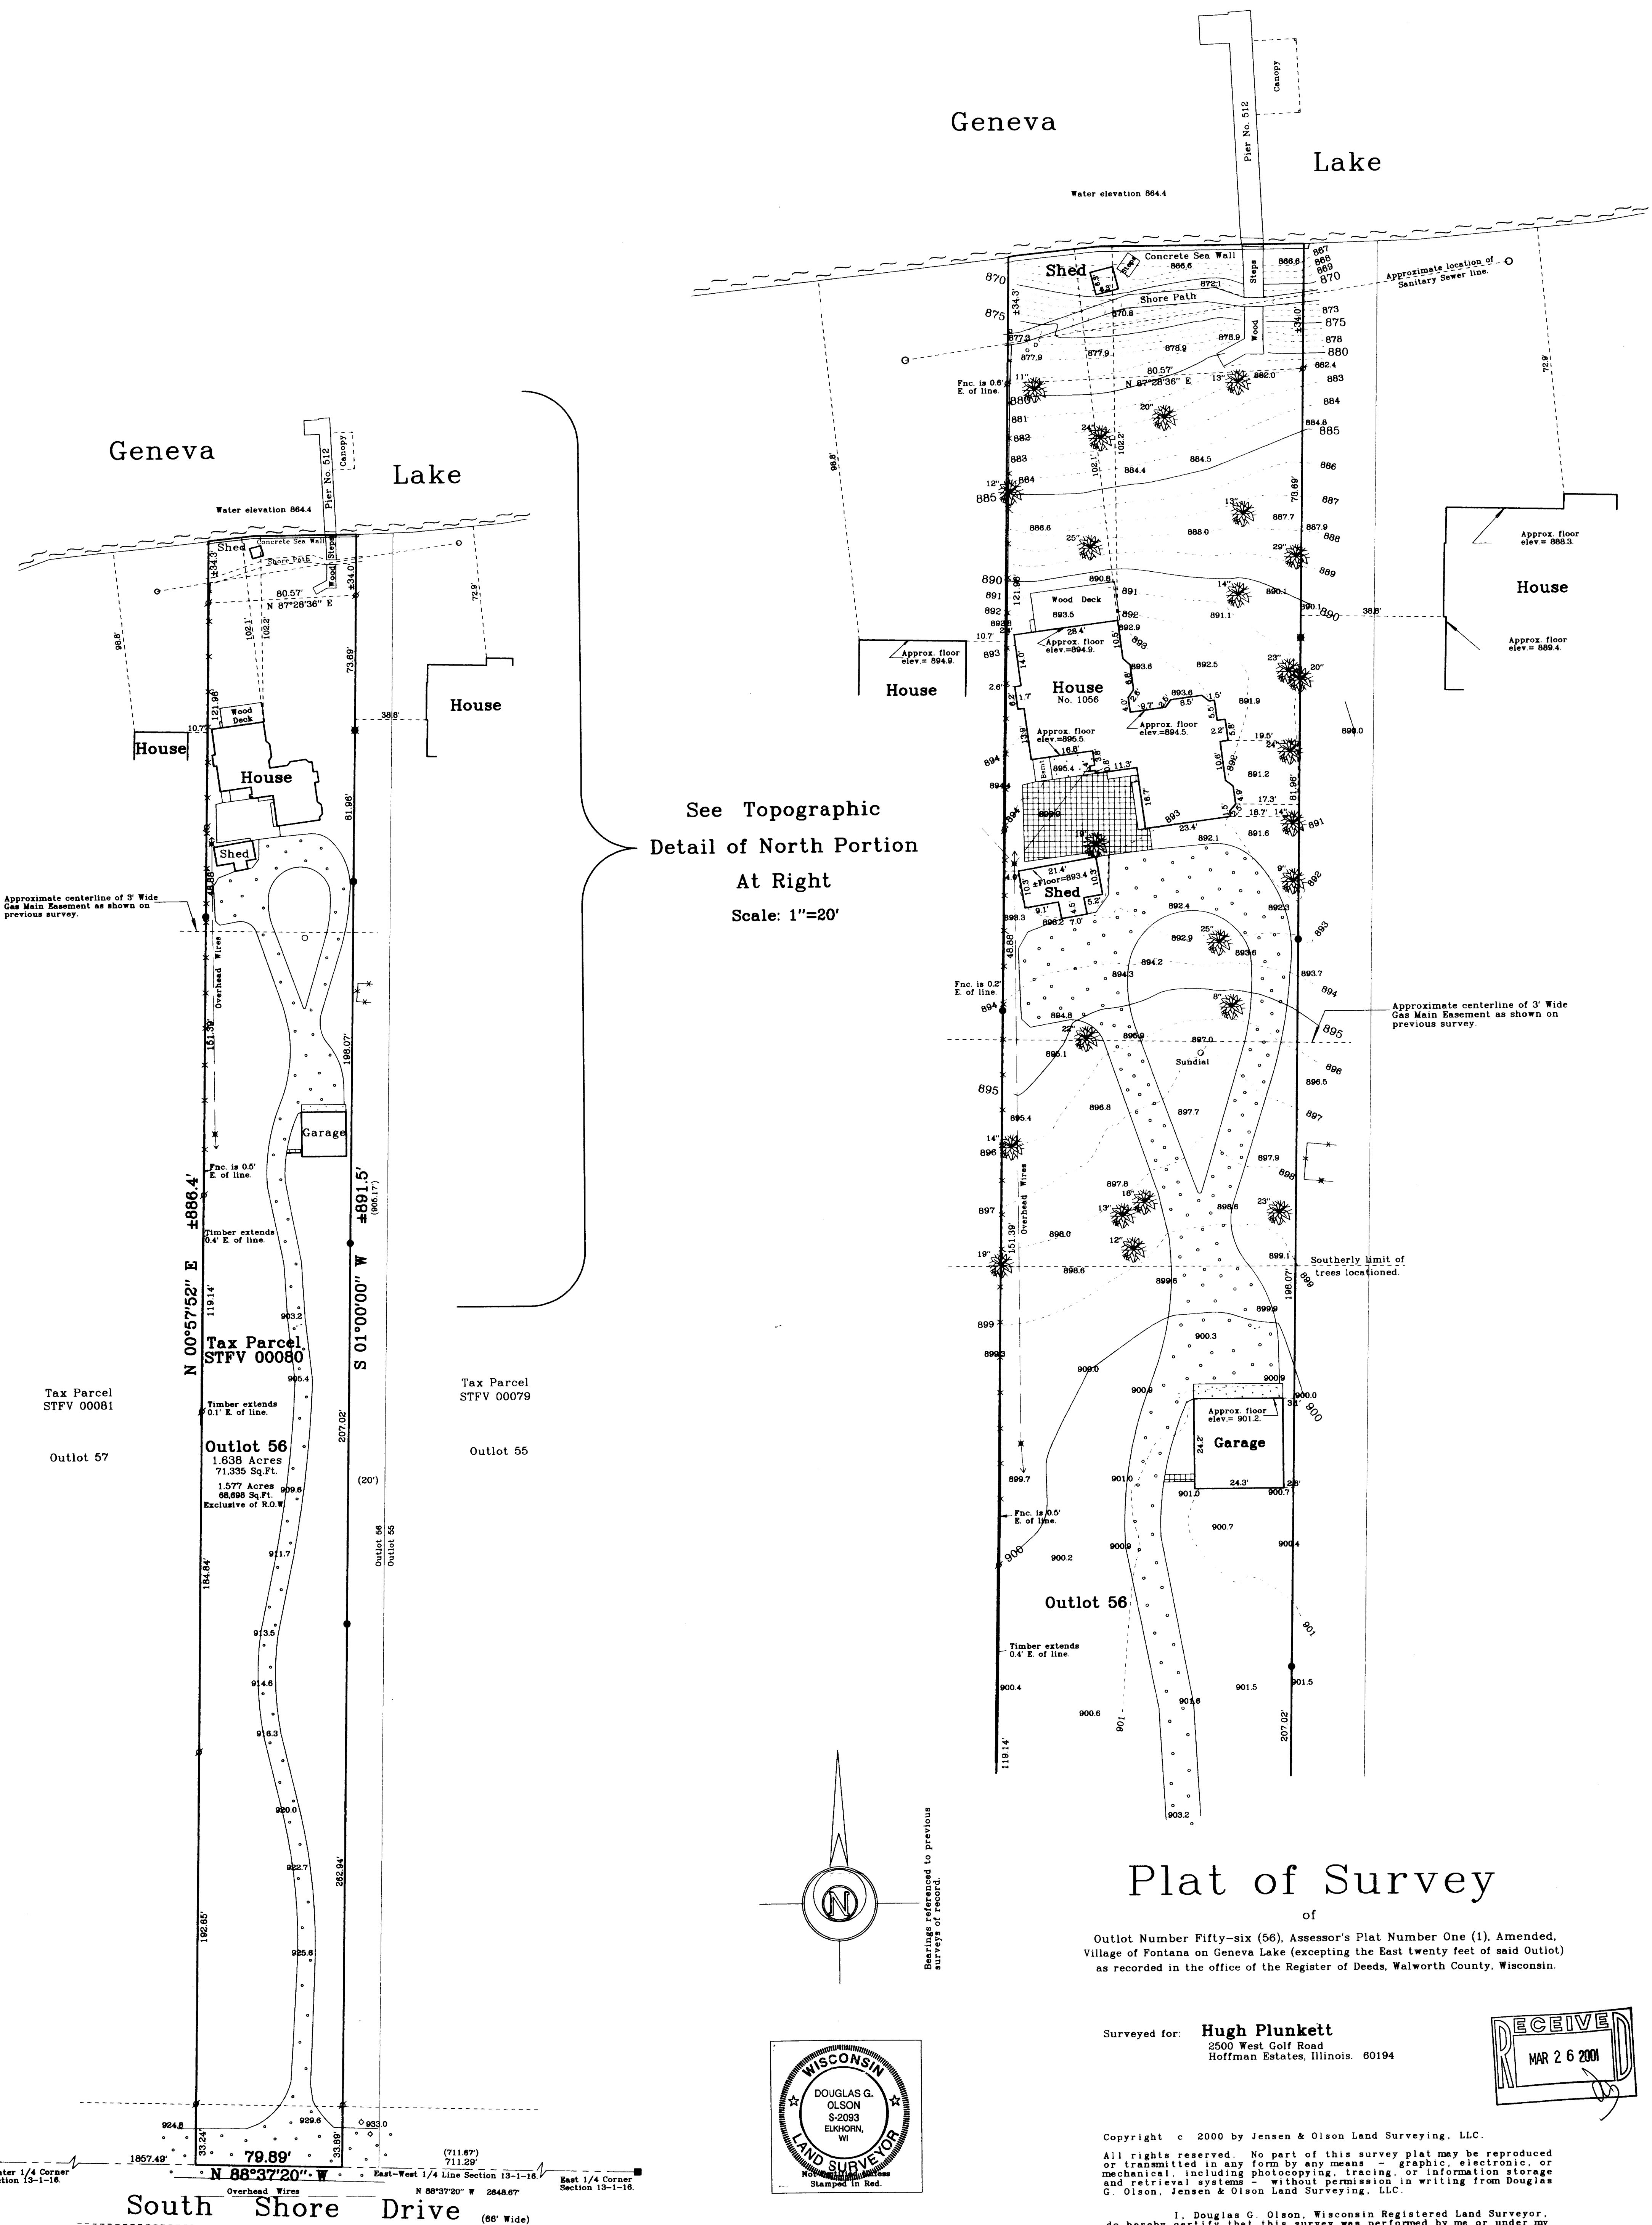

Copyright © 2000 by Jensen & Olson Land Surveying, LLC.
All rights reserved. No part of this survey plat may be reproduced or transmitted in any form by any means - graphic, electronic, or mechanical, including photocopying, tracing, or information storage and retrieval systems - without permission in writing from Douglas G. Olson, Jensen & Olson Land Surveying, LLC.
I, Douglas G. Olson, Wisconsin Registered Land Surveyor, do hereby certify that this survey was performed by me or under my direction in full compliance with the owner's instructions and Chapter A-E 7 of the Wisconsin Administrative Code "Minimum Standards for Property Surveys" and that this map is an accurate representation thereof to the best of my knowledge and belief.
Douglas G. Olson
Wisconsin Registered Land Surveyor - 2093

Sheet 1 of 1 Sheets.	Legend Found County Section Corner Found Iron Pipe Found Iron Rod Set Iron Rod 3/4" dia. () Recorded Information Utility Pole Hydrant Water Valve Manhole Deciduous Tree and Dia.
Job Reference Number 2000.085	Concrete Surface Asphalt Surface Block Walk or Patio

**Jensen & Olson Land Surveying, LLC**
45 South Wisconsin Street P.O. Box 322
Elkhorn, Wisconsin. 53121
Telephone: (262) 723-3434
Facsimile: (262) 723-8044

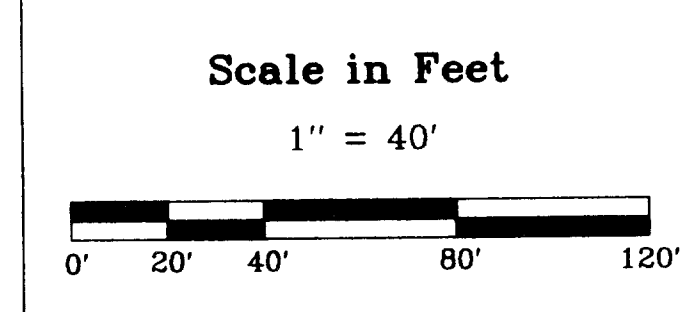

Survey date: July 18, 2000.
Revisions:

STFV-80 005-1884