



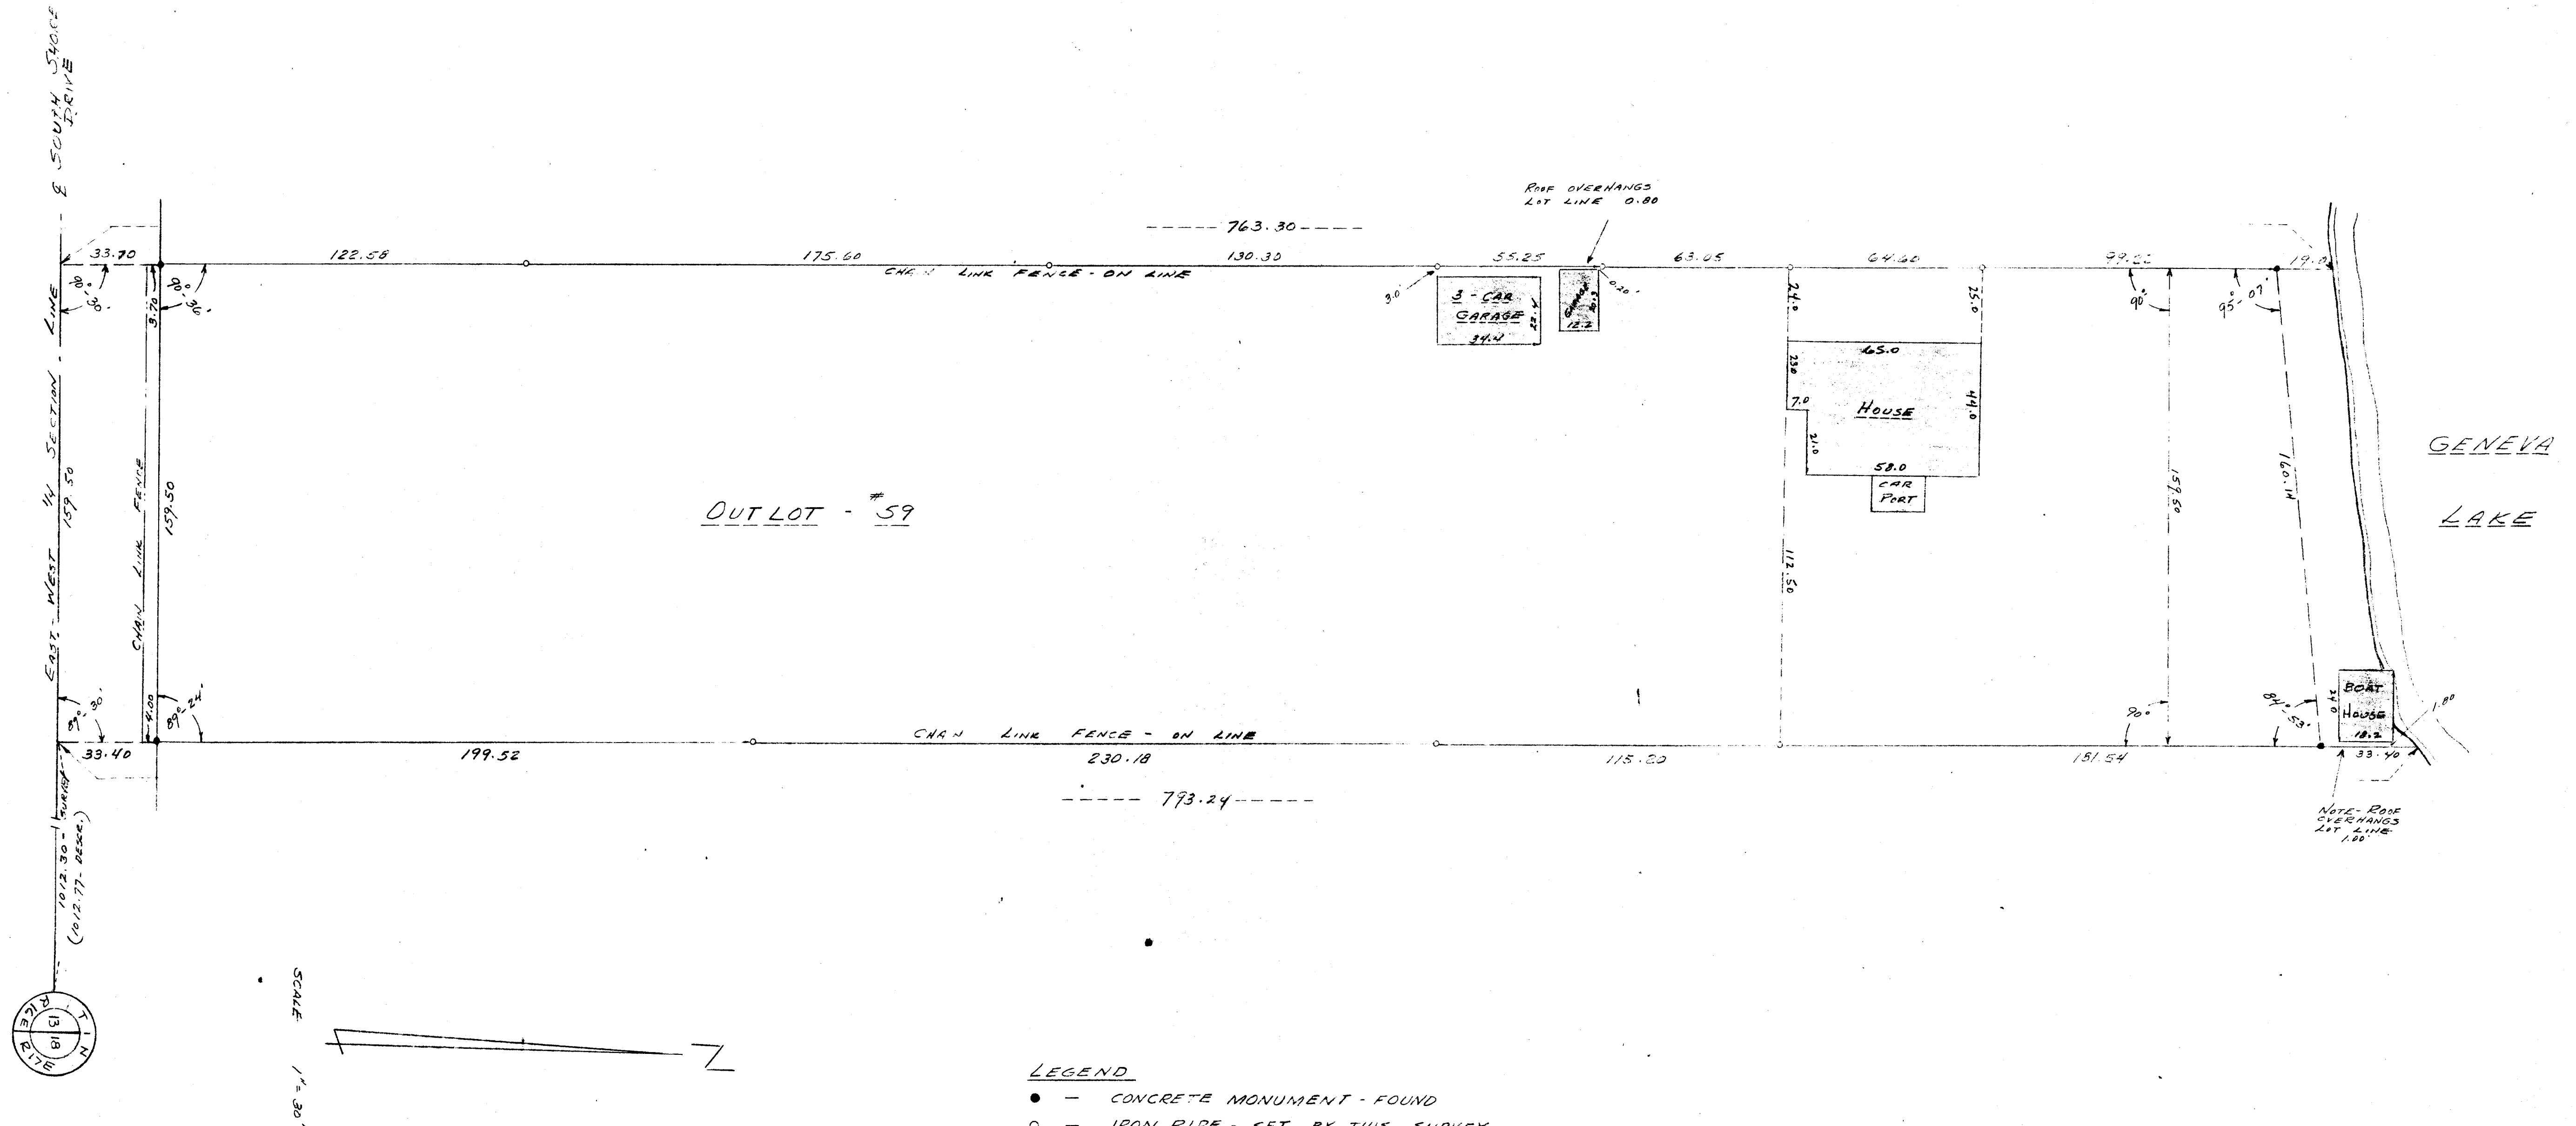

OUTLOT 59 - ASSESSORS PLAT
FONTANA - ON - GENEVA - LAKE
WALWORTH COUNTY, WISCONSIN

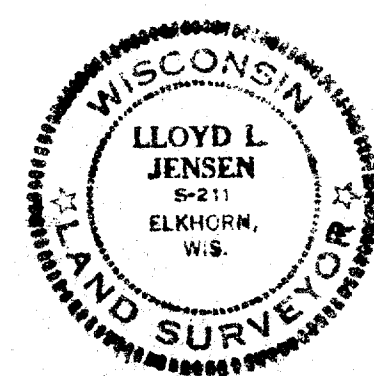

PLAT OF SURVEY		
PART OF NE 1/4 SECTION 13 T 1 N - R 16 E WALWORTH COUNTY, WISCONSIN.		
DRAWN BY GBW	JENSEN & JOHNSON CIVIL ENGINEERS ELKHORN, WIS.	SCALE: 1" = 30'
CHECKED BY <i>Lloyd L. Jensen</i>		REVISED
APPROVED BY	DATE AUGUST 1967	SHEET NO. OF