



BOUNDARY & TOPOGRAPHIC MAPPING

THE WEST 67 FEET OF LOTS 1 AND 2 OF BLOCK 2
REID'S ADDITION TO REID'S PARK
VILLAGE OF FONTANA-ON-GENEVA LAKE
WALWORTH COUNTY, WISCONSIN

WORK ORDERED BY:
KEEFE REAL ESTATE
751 GENEVA PARKWAY
LAKE GENEVA, WI.

FARRIS, HANSEN & ASSOCIATES, INC.
Engineering, Architecture, Surveying
7 Ridgway Court P.O. Box 437
ELKHORN, WISCONSIN 53121
Office: (414) 723-2098
Fax: (414) 723-5886

REVISIONS
PROJECT NO. 5338
DATE 07-19-99
SHEET NO. 1 OF 1

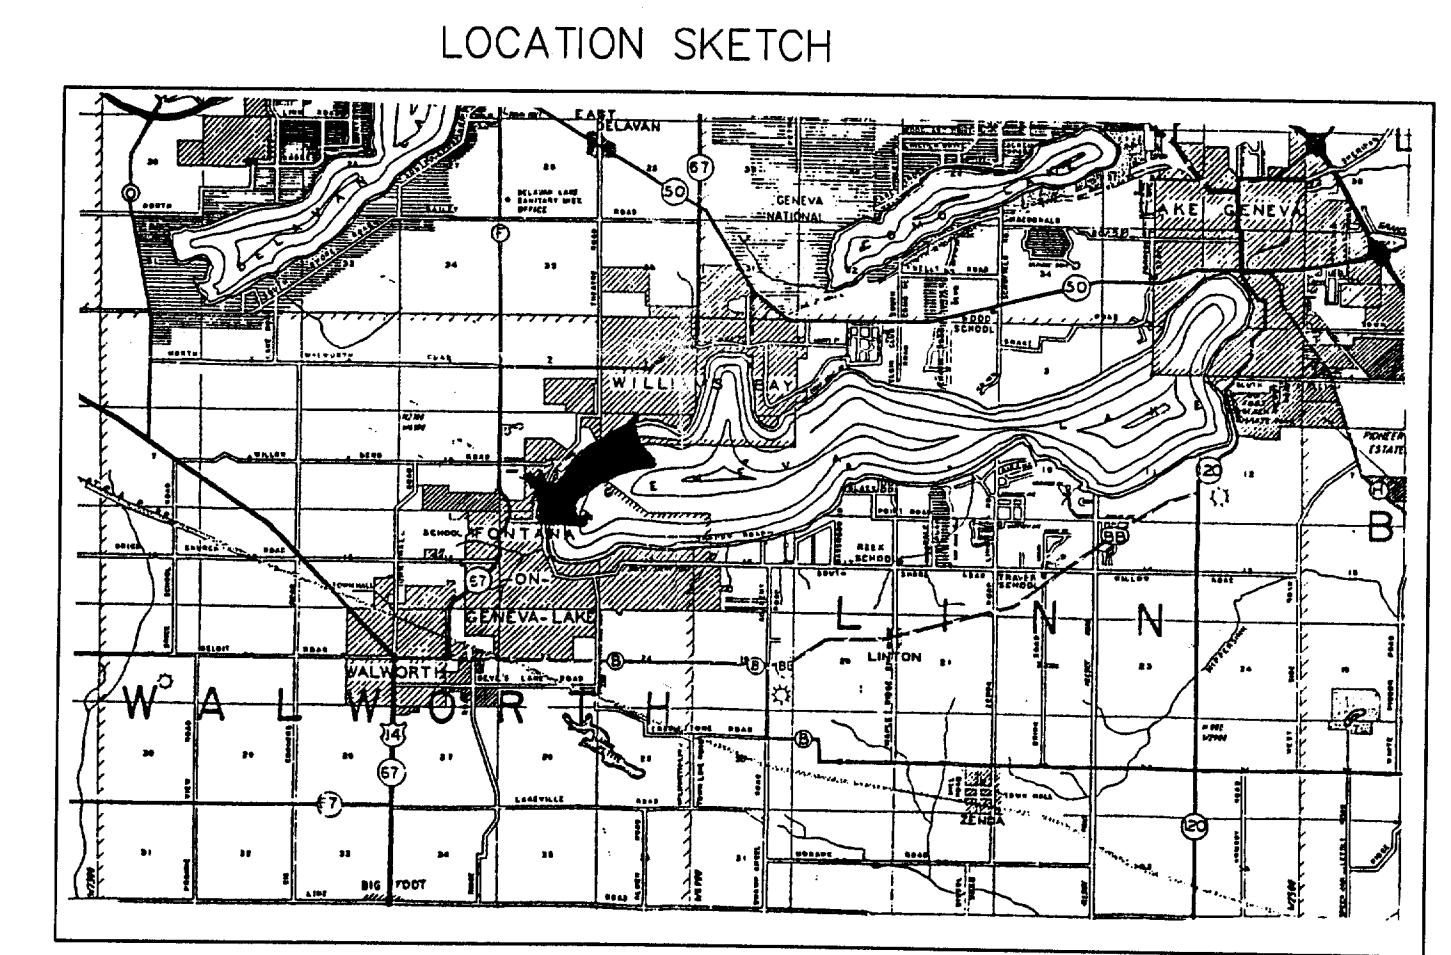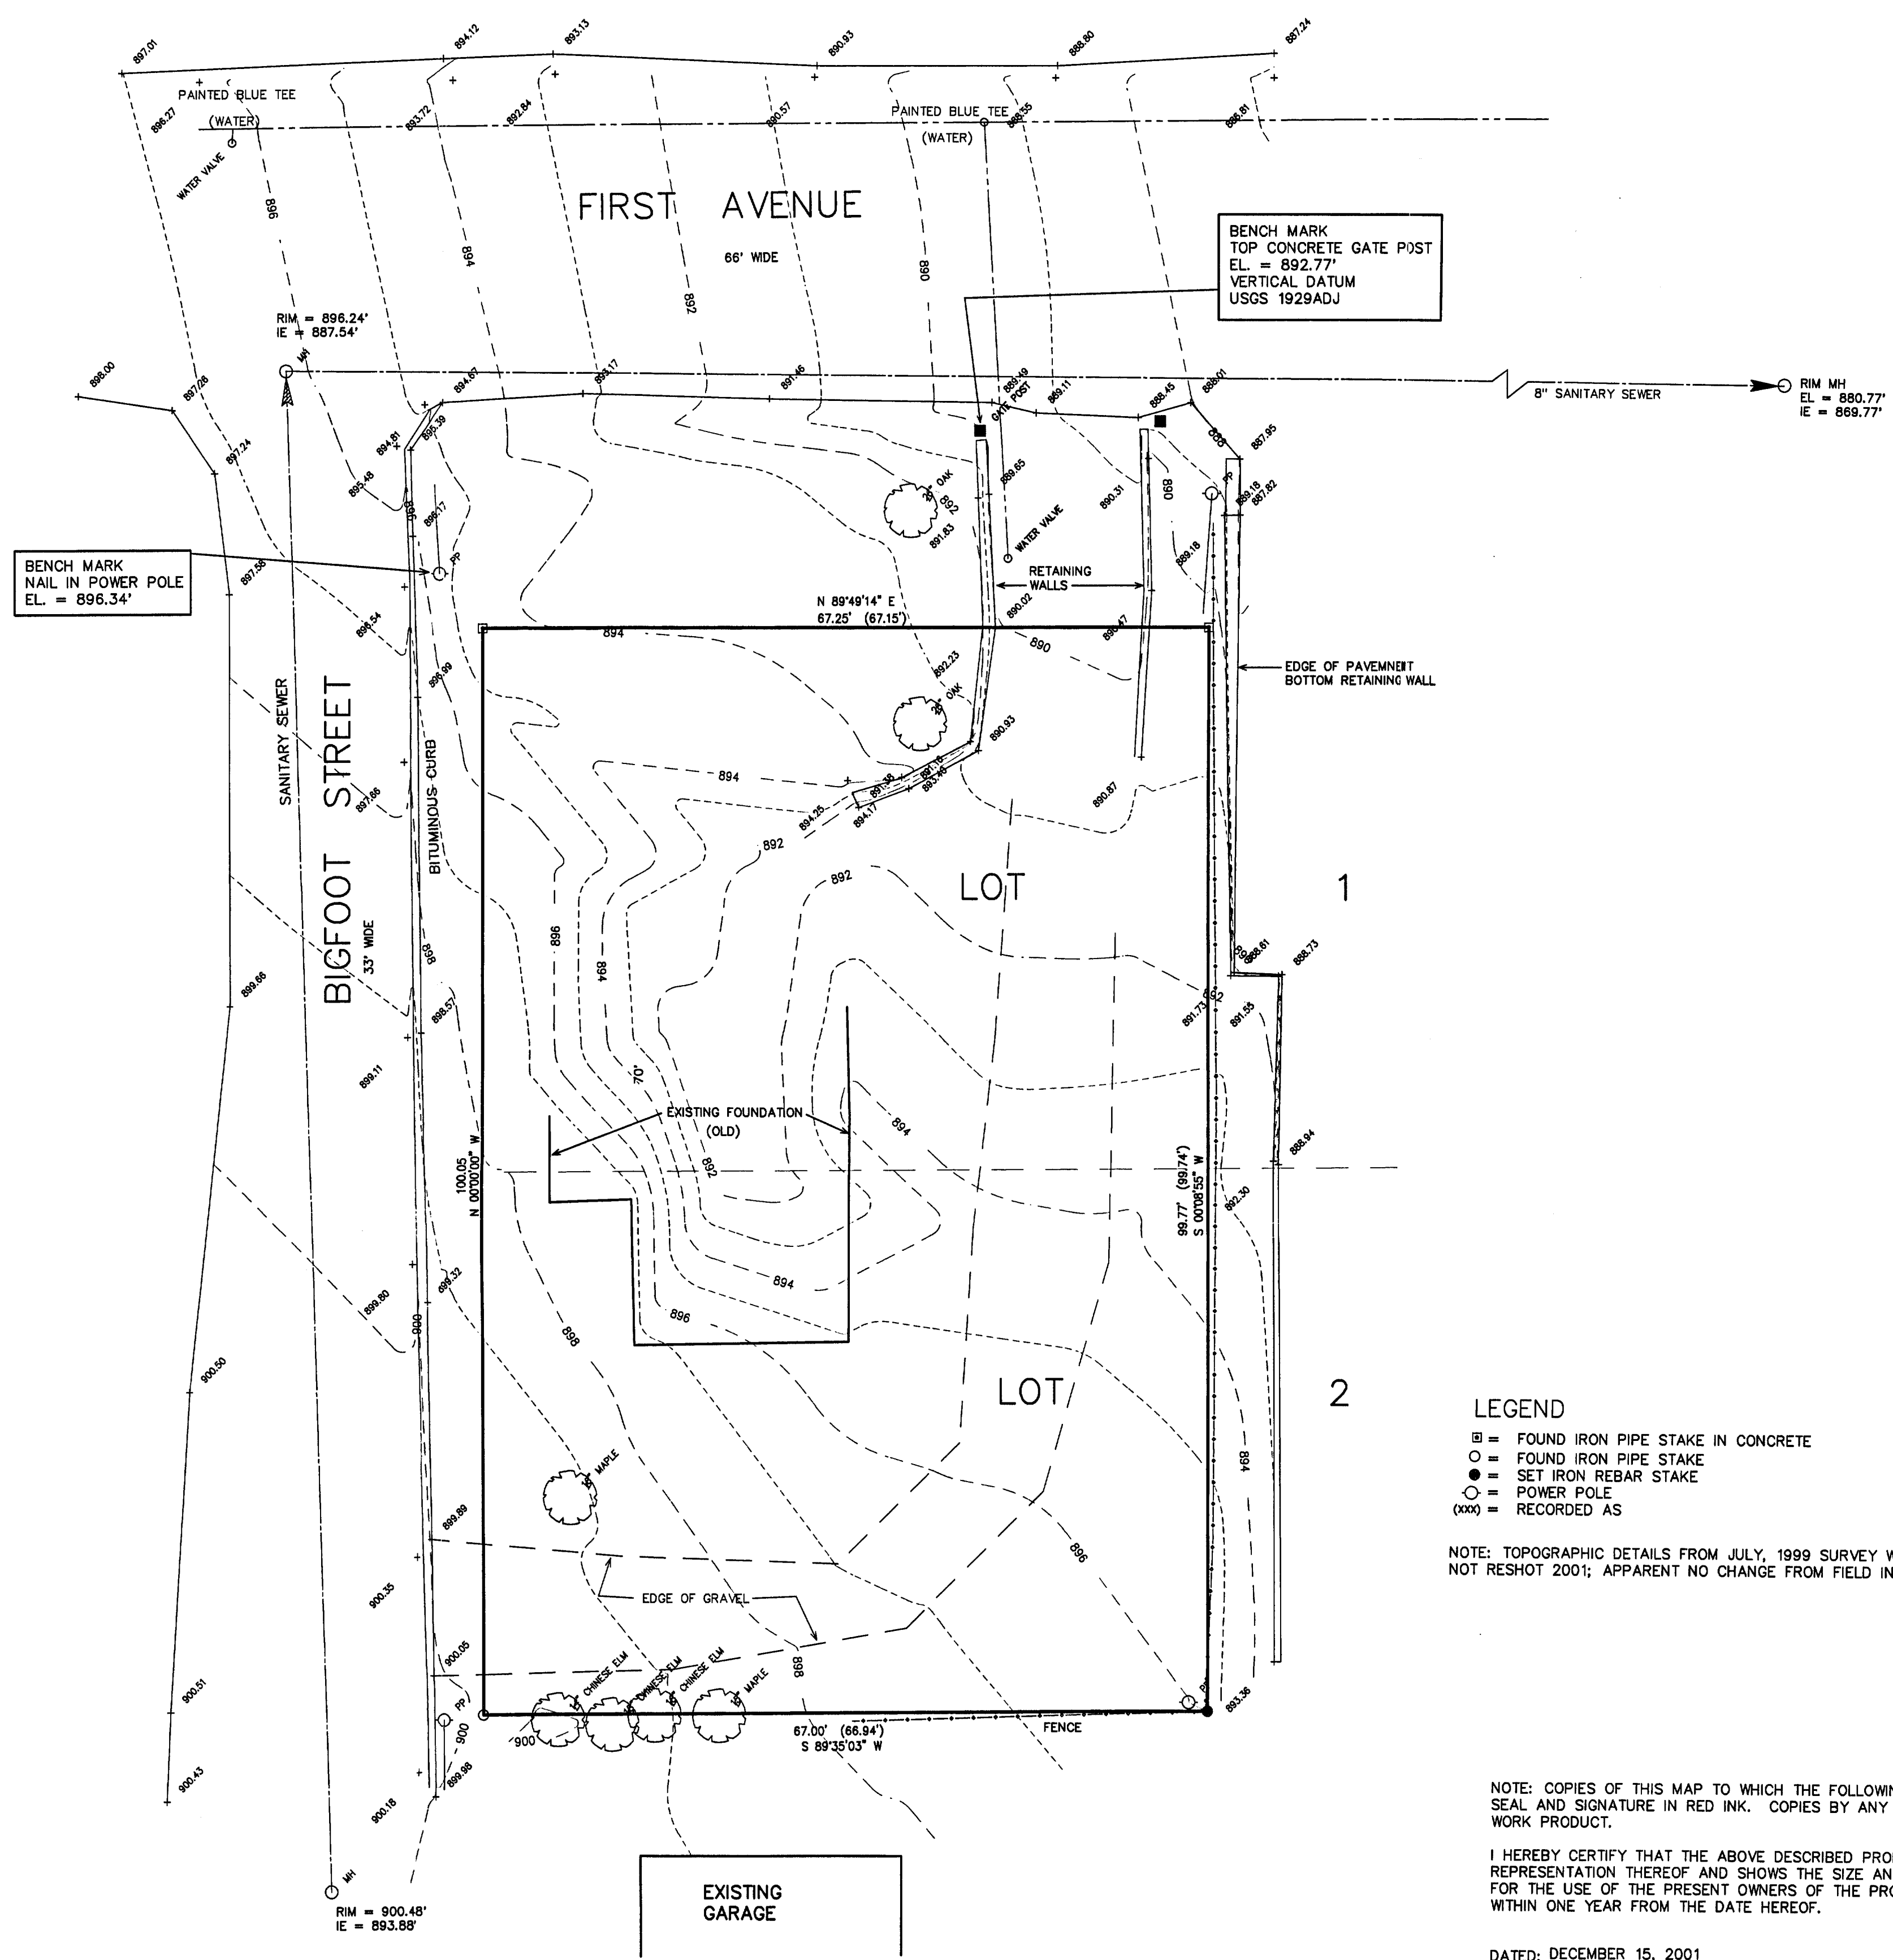

- LEGEND
- = FOUND IRON PIPE STAKE IN CONCRETE
 - = FOUND IRON PIPE STAKE
 - = SET IRON REBAR STAKE
 - = POWER POLE
 - (xxx) = RECORDED AS




NOTE: TOPOGRAPHIC DETAILS FROM JULY, 1999 SURVEY WORK
NOT RESHOT 2001; APPARENT NO CHANGE FROM FIELD INSPECTION.

NOTE: COPIES OF THIS MAP TO WHICH THE FOLLOWING CERTIFICATE WILL APPLY SHOW SURVEYOR'S ORIGINAL SEAL AND SIGNATURE IN RED INK. COPIES BY ANY OTHER MEANS MAY HAVE ALTERATIONS WHICH DO NOT REPRESENT THE SURVEYOR'S WORK PRODUCT.

I HEREBY CERTIFY THAT THE ABOVE DESCRIBED PROPERTY HAS BEEN SURVEYED UNDER MY DIRECTION AND THAT THE ABOVE MAP IS A TRUE REPRESENTATION THEREOF AND SHOWS THE SIZE AND LOCATION OF THE PROPERTY AND ITS EXTERIOR BOUNDARIES. THIS SURVEY IS MADE FOR THE USE OF THE PRESENT OWNERS OF THE PROPERTY, AND ALSO THOSE WHO PURCHASE, MORTGAGE, OR GUARANTEE THE TITLE THERETO WITHIN ONE YEAR FROM THE DATE HEREOF.

DATED: DECEMBER 15, 2001

Peter S. Gordon
PETER S. GORDON R.L.S. 2101

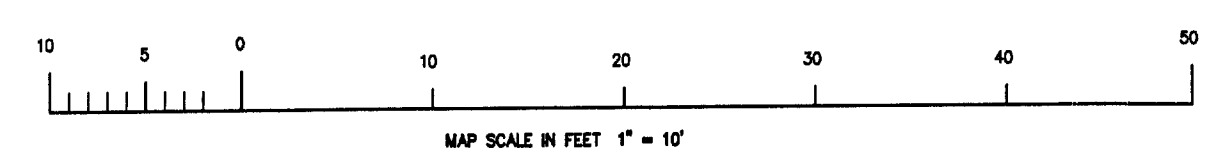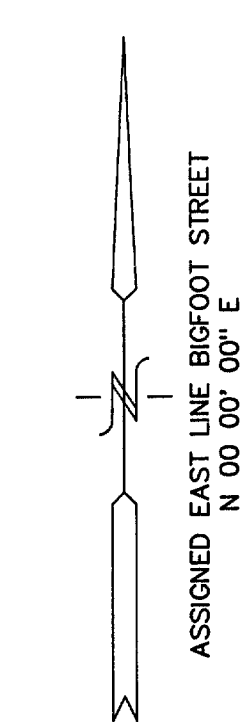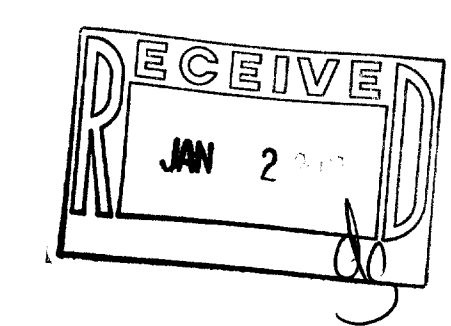

DEC 14 2001

SRA-91 005-1962