

ABERNATHY and ASSOCIATES


Kenneth B. Abernathy Jr.

Wisconsin Registered Land Surveyor S-1594

Rt. 3, Box 273
Elkhorn, Wisconsin 53121
Phone: (414) 723-4260 (office)
(414) 723-7209 (FAX)

PLAT OF SURVEY


LOT 18 IN COUNTRY CLUB ESTATES ADDITION "K", BEING A SUBDIVISION OF PART OF THE NORTHWEST 1/4 AND THE SOUTHWEST 1/4 OF THE NORTHWEST 1/4 OF SECTION 23 AND THE NORTHEAST 1/4 AND THE SOUTHEAST 1/4 OF THE NORTHEAST 1/4 OF SECTION 22 AND PARTS OF OUTLOTS 104 AND 106 OF THE ASSESSOR'S PLAT OF THE VILLAGE OF FONTANA-ON-GENEVA LAKE, TOWNSHIP 1 NORTH, RANGE 16 EAST, IN THE VILLAGE OF FONTANA-ON-GENEVA LAKE, WALWORTH COUNTY, WISCONSIN.

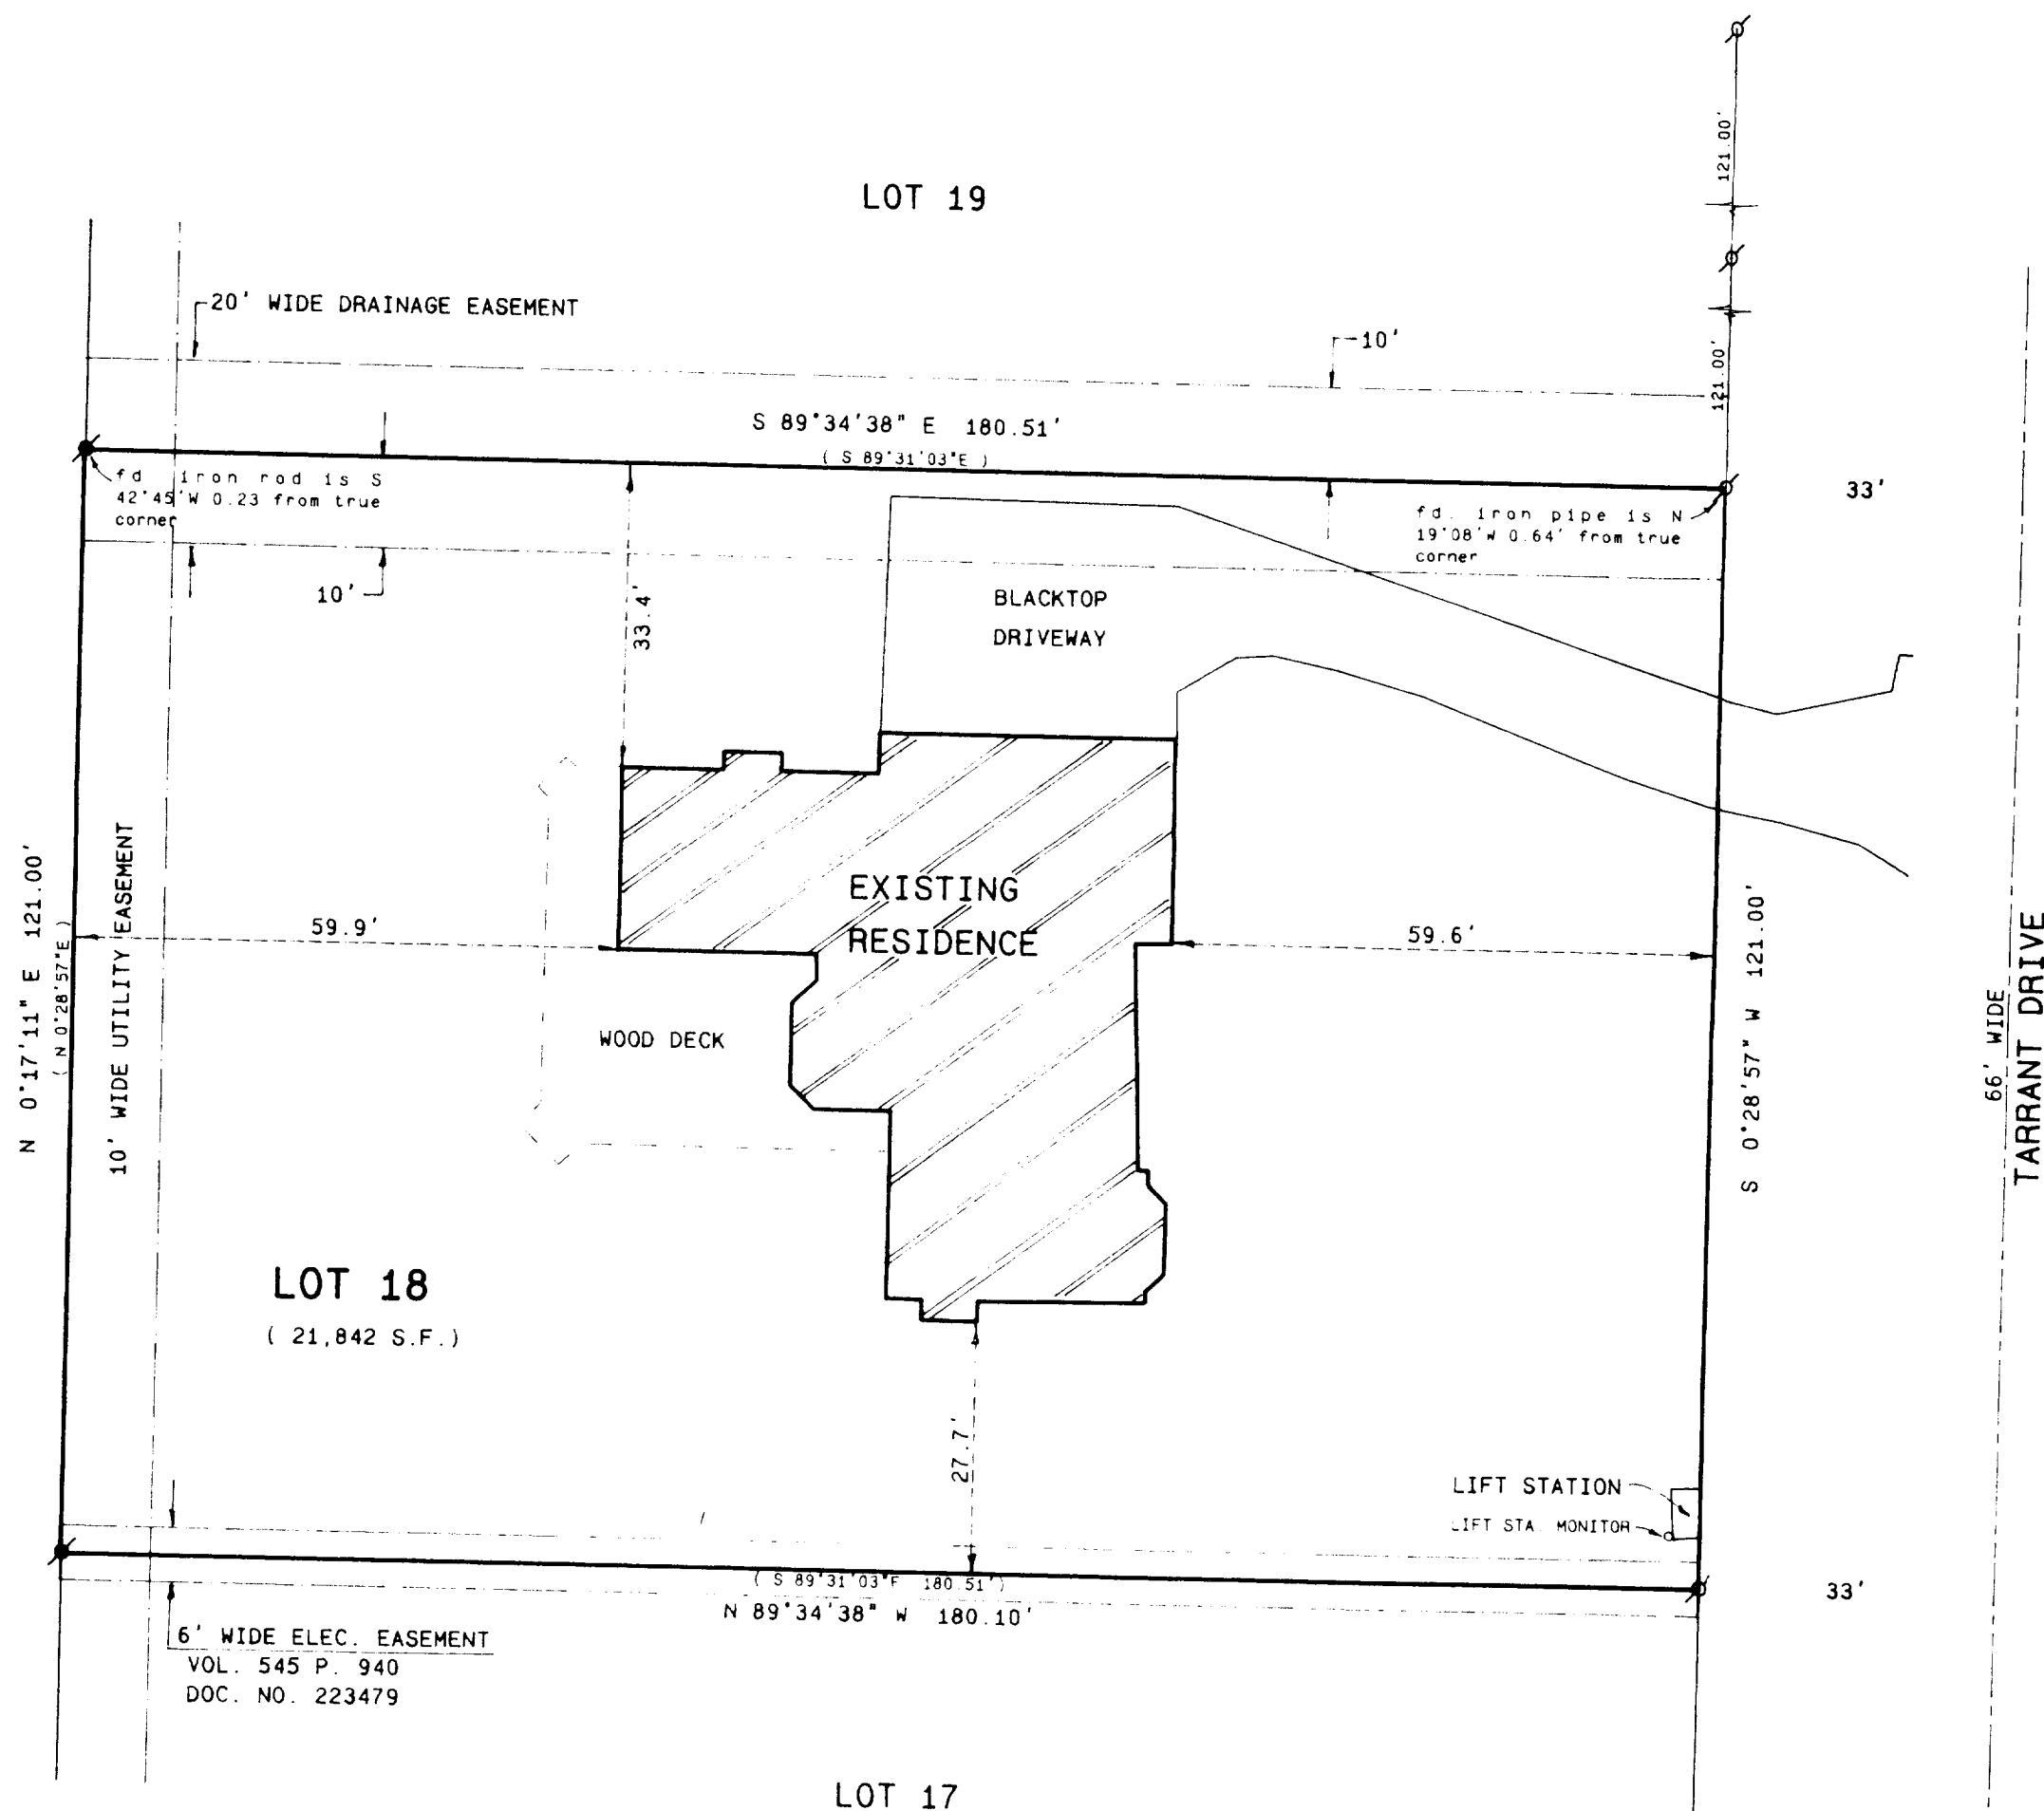

ORDERED BY: JOHN LAW
RE/MAX GENEVA REALTY, LTD.
101 BROAD ST. SUITE 102
LAKE GENEVA, WI. 53147

OWNERS: JAMES AND JEANETTE O'DIERNO
1026 TARRANT DR.
FONTANA, WI. 53125

LINE	DISTANCE
L1	2.00
L2	2.00
L3	3.99
L4	1.12
L5	1.60
L6	2.86
L7	2.78
L8	1.24
L9	.30
L10	.10
L11	2.21
L12	2.32
L13	3.88
L14	3.61
L15	3.70
L16	2.87

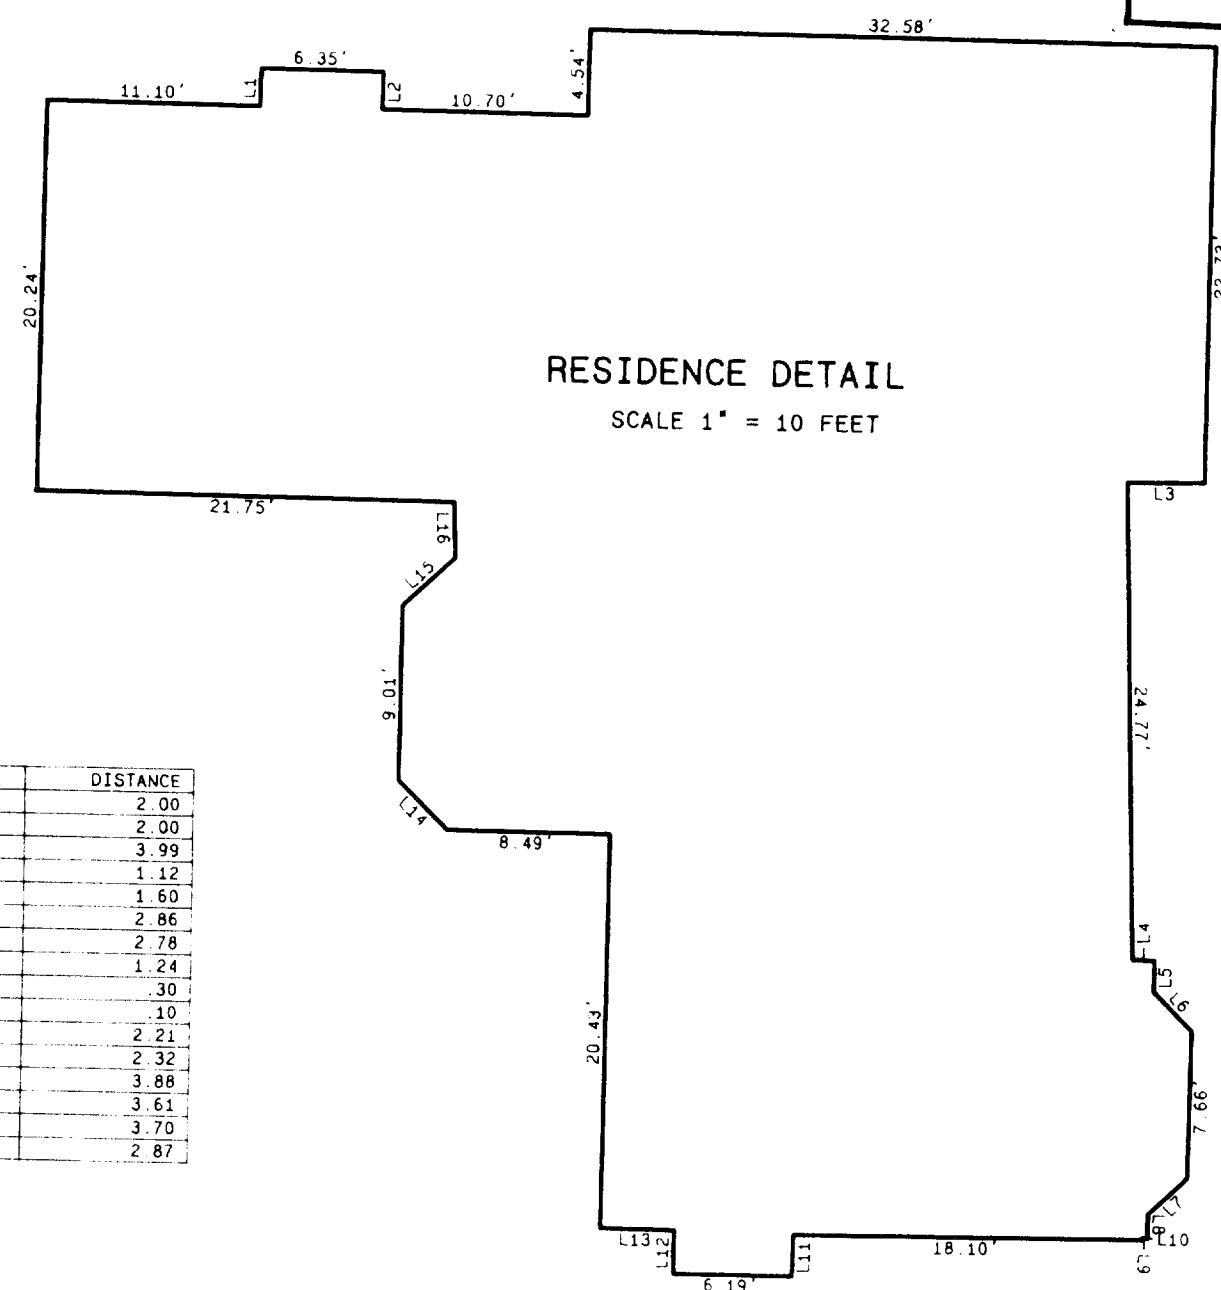

Legend

- FOUND IRON PIPE
- FOUND IRON ROD
- FOUND BRASS CAPPIE MONUMENT
- FOUND CONCRETE MONUMENT
- CHISEL CUT IN CONCRETE
- SET IRON ROD, 24" LONG, WEIGHING 1.5 LBS. LINEAL FT. 1/4" DIA.
- SET IRON ROD, 36" LONG, WEIGHING 4.5 LBS. LINEAL FT. 1/2" DIA.
- RECORDED AS DIMENSION
- EXISTING FENCE

SCALE 1" = 20 FEET



SCALE 1" = 20 FEET

I hereby certify that the above described property has been surveyed and that the lines and corners have been found and marked as shown on this plat. I am a duly licensed and registered land surveyor in the State of Wisconsin and I am not aware of any other claims or interests in the property described herein.

Kenneth B. Abernathy, Jr.

KENNETH B. ABERNATHY, JR.
WISCONSIN REGISTERED LAND SURVEYOR,
S-1594

Date Nov 28, 2001 Job No. 011107

SETK-181 005-1979