




Lot 11, Block 9 of the Original Plat of the Village of Fontana-
on-Geneva Lake, Walworth County, Wisconsin.

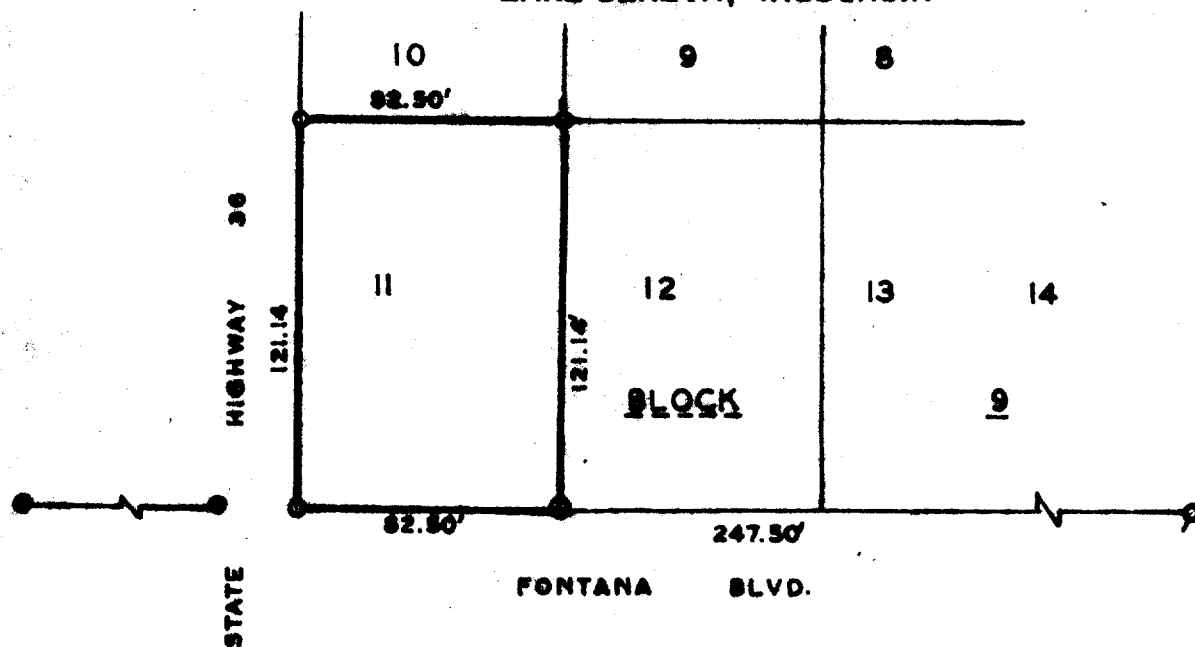

- # - IRON PIPE FOUND
 O - IRON PIPE PLACED
 ● - CONCRETE MONUMENT FOUND
 X - SPIKE
 ● - CUT CROSS IN CONCRETE
 SCALE: 1" = 50'

I, HAROLD H. KOLB, DO HEREBY CERTIFY THAT I HAVE SURVEYED THE PROPERTY HEREON DESCRIBED ACCORDING TO THE OFFICIAL RECORDS, AND THAT THE FLAT HEREON IS A CORRECT REPRESENTATION OF THE LOT LINES.

Harold H. Koltz
HAROLD H. KOLTZ
WISCONSIN REGISTERED LAND SURVEYOR, S-187
DATE July 28, 1965