


STREET

BIGFOOT


33'

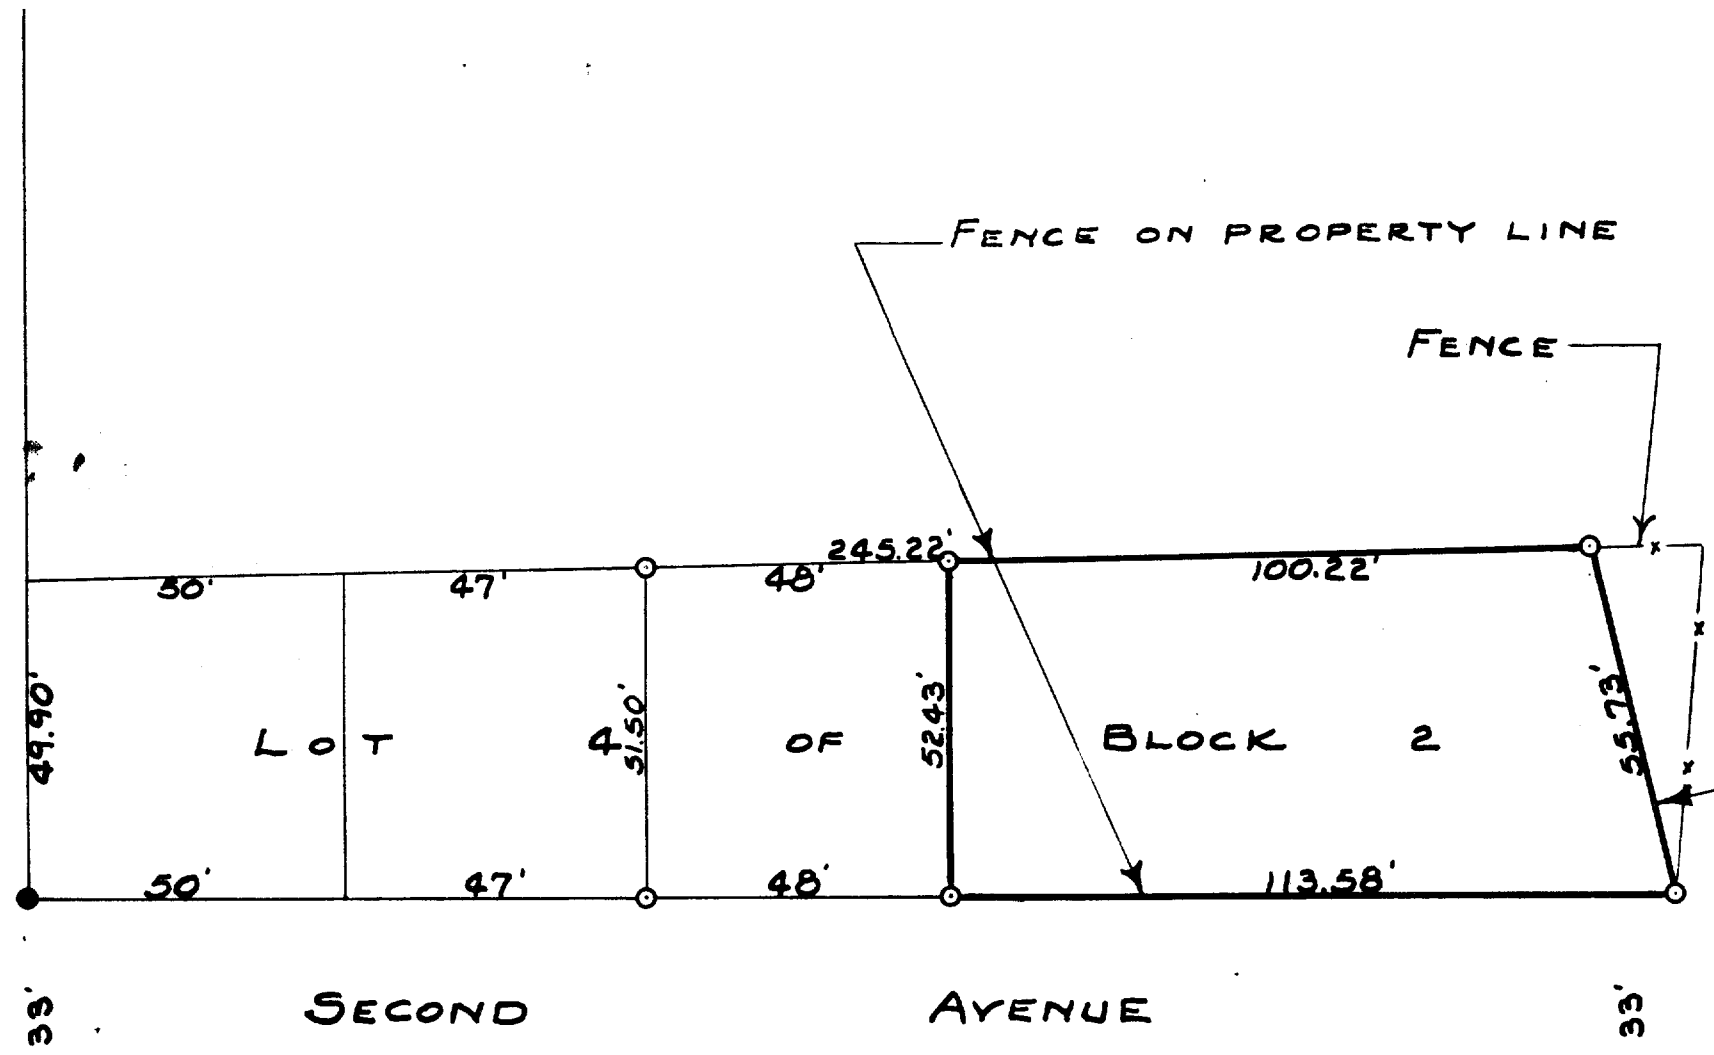

LOT 4 OF BLOCK 1 OF D.A. REID'S
ADDITION TO REID'S PARK.

ROAD
PUBLIC

GENEVA LAKE

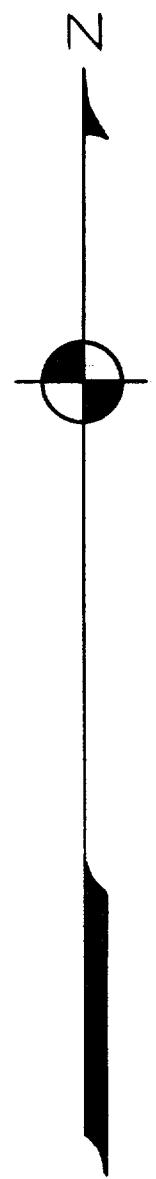

○-IRON PIPE
●-CONC. MONU
SCALE 1"=30'

PLAT OF SURVEY OF LOT 4 OF BLOCK 2 OF D.A. REID'S
ADDITION TO REID'S PARK LOCATED IN THE VILLAGE
OF FONTANA-ON-GENEVA LAKE, WALWORTH COUNTY
WISCONSIN.

Lloyd L. Jensen
COUNTY SURVEYOR

JUNE 1944

5-19J