


N

SCALE 1"=10'

0=IRON PIPE

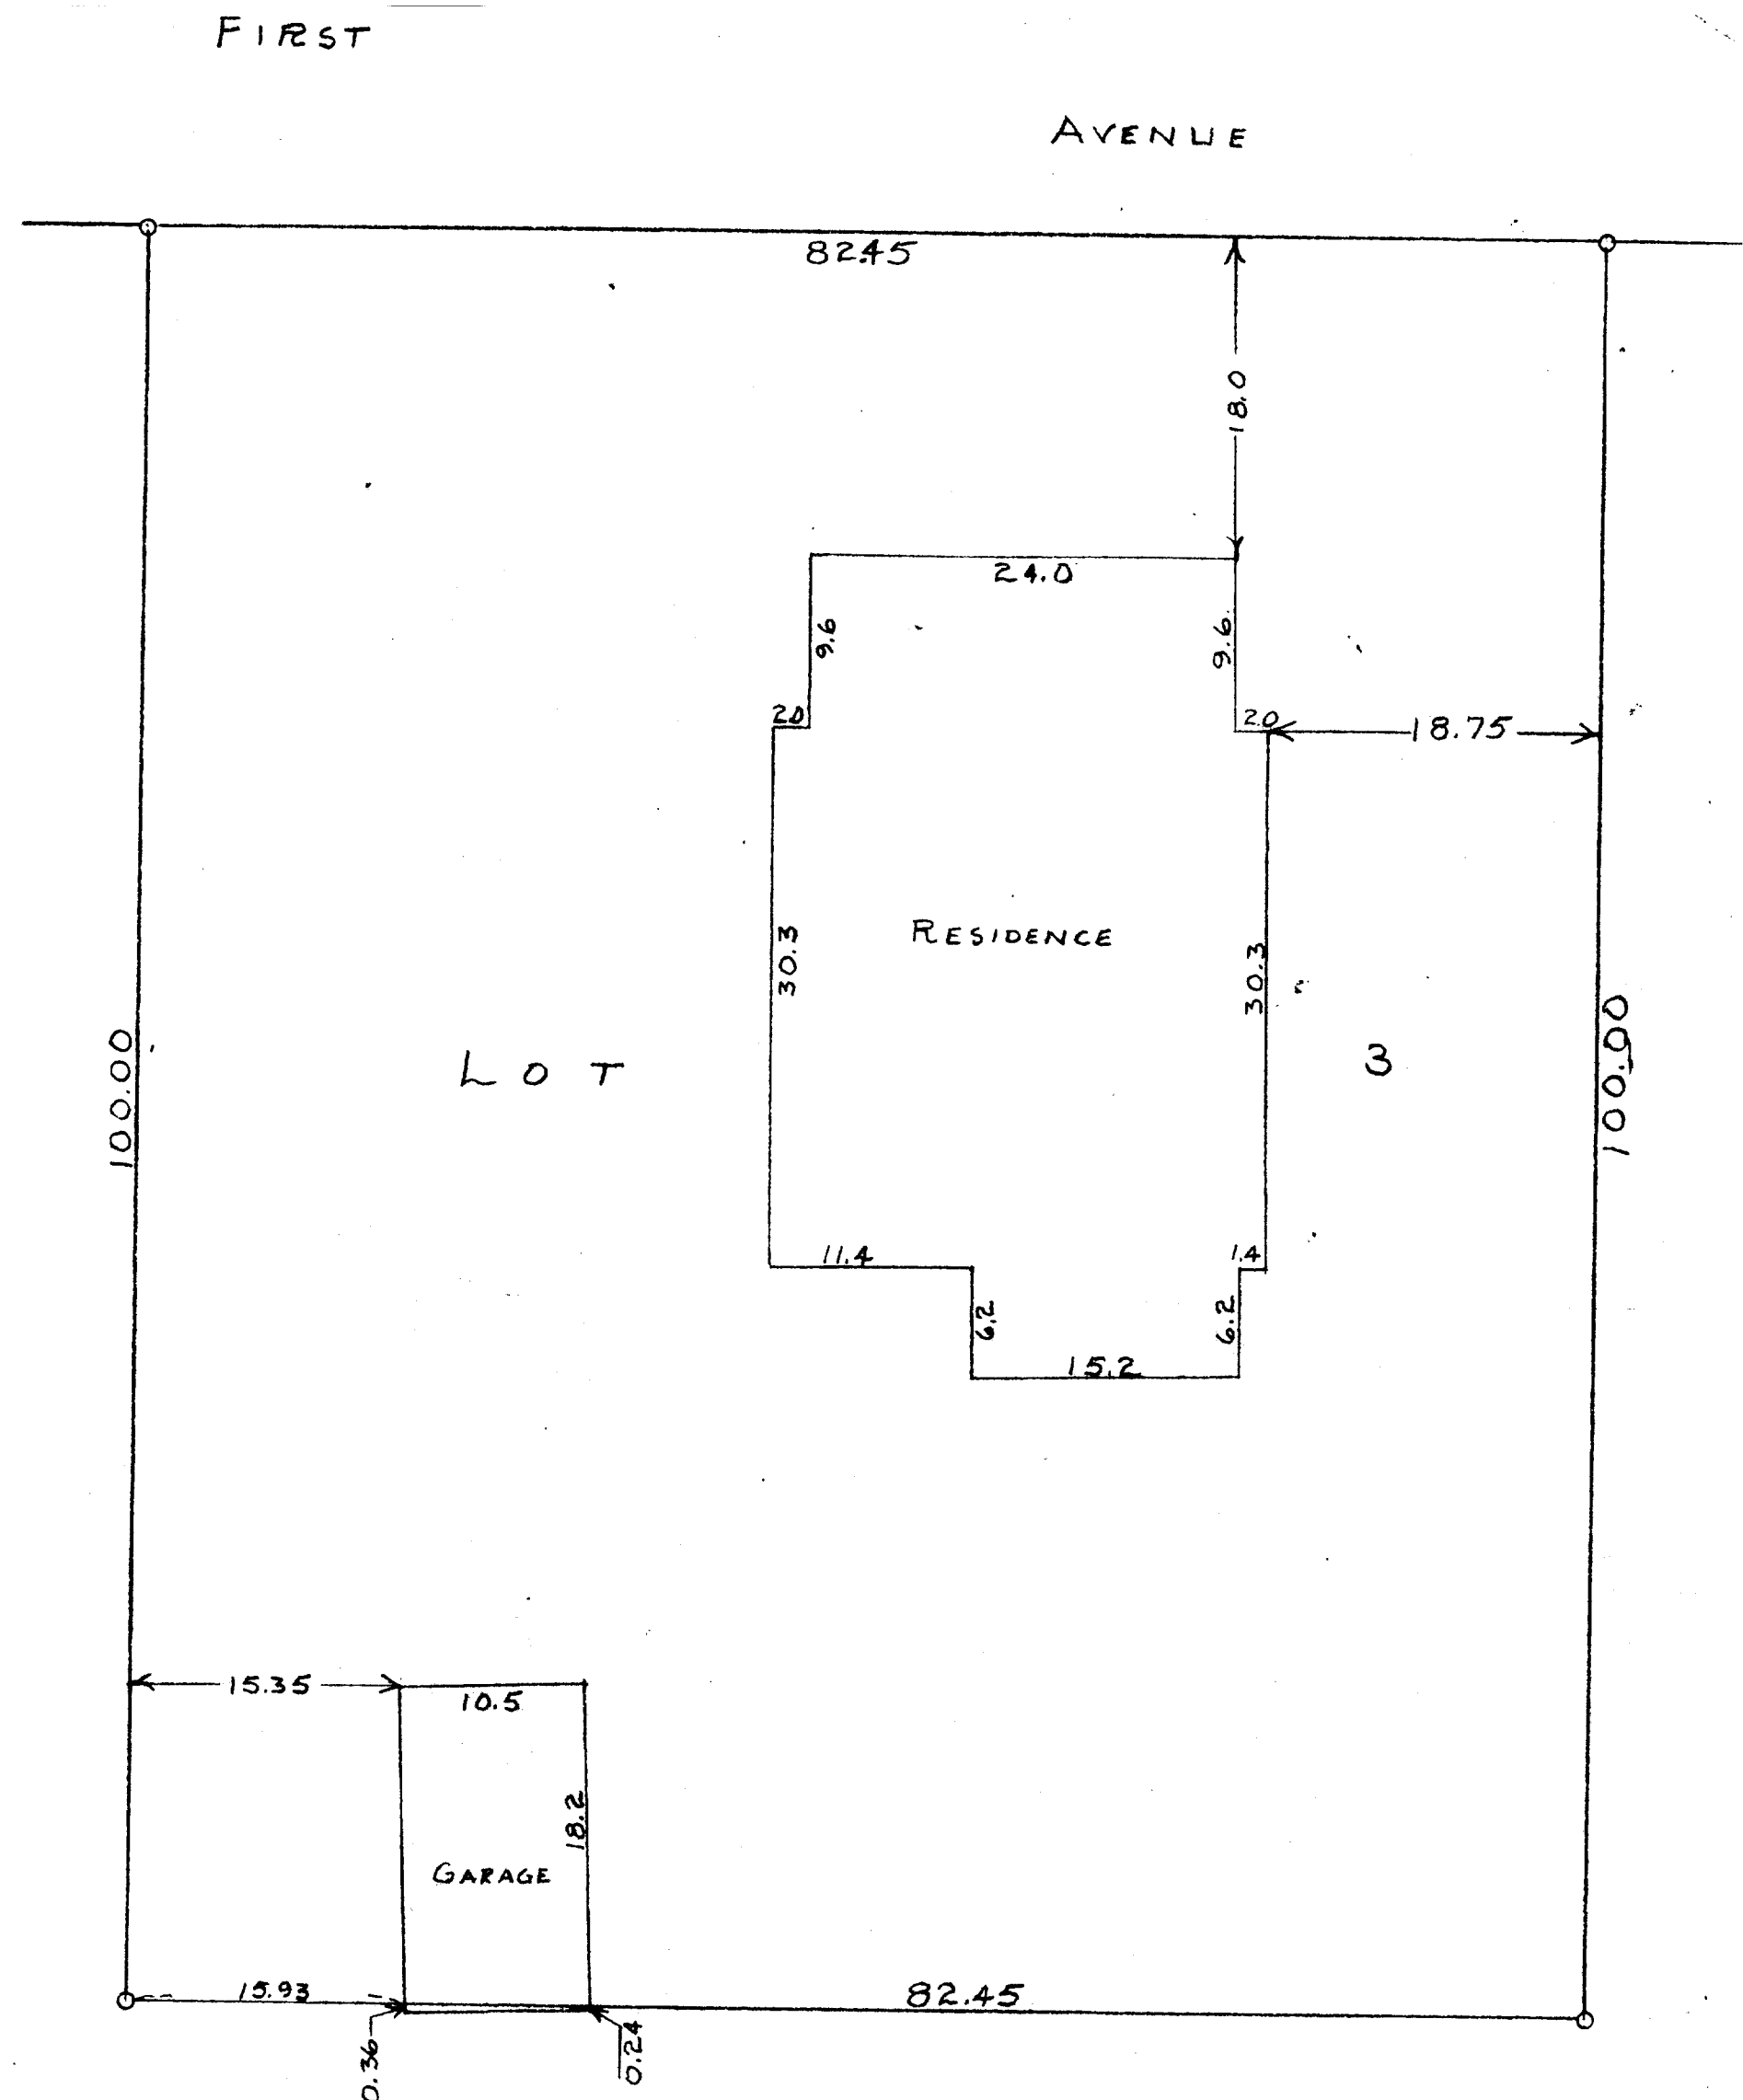

STATE OF WISCONSIN)ss
WALWORTH COUNTY

I, GEORGE T. DUNHAM, DO HEREBY CERTIFY THAT I HAVE SURVEYED THE
PROPERTY DESCRIBED AS FOLLOWS:

LOT 3, BLOCK 2 OF THE ORIGINAL PLAT, VILLAGE OF FONTANA
WALWORTH COUNTY, WISCONSIN

AND THAT THE PLAT SHOWN ABOVE IS A CORRECT REPRESENTATION OF THE PROPERTY
LINES AND OF THE IMPROVEMENTS LOCATED THEREON

OCT. 14, 1958

George T. Dunham
GEORGE T. DUNHAM, SURVEYOR
DELAVER, WISCONSIN