



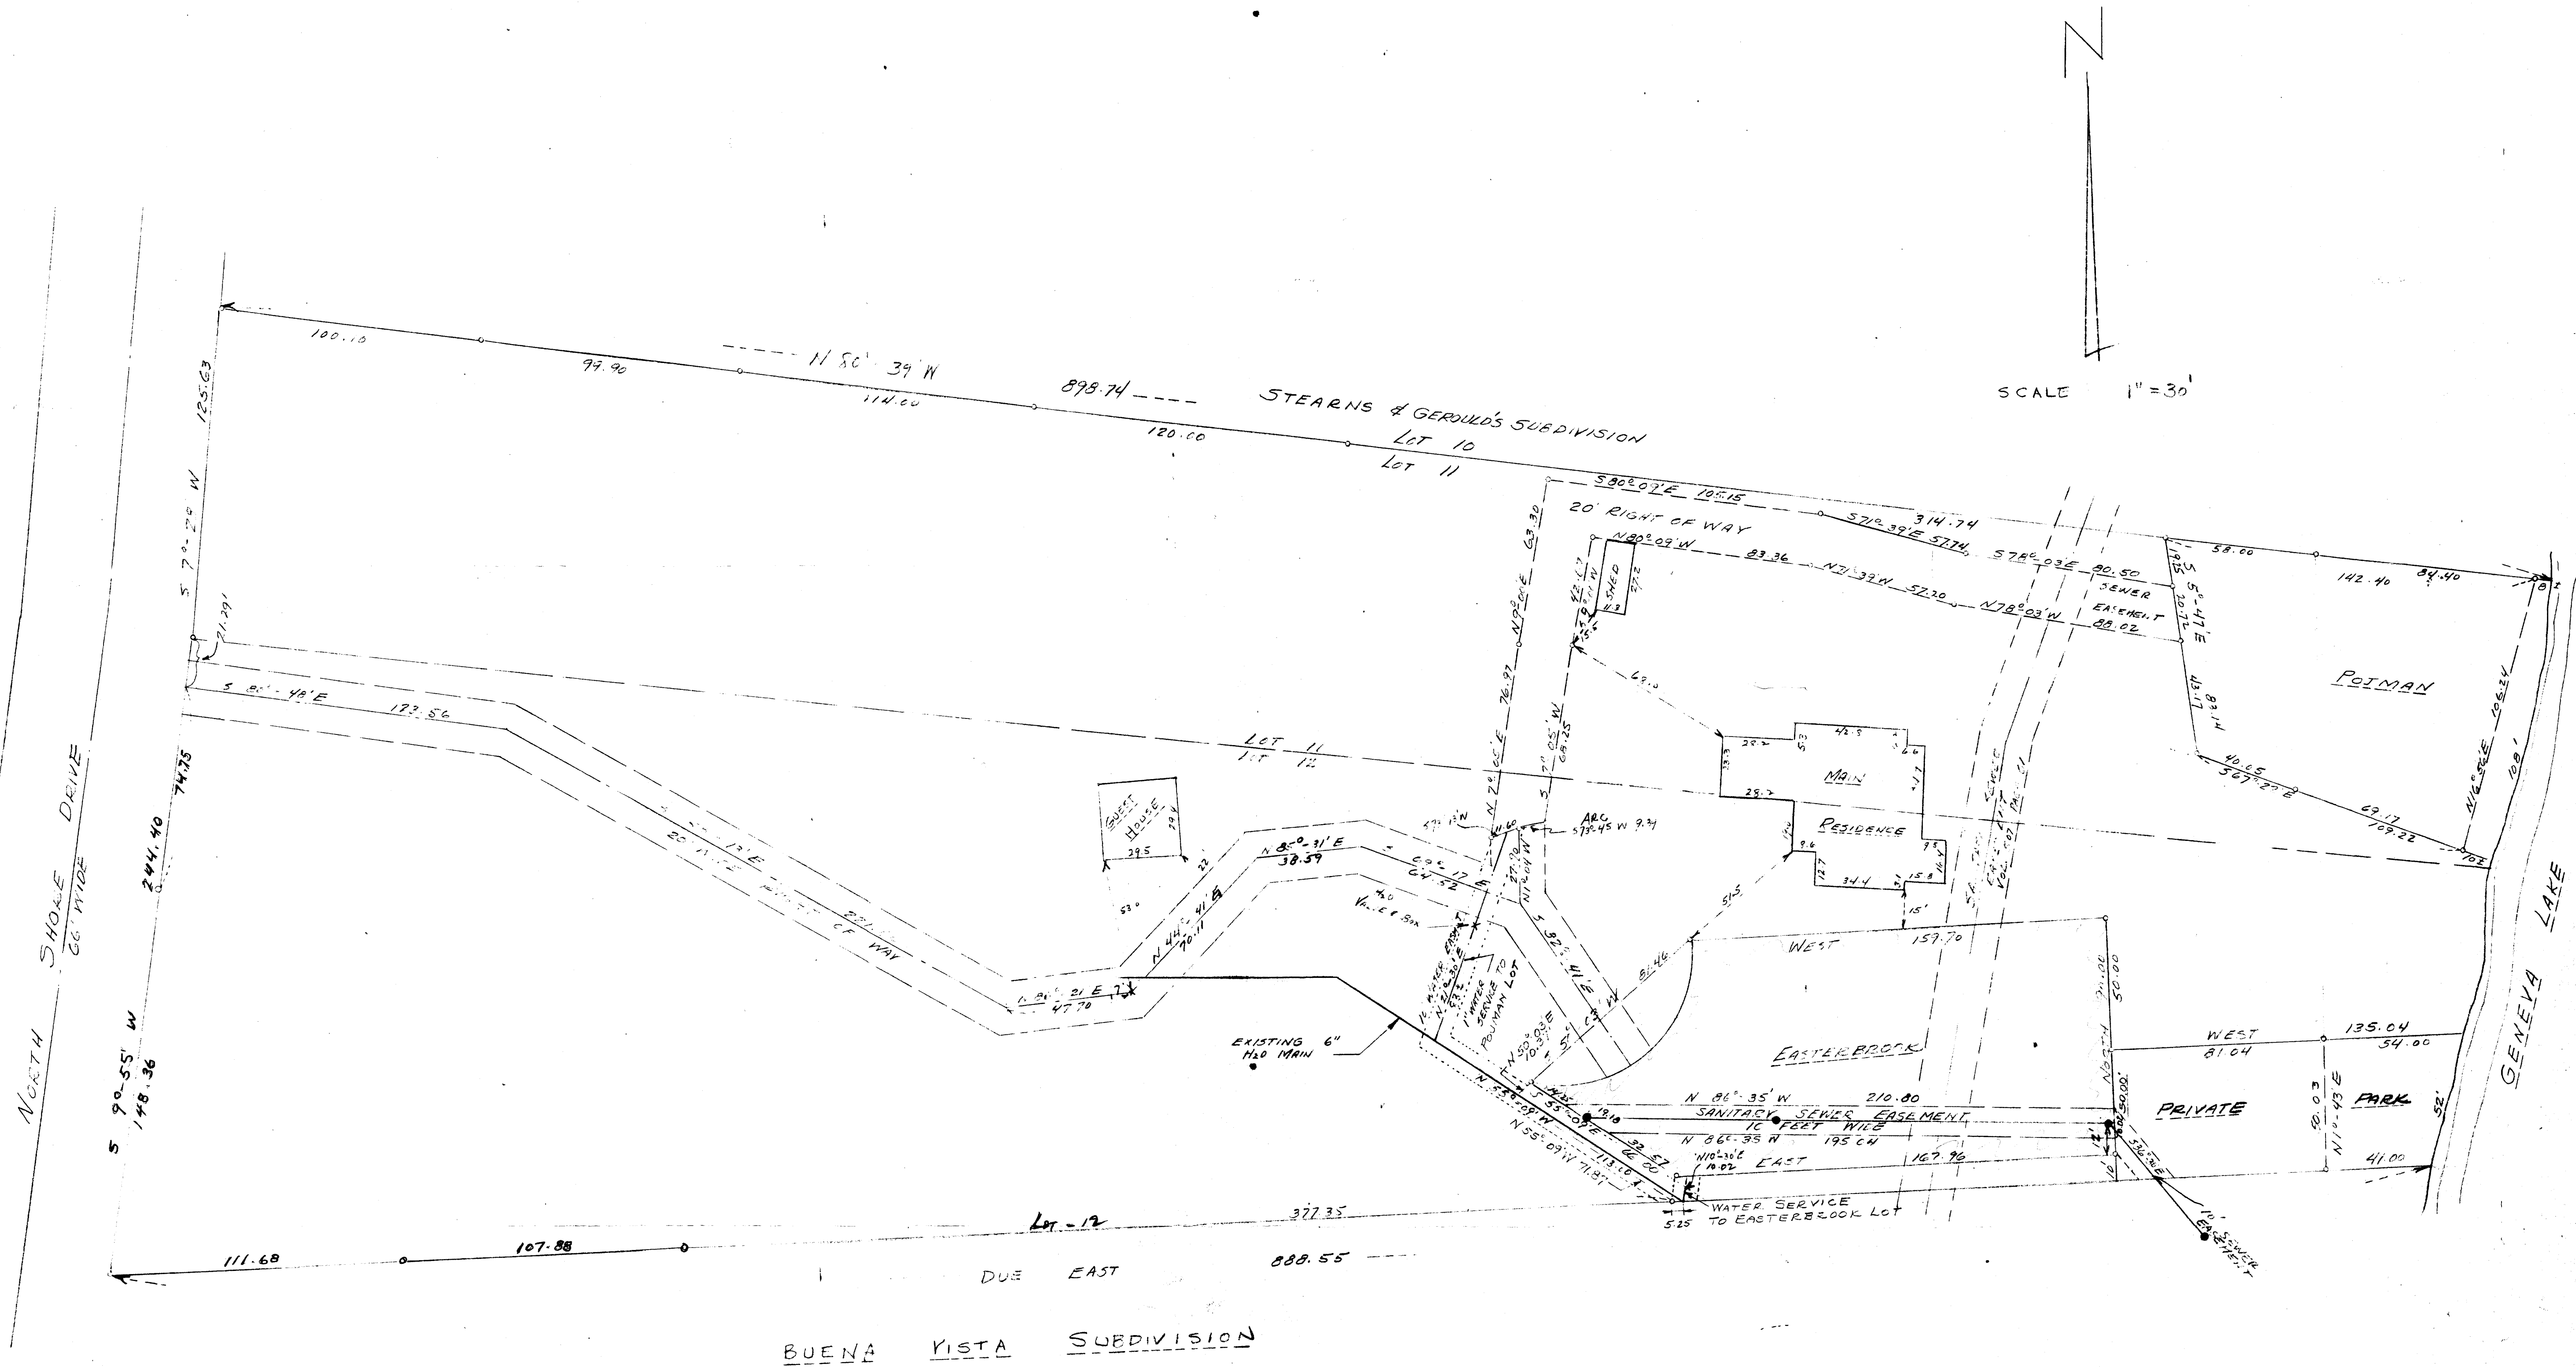

WE CERTIFY THAT WE HAVE SURVEYED THE ABOVE DESCRIBED PROPERTY AND THAT THE ABOVE PLAT IS AN ACCURATE SURVEY AND A TRUE REPRESENTATION THEREOF AND CORRECTLY SHOWS THE EXTERIOR BOUNDARY LINES AND LOCATION OF BUILDINGS AND OTHER IMPROVEMENTS, AND ROADS, DRIVEWAYS, AND OTHER APPARENT EASEMENTS ON SAID PROPERTY AND THE CORRECT MEASUREMENTS THEREOF.

DEC. 12, 1967

BY: *Clayton F. Jensen*
JENSEN & JOHNSON

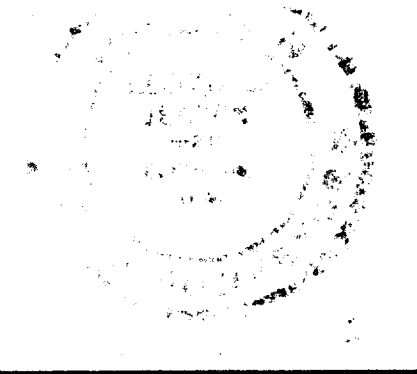

LOTS 11 - 12 STEARNS & GEROULD'S SUBDIVISION - SW 1/4 SECTION 11, T1N-R16E WALWORTH COUNTY, WIS.		
DRAWN BY GBW	JENSEN & JOHNSON CIVIL ENGINEERS ELKHORN, WIS. DATE NOV 8, 1967	SCALE: 1" = 30'
CHECKED BY <i>Clayton F. Jensen</i>		REVISED
APPROVED BY		SHEET NO. OF