


HAROLD H. KOLB

REGISTERED PROFESSIONAL LAND SURVEYOR
LAKE GENEVA, WISCONSIN

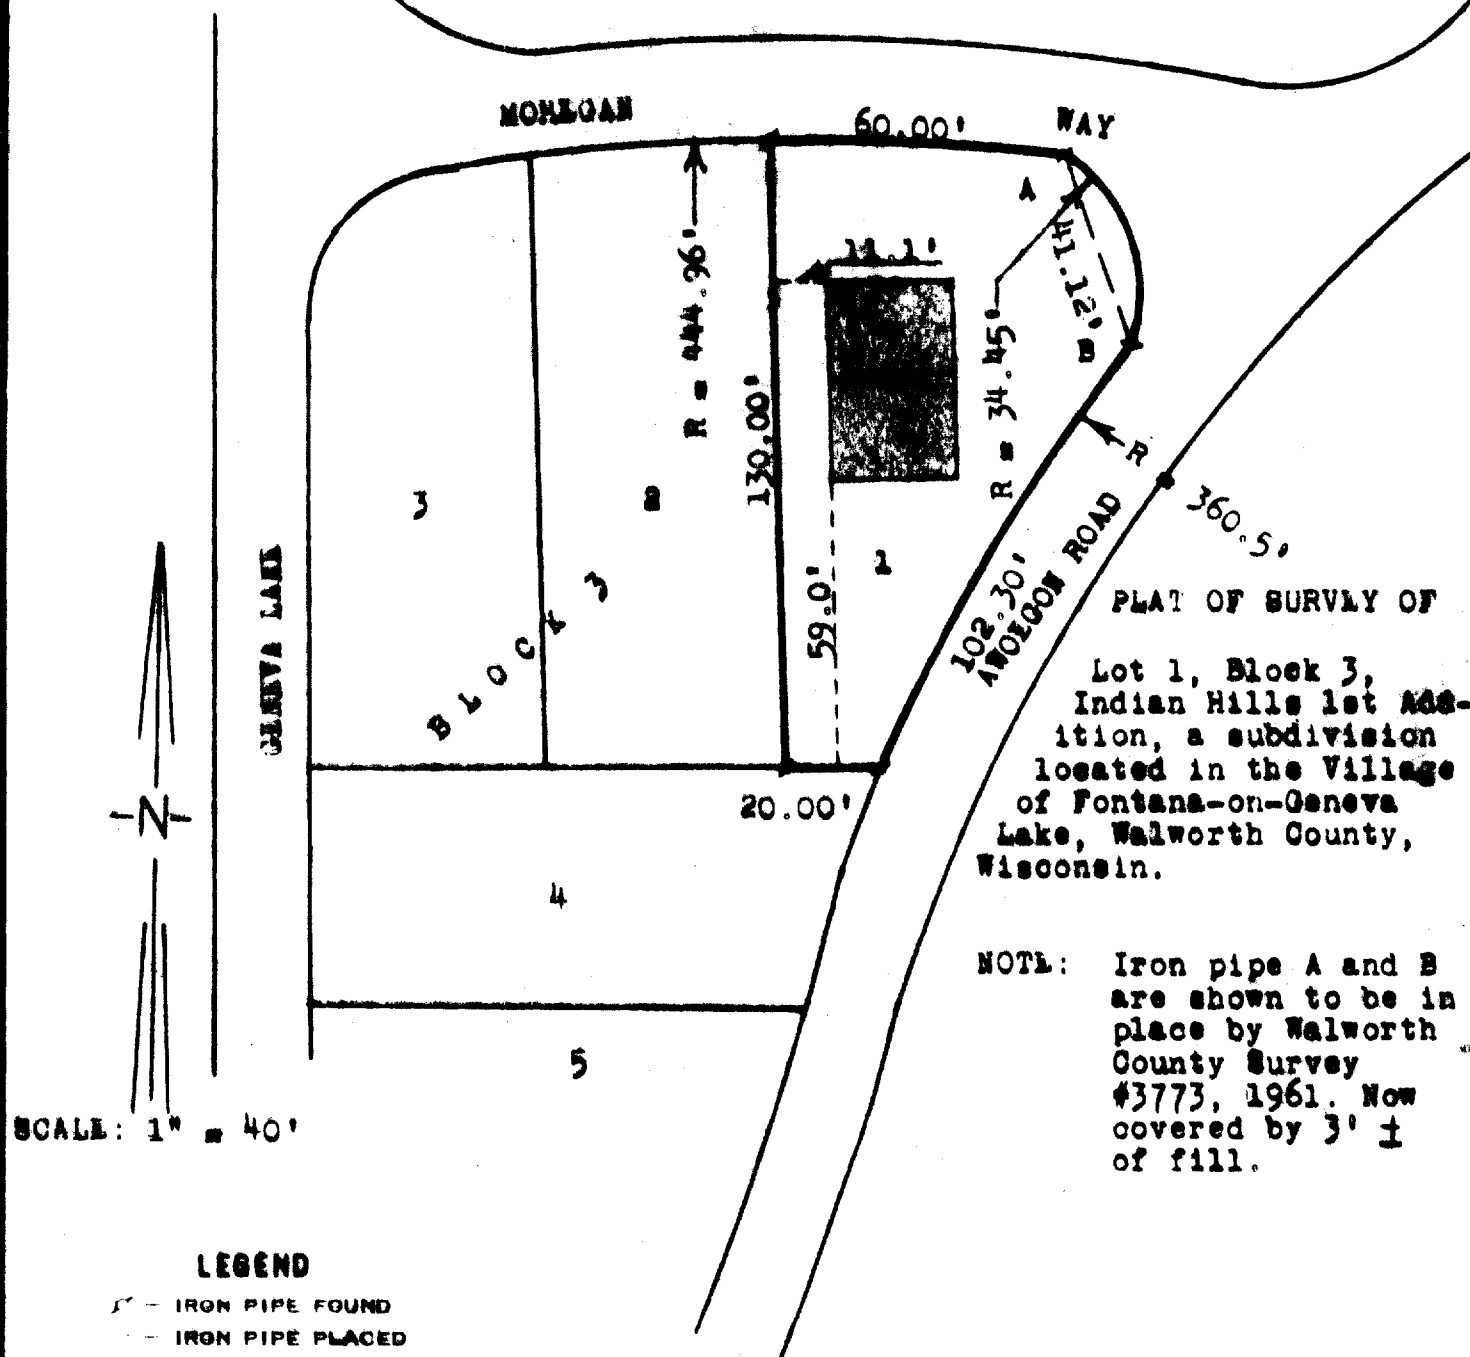

NOTE: Iron pipe A and B
are shown to be in
place by Walworth
County Survey
#3773, 1961. Now
covered by 3' ±
of fill.

LEGEND

- IRON PIPE FOUND
- IRON PIPE PLACED
- — CONCRETE MONUMENT
- SPIKE

I, HAROLD H. KOLB, DO HEREBY CERTIFY THAT I HAVE
SURVEYED THE PROPERTY HEREON DESCRIBED ACCORDING
TO THE OFFICIAL RECORDS, AND THAT THE PLAT HEREON
IS A CORRECT REPRESENTATION OF THE LOT LINES.

Harold H. Kolb
HAROLD H. KOLB
WISCONSIN REGISTERED LAND SURVEYOR, S-187
DATE January 15, 1965

SIHF-22

5-202