

PREPARED FOR : MICHAEL D. FALLS  
91 MEDINAH LN.  
FONTANA WI. 53125

# PLAT OF SURVEY



- OF -

LOT 3, BLOCK 5, ASSESSORS PLAT NO. 1, DOUGLASS  
ADDITION TO THE VILLAGE OF FONTANA, WALWORTH  
COUNTY, WISCONSIN.

J.K. SURVEYING INC.  
N3705 WILLOWBEND LANE  
LAKE GENEVA, WI, 53147  
262-248-3697

C.L. FONTANA AVENUE  
( 66' WIDE ROAD )

FOUND IRON PIPE  
0.31' N 67°11'04" W  
FROM CORNER

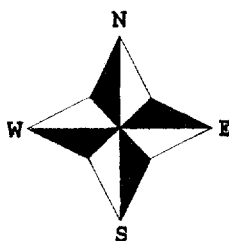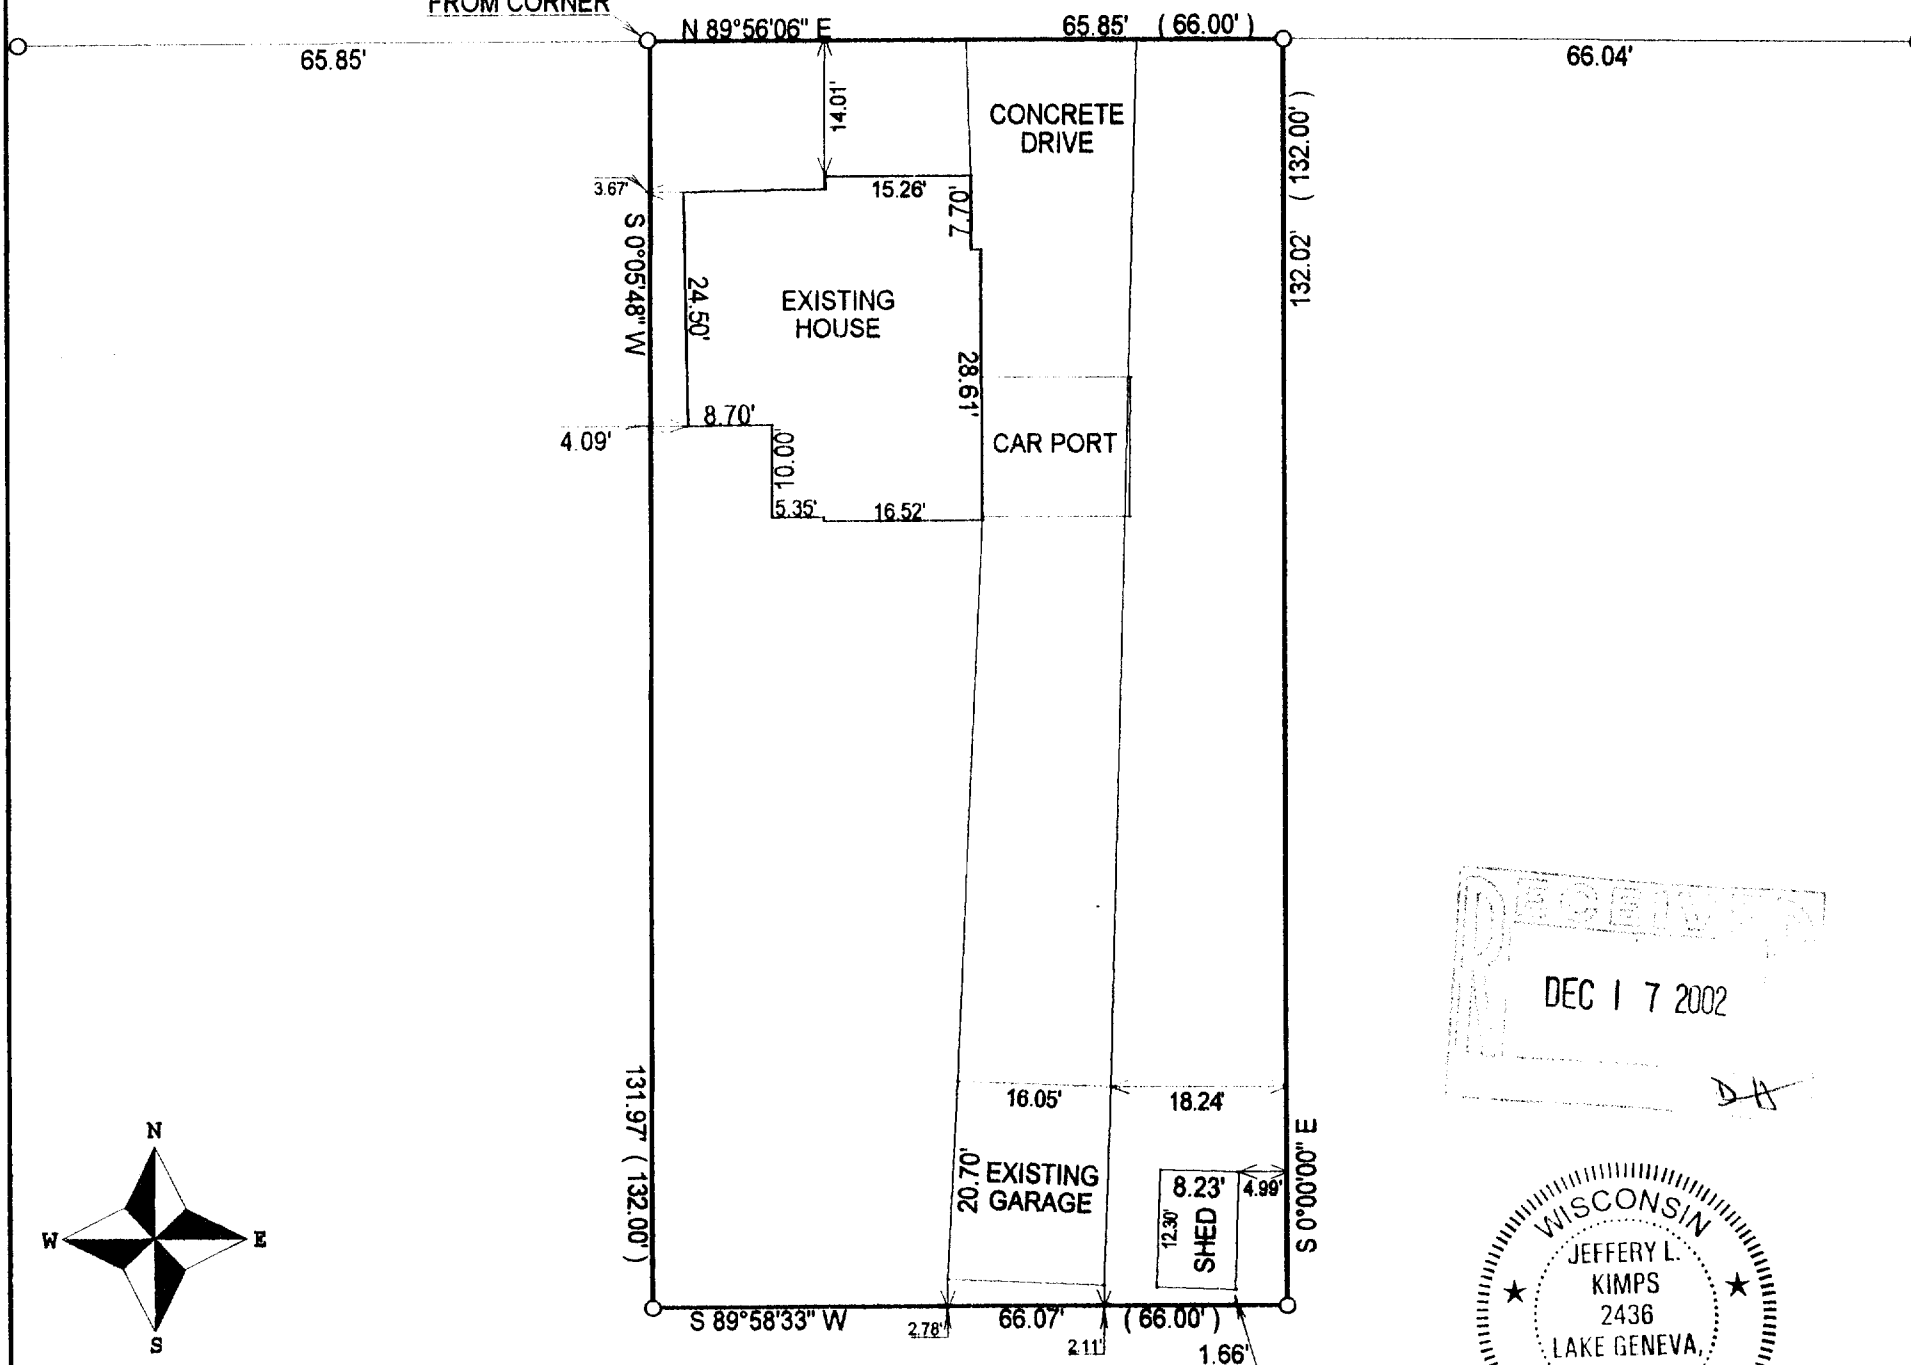

- ( ) = recorded as
- = found iron bar
- = found iron pipe
- = set iron pipe
- = set iron bar

SCALE 1" = 20'

JOB # 02-584

TAX ID # STFV00230



## NOTE : BEARINGS ARE ASSUMED

COMPARE LEGAL DESCRIPTION ABOVE AND DRAWING WITH DEED. FOR BUILDING RESTRICTIONS AND EASEMENTS NOT SHOWN, REFER TO DEED, ABSTRACT SOURCES AND LOCAL MUNICIPAL CODES. NOTIFY THE SURVEYOR IMMEDIATELY OF ANY DISCREPANCY.

"I hereby certify that I have surveyed the above described property and that the above map is a true representation thereof and shows the size and location of all visible structures, apparent easements and encroachments if any."

This survey is made for the present owners of the property, and those who purchase, mortgage, or guarantee the title thereto, within one year from the date hereof.

DATED THIS THE 4th DAY OF NOVEMBER 2002.

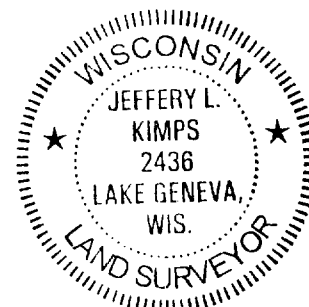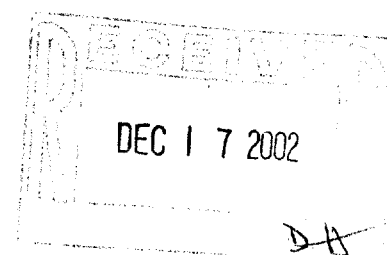

*Jeffery L. Kimps*  
JEFFREY L. KIMPS S - 2436  
Wisconsin Registered Land Surveyor  
( original if signed in red )

V STFV-230  
005-2036