


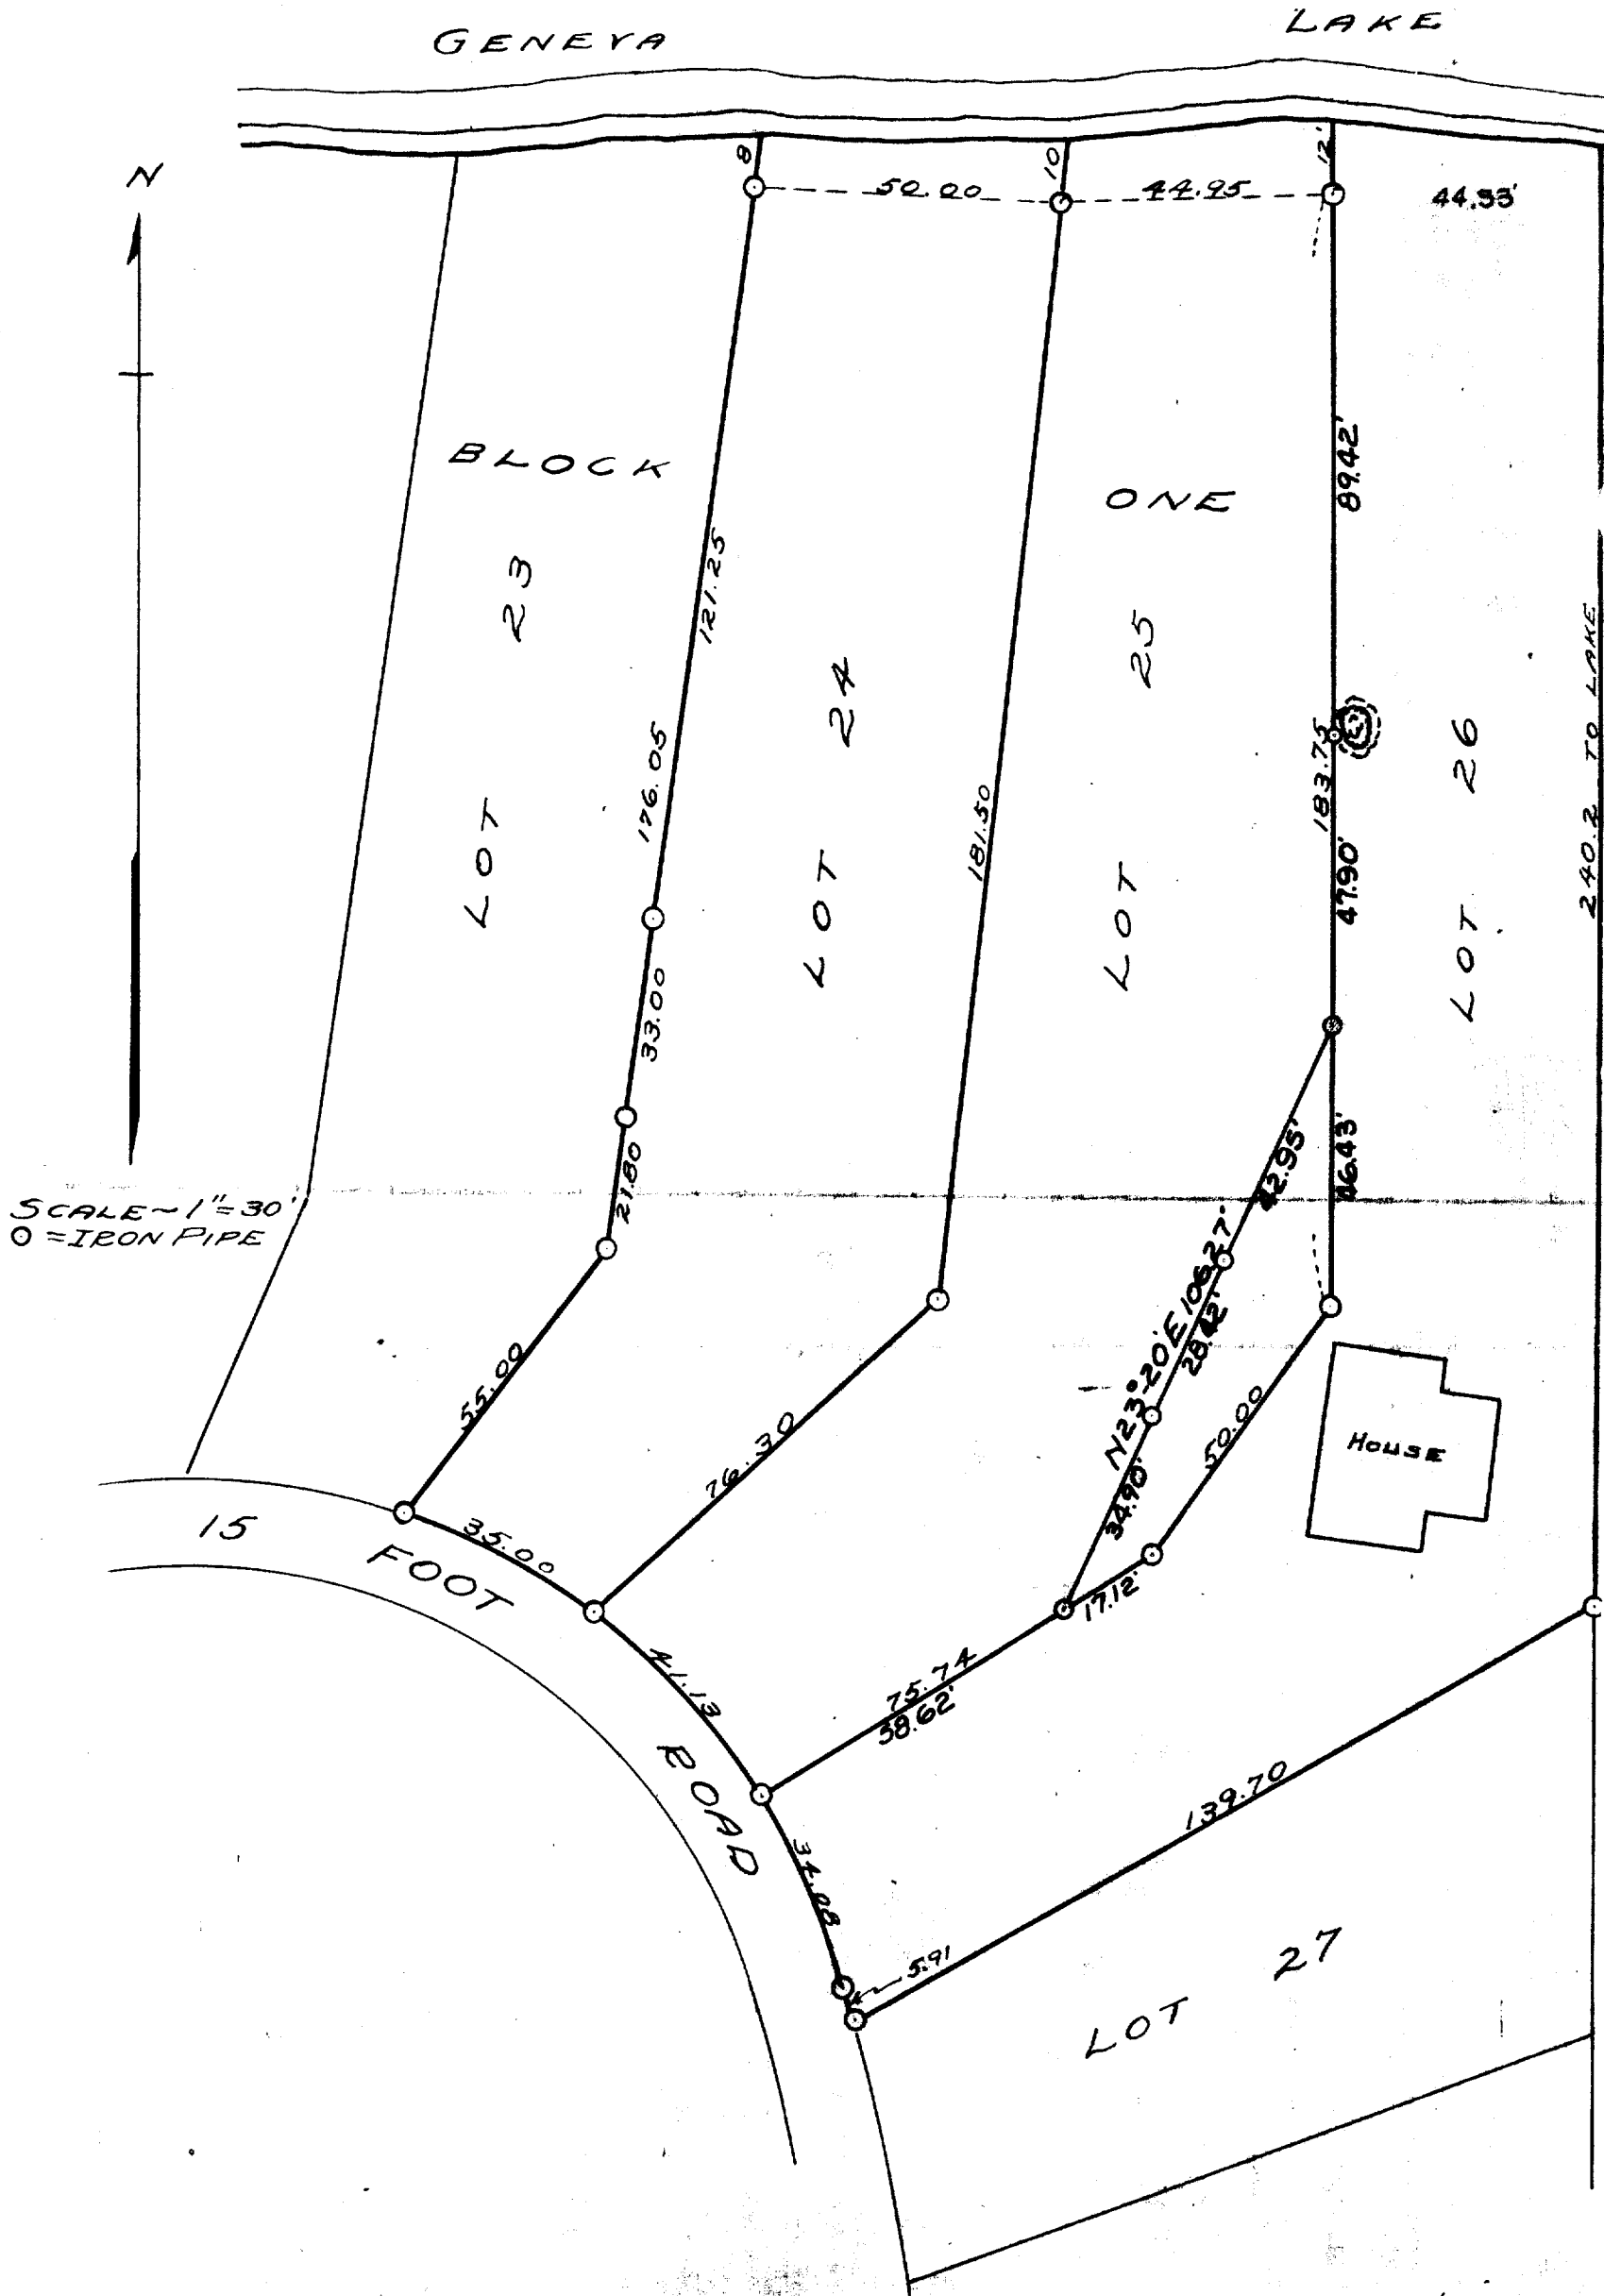

PLAT OF SURVEY OF LOTS 24, 25 & 26
OF BLOCK ONE OF INDIAN HILLS SUBDIVISION,
WALWORTH COUNTY, WISCONSIN.

SEPT. 19, 1939
REVISED JULY 1942 - Lloyd L. Jensen

Lloyd L. Jensen
COUNTY SUPERVISOR
5-205

51H-20A
21
22