


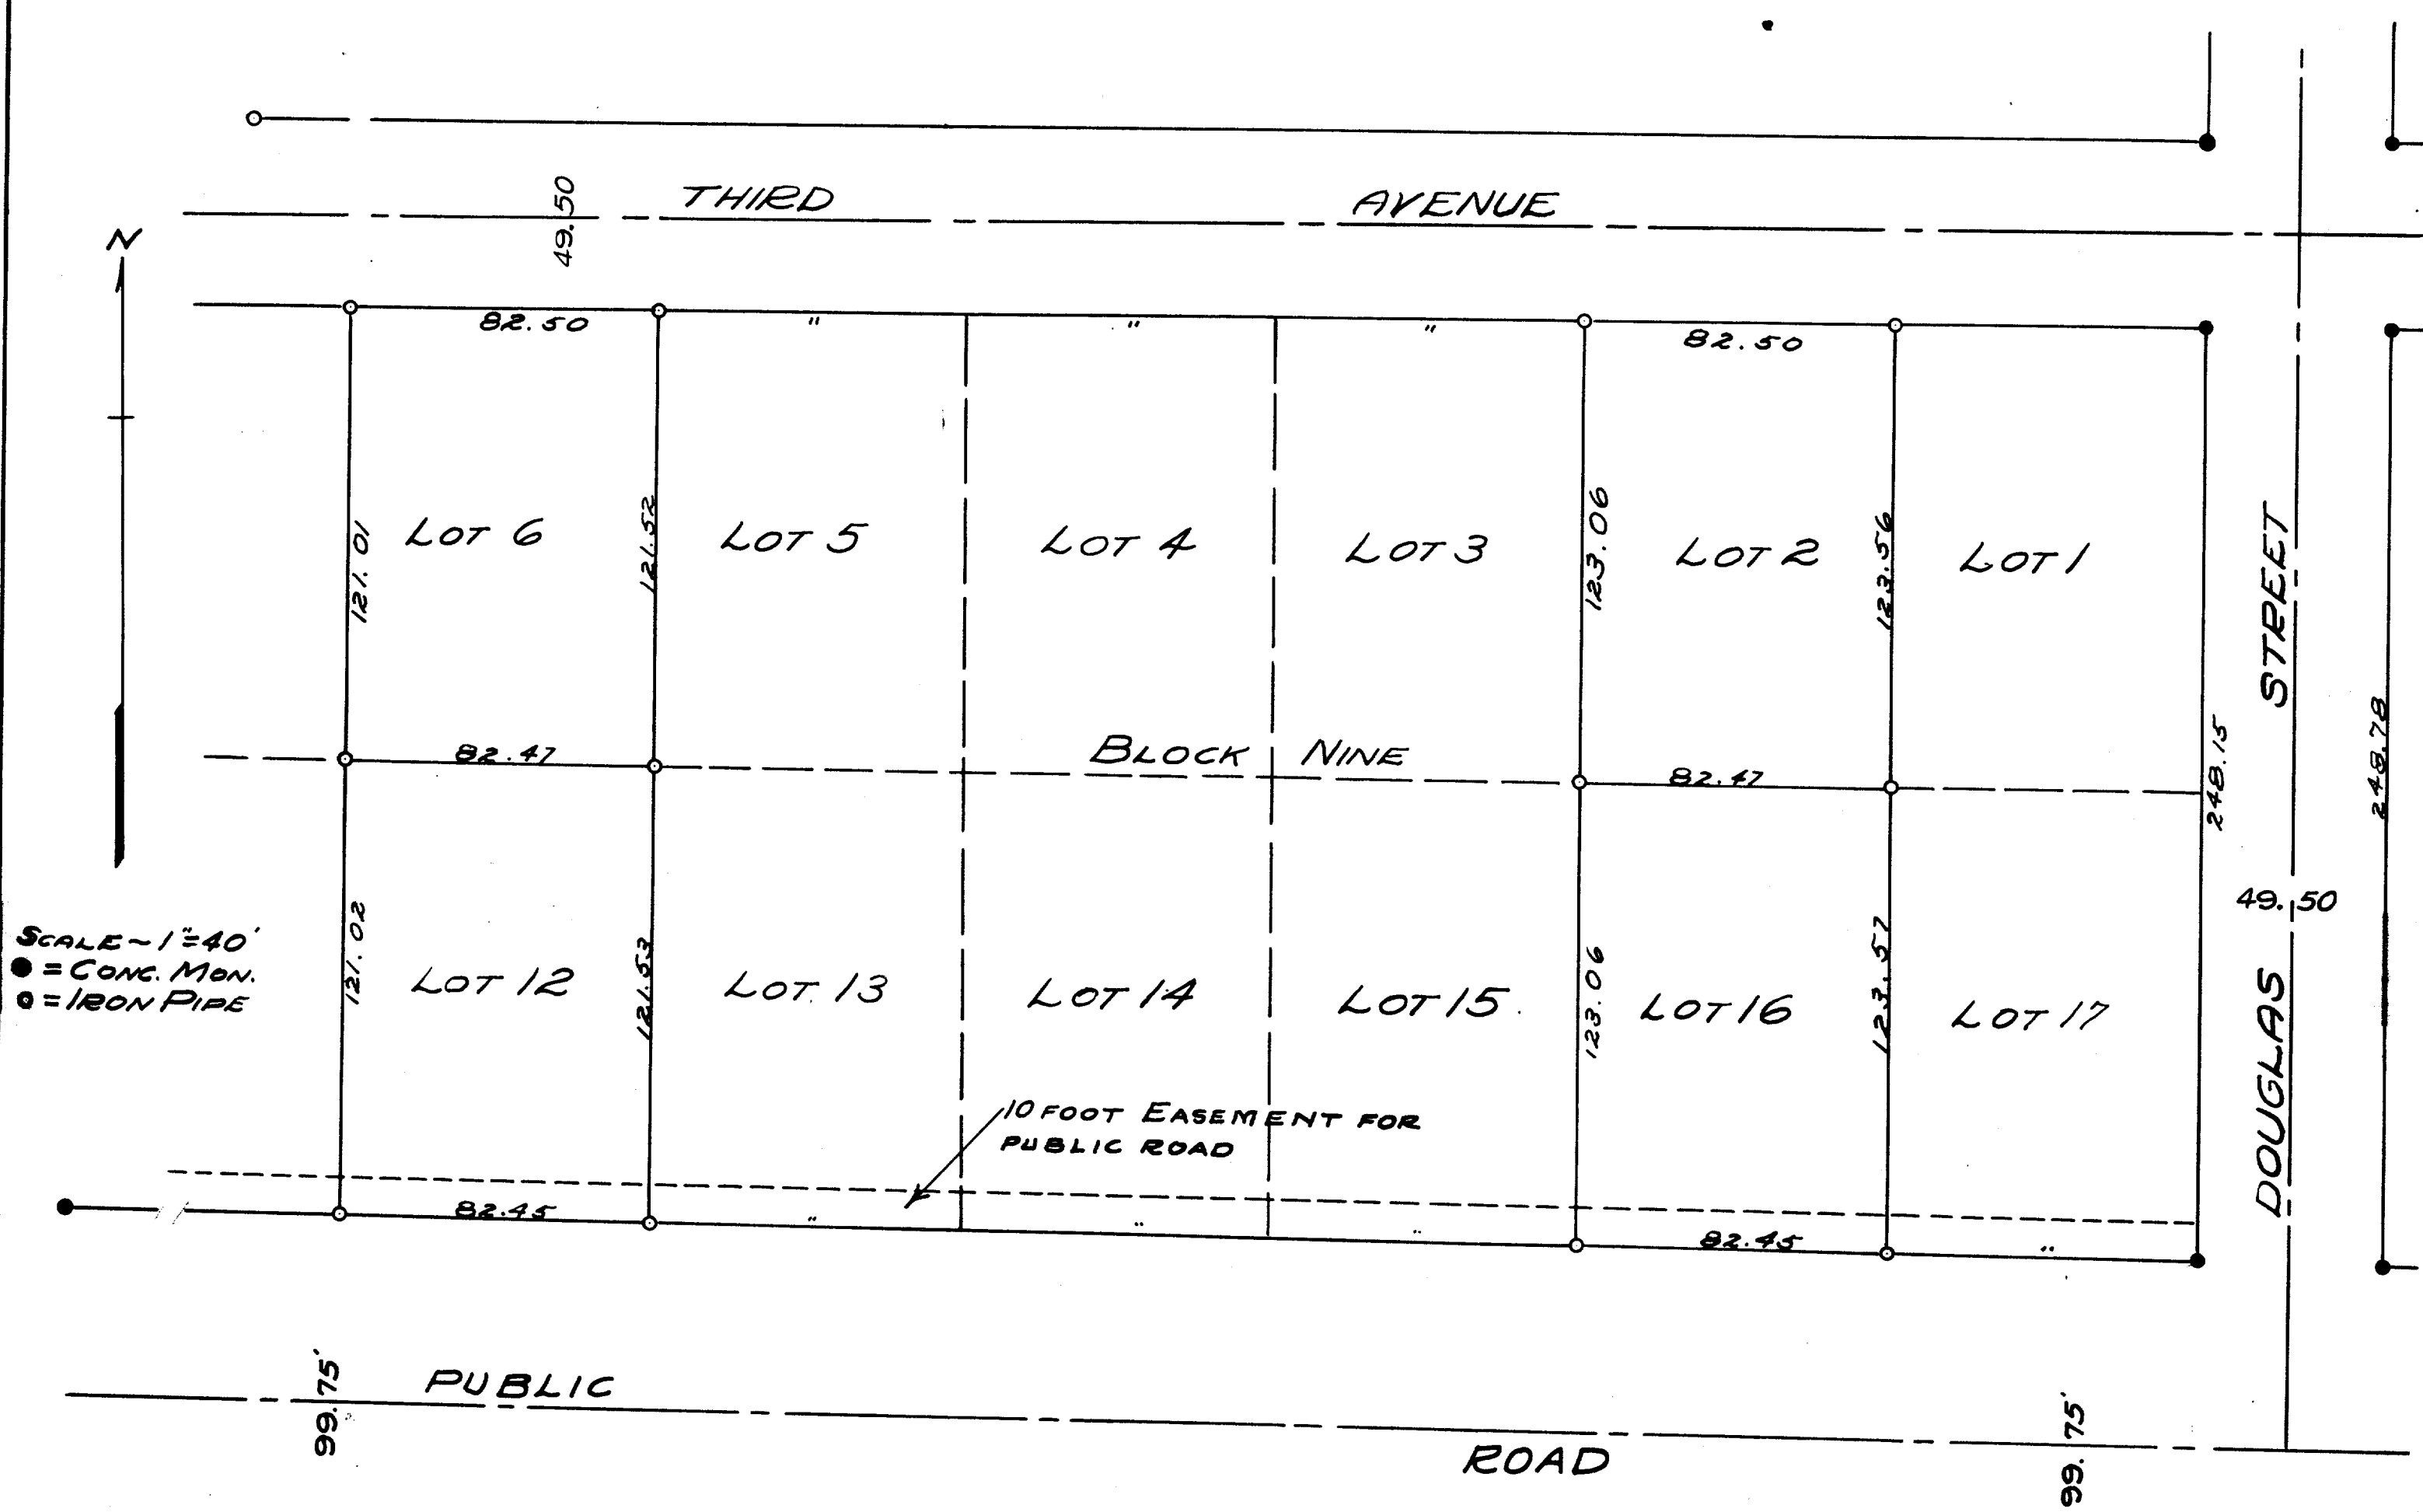

PLAT OF SURVEY OF LOTS 2, 16, 6, AND 12 OF BLOCK
NINE OF THE ORIGINAL VILLAGE OF FONTANA, WALWORTH
COUNTY, WISCONSIN

FEBRUARY, 1939

Floyd Jensen
COUNTY SURVEYOR

15-2046