


GEORGE T. DUNHAM
SURVEYING & SUBDIVIDING
DELAVER, WISCONSIN

N

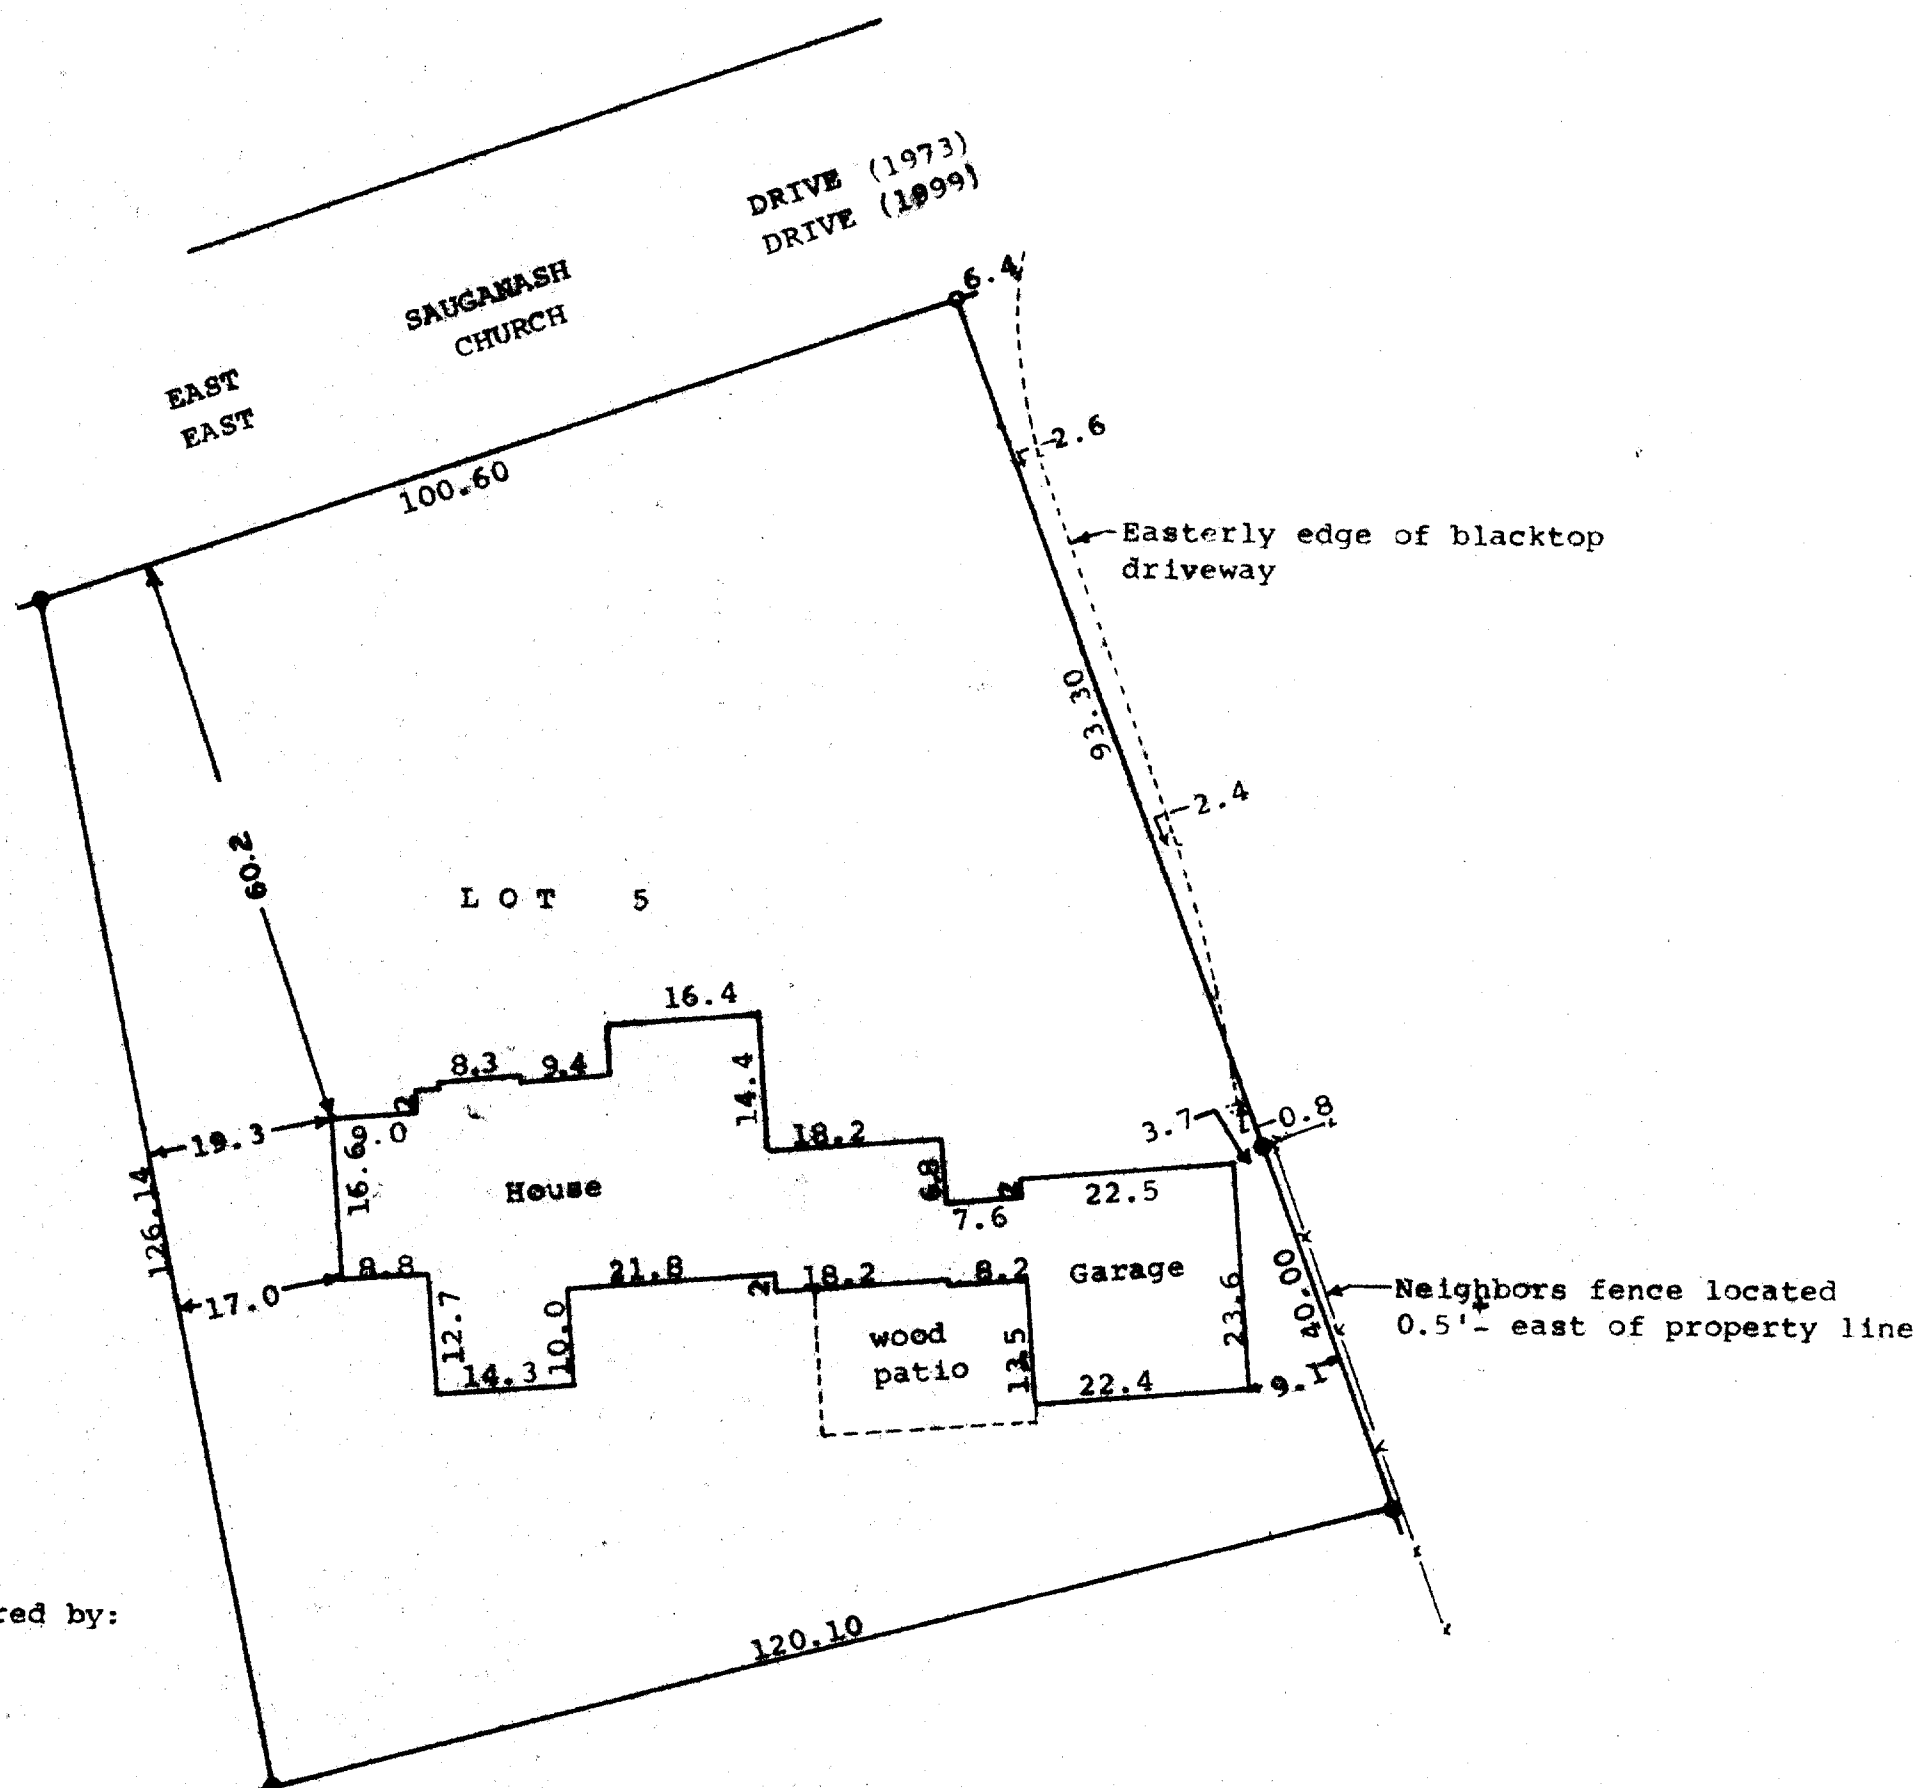

Scale - 1" = 20'

● = Concrete Monument

○ = Iron Pipe

All survey markers relocated

June 18, 1999

Updating and recertification ordered by:

RE/MAX Geneva Realty LTD

101 Broad Street

Lake Geneva, WI 53147

STATE OF WISCONSIN) ss
COUNTY OF WALWORTH)

I, George T. Dunham, Surveyor, certify that I have surveyed the property described as follows, Lot 5 in Block "P" of Unit No. 3 Country Club Estates located in the Village of Fontana, Walworth County, Wisconsin,

and that the plat shown above is an accurate survey and a true representation thereof and correctly shows the exterior boundary lines and location of the buildings on said property and the correct measurements thereof.

March 6, 1973

Updated and recertified to be correct this 18th day of June, 1999

George T. Dunham
George T. Dunham, Surveyor

