


GEORGE T. DUNHAM
SURVEYING & SUBDIVIDING
DELAVER, WISCONSIN

N

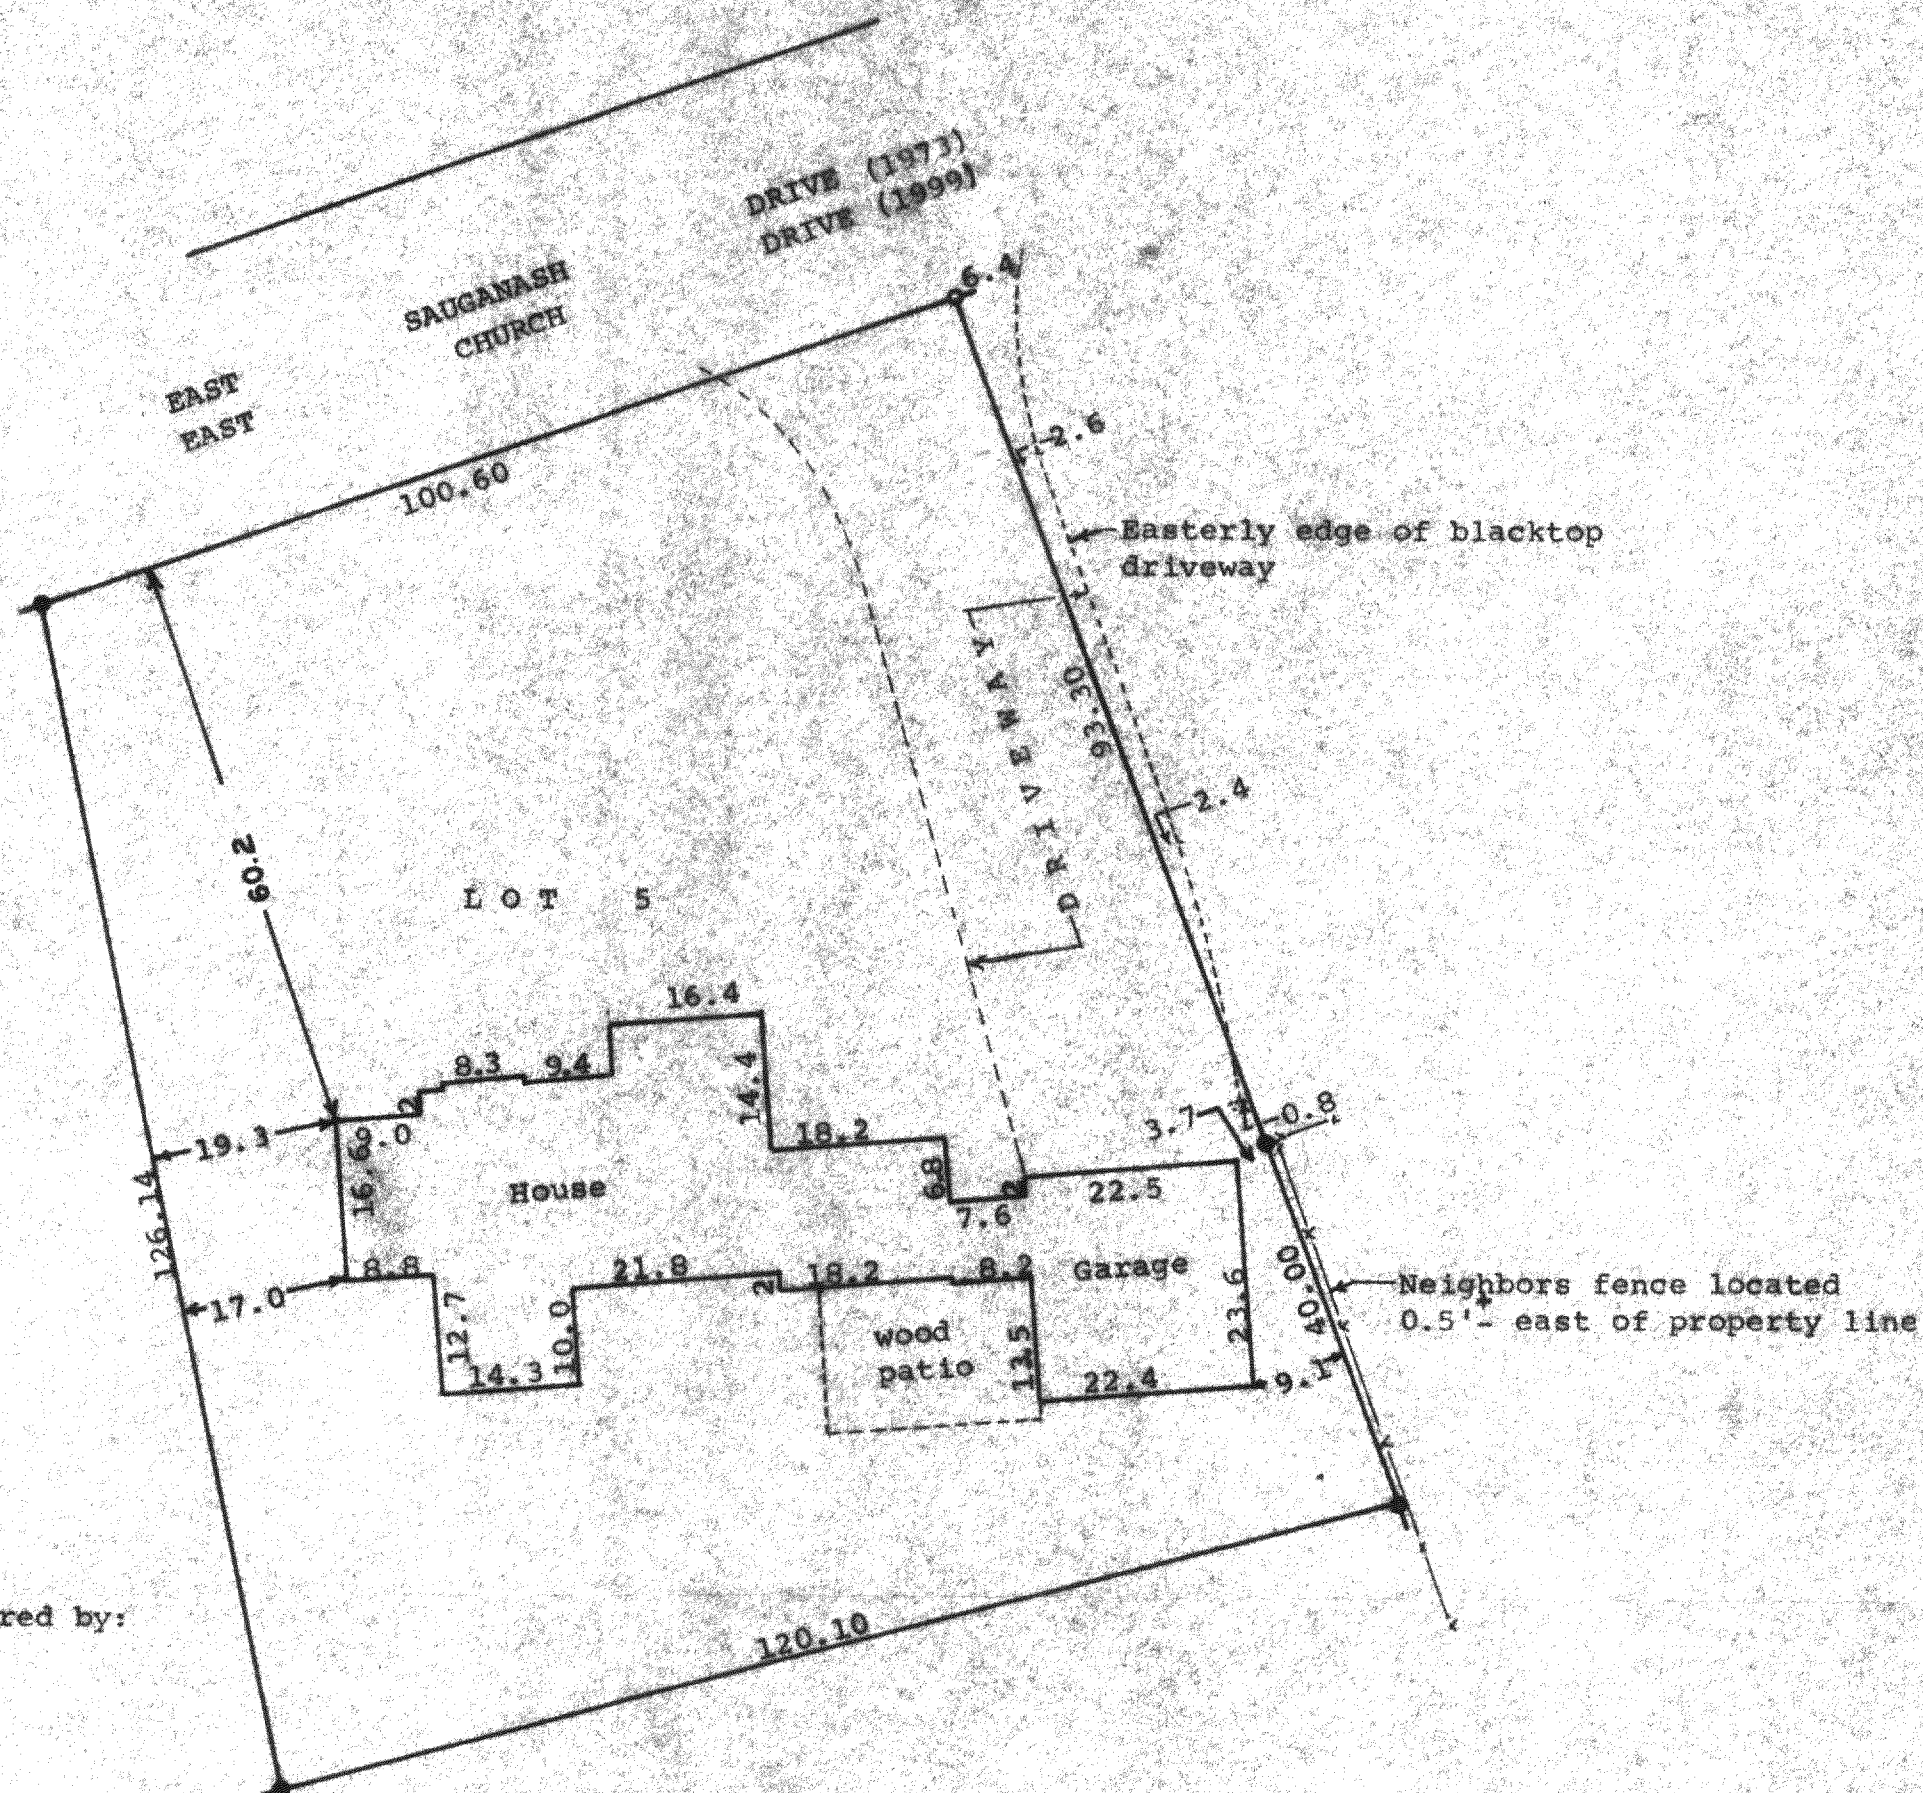

Scale - 1" = 20'

● = Concrete Monument

○ = Iron Pipe

All survey markers relocated
June 18, 1999

Updating and recertification ordered by:
RE/MAX Geneva Realty LTD
101 Broad Street
Lake Geneva, WI 53147

STATE OF WISCONSIN) SS
COUNTY OF WALWORTH)

I, George T. Dunham, Surveyor, certify that I have surveyed the property described as follows:
Lot 5 in Block "F" of Unit No. 3 Country Club Estates
located in the Village of Fontana, Walworth County,
Wisconsin,

and that the plat shown above is an accurate survey and a true representation thereof and correctly shows the exterior boundary lines and location of the buildings on said property and the correct measurements thereof.

March 6, 1973

Updated and recertified to
be correct this 18th day of
June, 1999

I, further certify that the plat shown hereon is a correct representation thereof and shows the size and location of the property, its exterior boundaries, the location of all visible structures and dimensions of all principal buildings thereon, boundary fences, apparent easements, roadways and visible encroachments, if any, and that I have surveyed the property hereon described, according to the official records, to the best of my knowledge and belief.

July 29, 1999

George T. Dunham
George T. Dunham, Surveyor

George T. Dunham
George T. Dunham, Surveyor

