


DUNHAM SURVEYING, S.C.
SURVEYING & SUBDIVIDING
DELAVER, WISCONSIN 53115

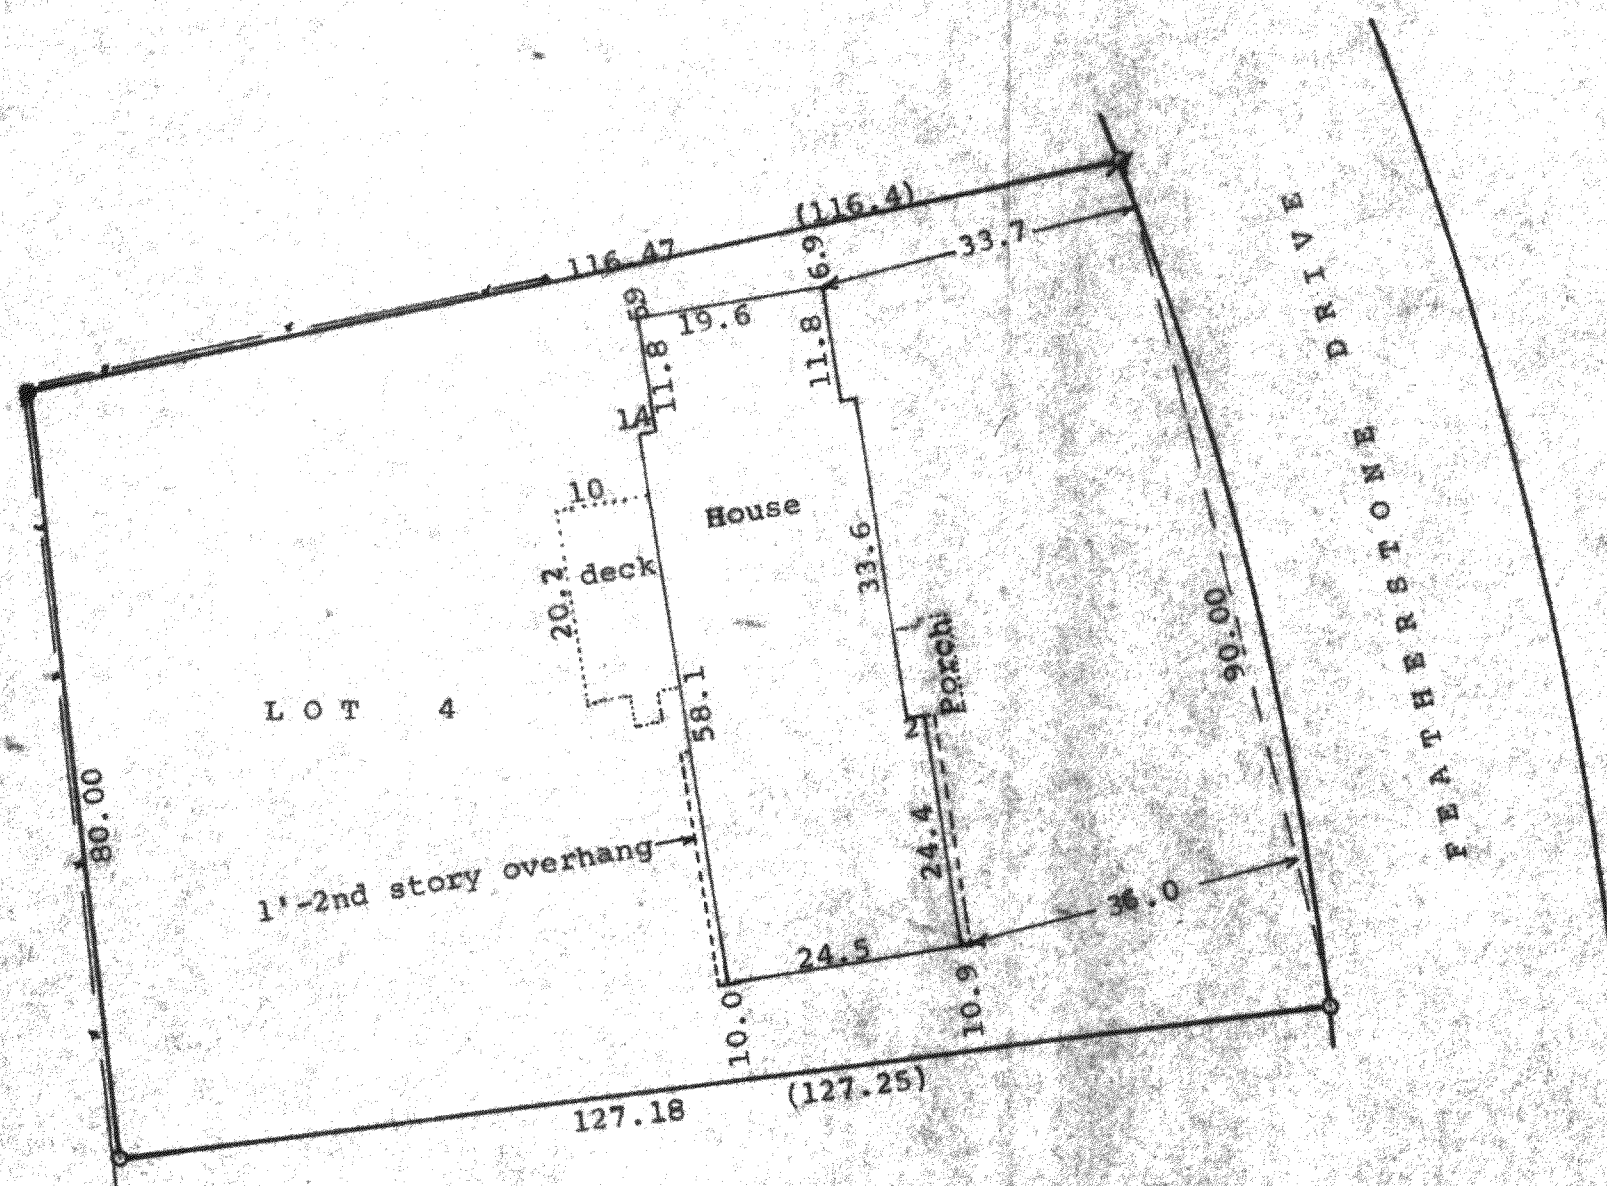

Scale - 1" = 20'
 * = concrete Monument found
 Ø = 1" Iron Pipe Found
 O = 3/4" Iron Pipe Found
 --- = Fence Line
 (0.00) = recorded distance
 Survey ordered by: The Rauland Agency
 118 Kenosha
 Walworth, WI 53184

STATE OF WISCONSIN)
 COUNTY OF WALWORTH) SS

I, George T. Dunham, Surveyor, certify that I have surveyed
 the property described as follows:

Lot 4, Block "E" of Country Club Estates Unit No. 3, located
 in the Village of Fontana-on-Geneva Lake, Walworth County,
 Wisconsin.

and that the plat shown hereon is a correct representation thereof and shows
 the size and location of the property, its exterior boundaries, the location
 of all visible structures and dimensions of all principal buildings thereon,
 boundary fences, apparent easements, roadways and visible encroachments, if
 any, and that I have surveyed the property hereon described, according to the
 official records, to the best of my knowledge and belief.

August 17, 1998

George T. Dunham
 George T. Dunham, Surveyor

