


HAROLD H. KOLB
REGISTERED PROFESSIONAL LAND SURVEYOR
LAKE GENEVA, WISCONSIN

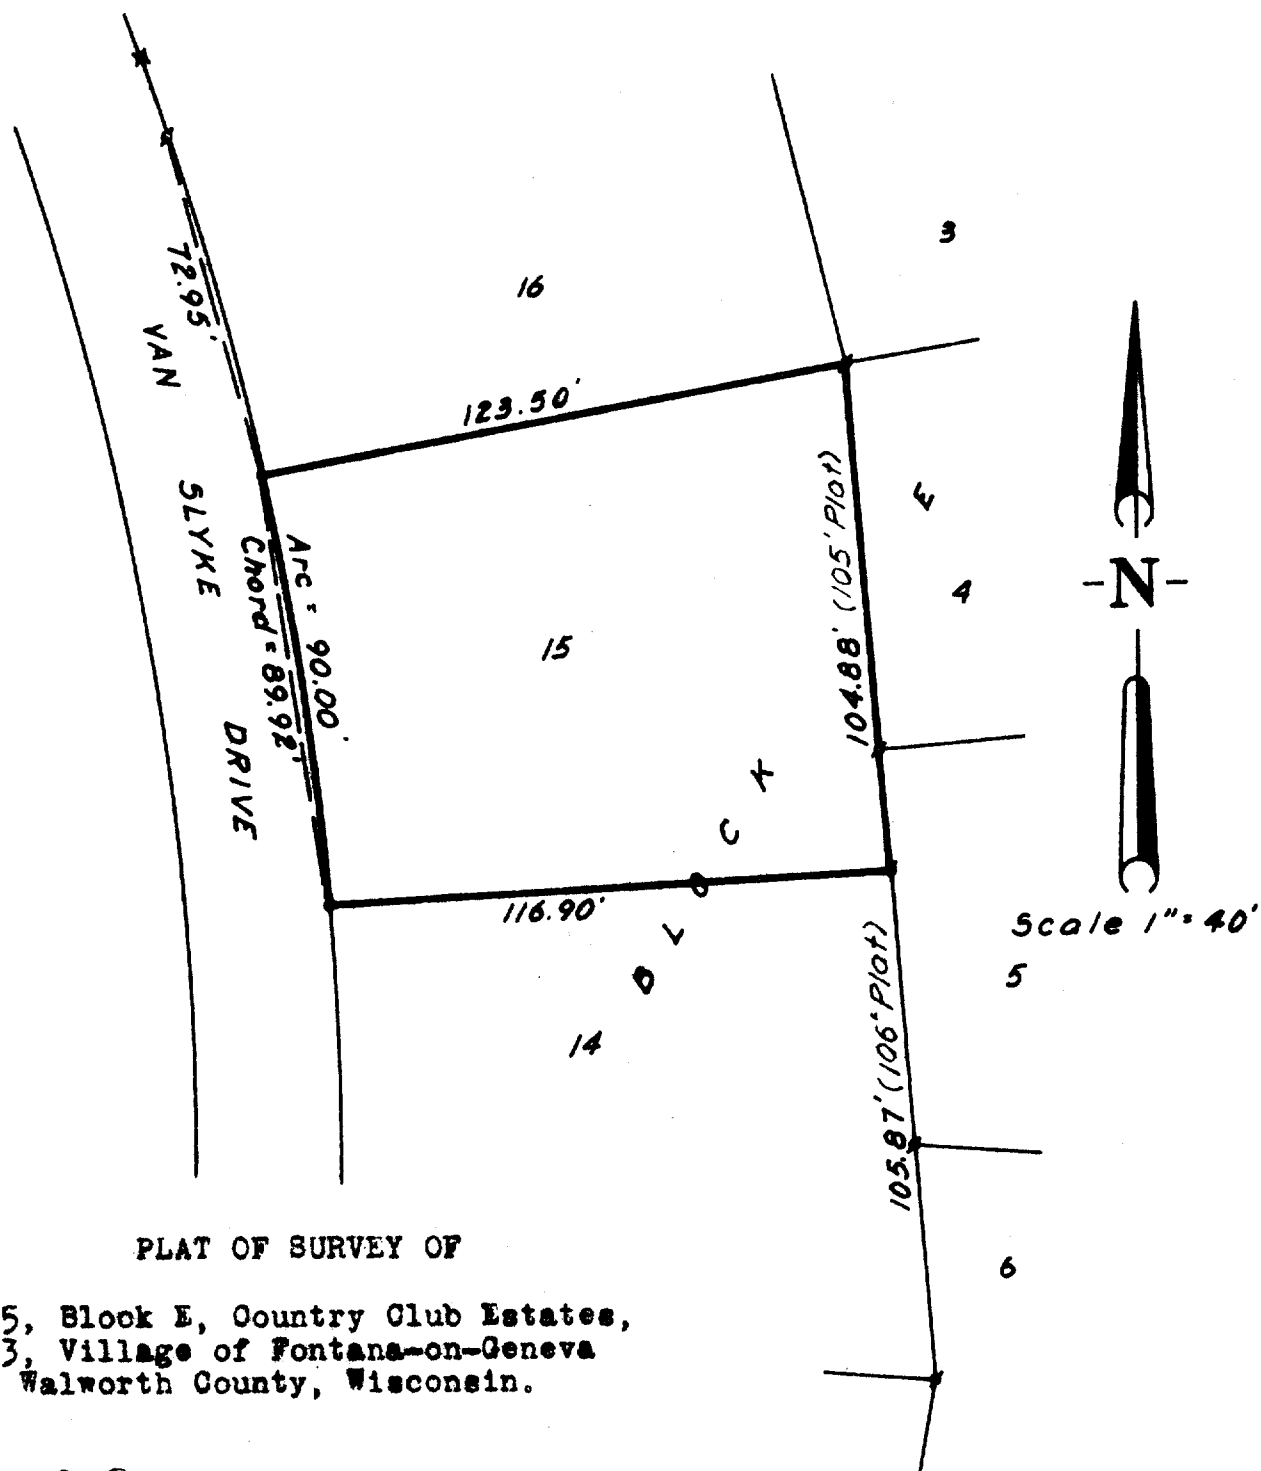

PLAT OF SURVEY OF

Lot 15, Block E, Country Club Estates,
Unit 3, Village of Fontana-on-Geneva
Lake, Walworth County, Wisconsin.

Harold H. Kolb

Harold H. Kolb, Wisconsin Surveyor, S-187
DATE: November 16, 1963

- - Conc. Monument Found
- - Iron Pipe Found
- - Conc. Monument Placed

5-213