

WORK ORDERED BY:  
JOHN ANDERSON  
W4430 BASSWOOD DRIVE  
FONTANA-ON-GENEVA LAKE  
WISCONSIN


FARRIS, HANSEN & ASSOCIATES, INC.  
ENGINEERING - ARCHITECTURE - SURVEYING  
7 RIDGWAY COURT P.O. BOX 437  
ELKHORN, WISCONSIN 53121  
OFFICE: (262) 723-2098 FAX: (262) 723-5886

REVISIONS

PROJECT NO.  
6359  
DATE  
09-09-2003  
SHEET NO.  
1 OF 1

# BOUNDARY & TOPOGRAPHIC SURVEY LOTS 10 & 11 OF BUENA VISTA

A SUBDIVISION LOCATED IN  
THE VILLAGE OF FONTANA-ON-GENEVA LAKE  
WALWORTH COUNTY, WISCONSIN

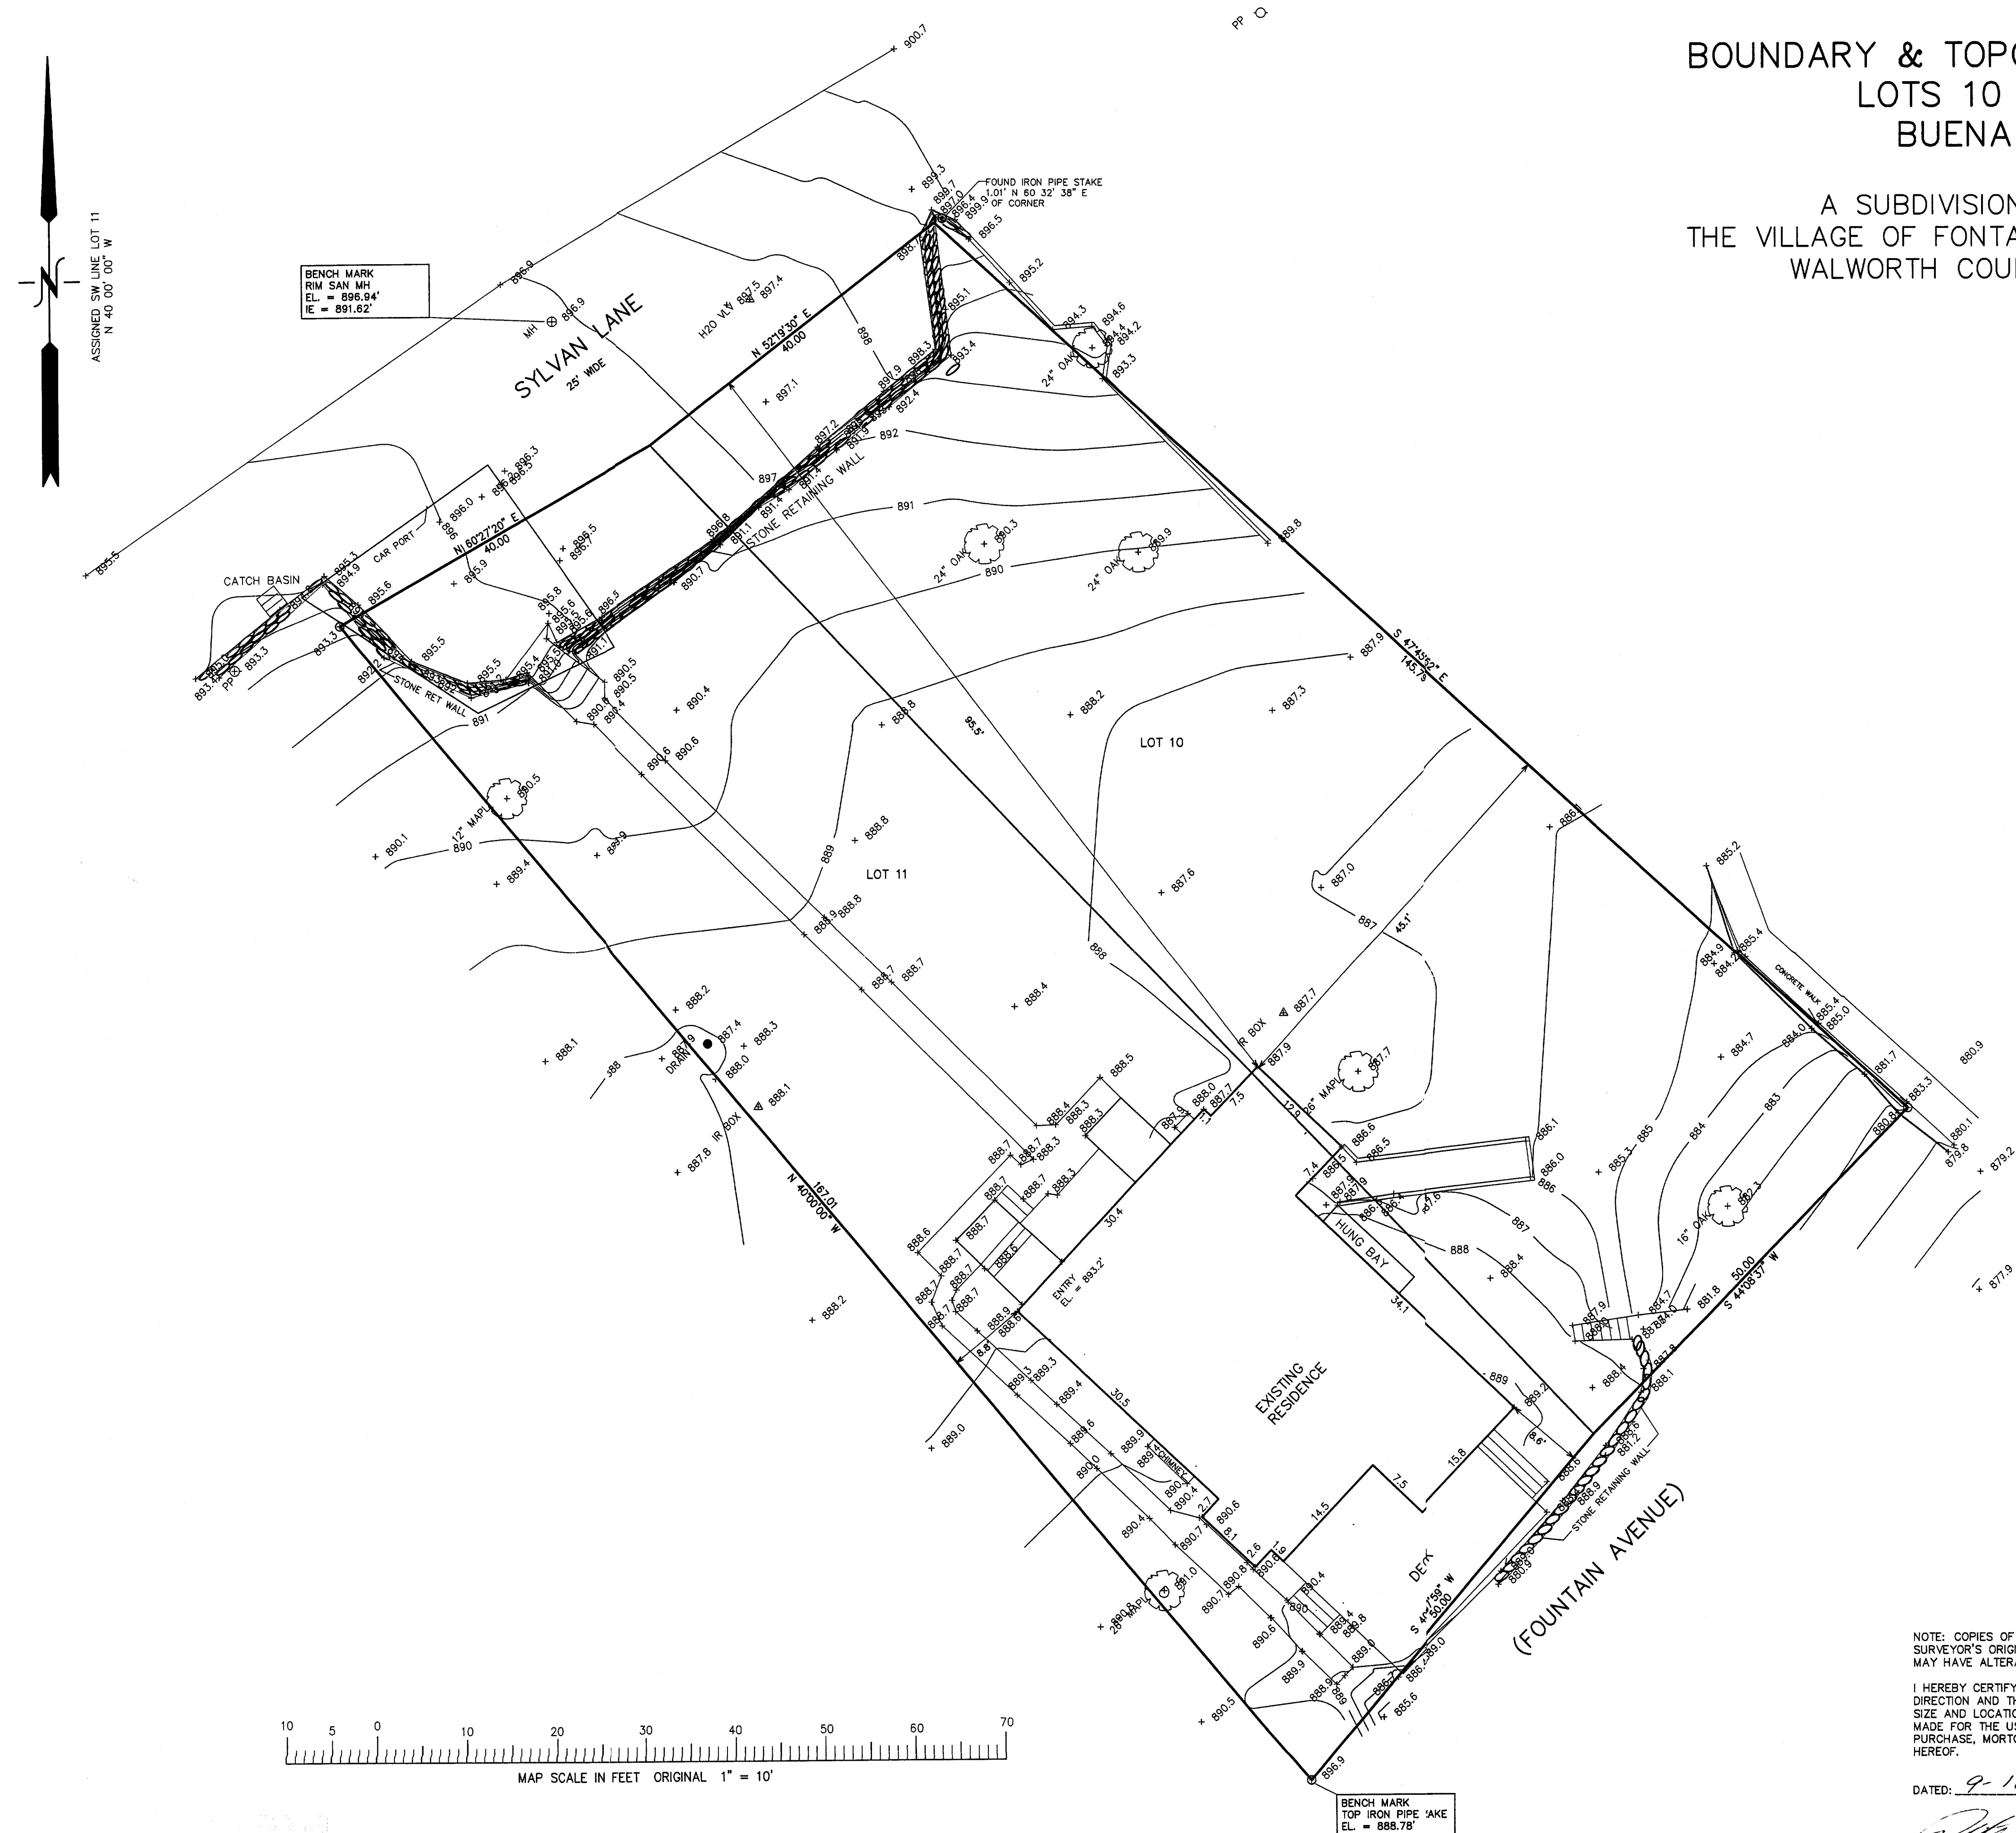

DATED: 9-18-2003

PETER S. GORDON R.L.S. 2101