


PLAT OF SURVEY

LOTS 1 & 2 OF CERTIFIED SURVEY MAP NO. 661
REC. IN VOL. 3 ON PG. 147 AS DOC. NO. 16208

LOCATED IN THE SW 1/4 OF SECTION 11,
TOWN 1 NORTH, RANGE 16 EAST,
VILLAGE OF FONTANA-ON-GENEVA LAKE,
WALWORTH COUNTY, WISCONSIN

ASSIGNED NORTH LINE OF CERTIFIED SURVEY MAP NO. 661
S 79°00'00" E

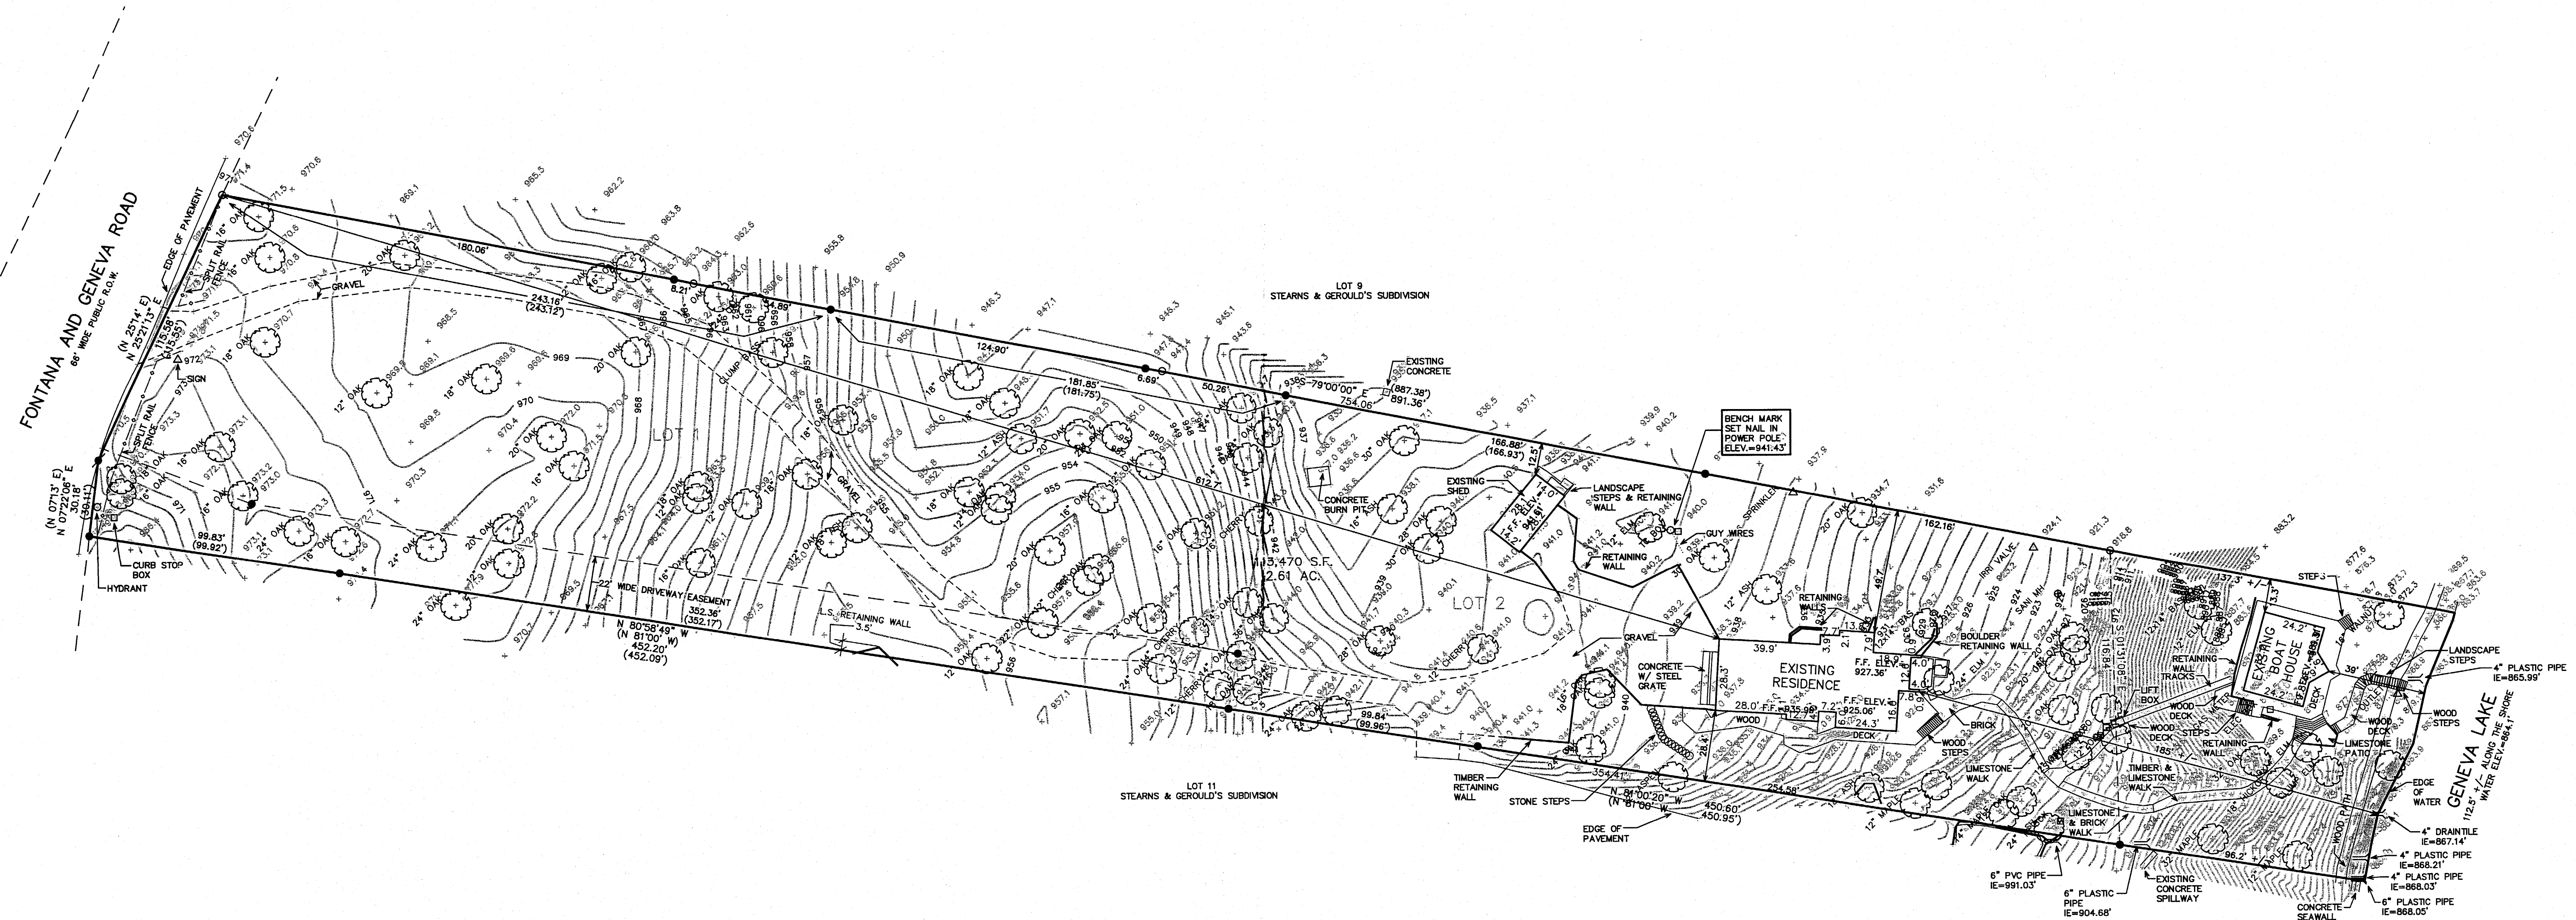

LEGEND
○ = FOUND IRON PIPE STAKE
● = FOUND IRON REBAR STAKE
✱ = SET IRON REBAR STAKE
(XXX) = RECORDED AS

NOTE: COPIES OF THIS MAP TO WHICH THE FOLLOWING CERTIFICATE WILL APPLY SHOW THE SURVEYOR'S ORIGINAL SEAL AND SIGNATURE IN RED INK. COPIES BY ANY OTHER MEANS MAY HAVE ALTERATIONS WHICH DO NOT REPRESENT THE SURVEYOR'S WORK PRODUCT.

I HEREBY CERTIFY THAT THE ABOVE DESCRIBED PROPERTY HAS BEEN SURVEYED UNDER MY DIRECTION AND THAT THE ABOVE MAP IS A TRUE REPRESENTATION THEREOF AND SHOWS THE SIZE AND LOCATION OF THE PROPERTY AND ITS EXTERIOR BOUNDARIES. THIS SURVEY IS MADE FOR THE USE OF THE PRESENT OWNERS OF THE PROPERTY, AND ALSO THOSE WHO PURCHASE, MORTGAGE, OR GUARANTEE THE TITLE THERETO WITHIN ONE YEAR FROM THE DATE HEREOF.

DATED: DECEMBER 4, 2003

Peter S. Gordon
PETER S. GORDON R.L.S. 2101

MAP SCALE IN FEET ORIGINAL 1" = 30'

WORK ORDERED BY -
BILL HUCK
3 CONCORD DRIVE
OAKBROOK, IL 60523

FARRIS, HANSEN & ASSOCIATES, INC.
ENGINEERING - ARCHITECTURE - SURVEYING
7 RICHWAY COURT P.O. BOX 437
ELKHORN, WISCONSIN 53121
OFFICE: (262) 723-2098 FAX: (262) 723-5866


REVISIONS

PROJECT NO.
6425
DATE
12/01/2003
SHEET NO.
1 OF 1

DETAILED MAPPING

LOT 2 OF CERTIFIED SURVEY MAP NO. 661
REC. IN VOL. 3 ON PG. 147 AS DOC. NO. 16208

LOCATED IN THE SW 1/4 OF SECTION 11,
TOWN 1 NORTH, RANGE 16 EAST,
VILLAGE OF FONTANA-ON-GENEVA LAKE,
WALWORTH COUNTY, WISCONSIN


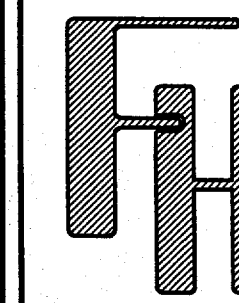


WORK ORDERED BY -
FARRIS, HANSEN & ASSOCIATES, INC.
3 CONCORD DRIVE
OAKBROOK, IL 60523

FARRIS, HANSEN & ASSOCIATES, INC.
ENGINEERING - ARCHITECTURE - SURVEYING
7 RIDGEWAY COURT, P.O. BOX 437
ELKHORN, WISCONSIN 53121
OFFICE: (262) 723-2098 FAX: (262) 723-5886

REVISIONS

PROJECT NO.
6425
DATE
12/01/03
SHEET NO.
1 OF 1

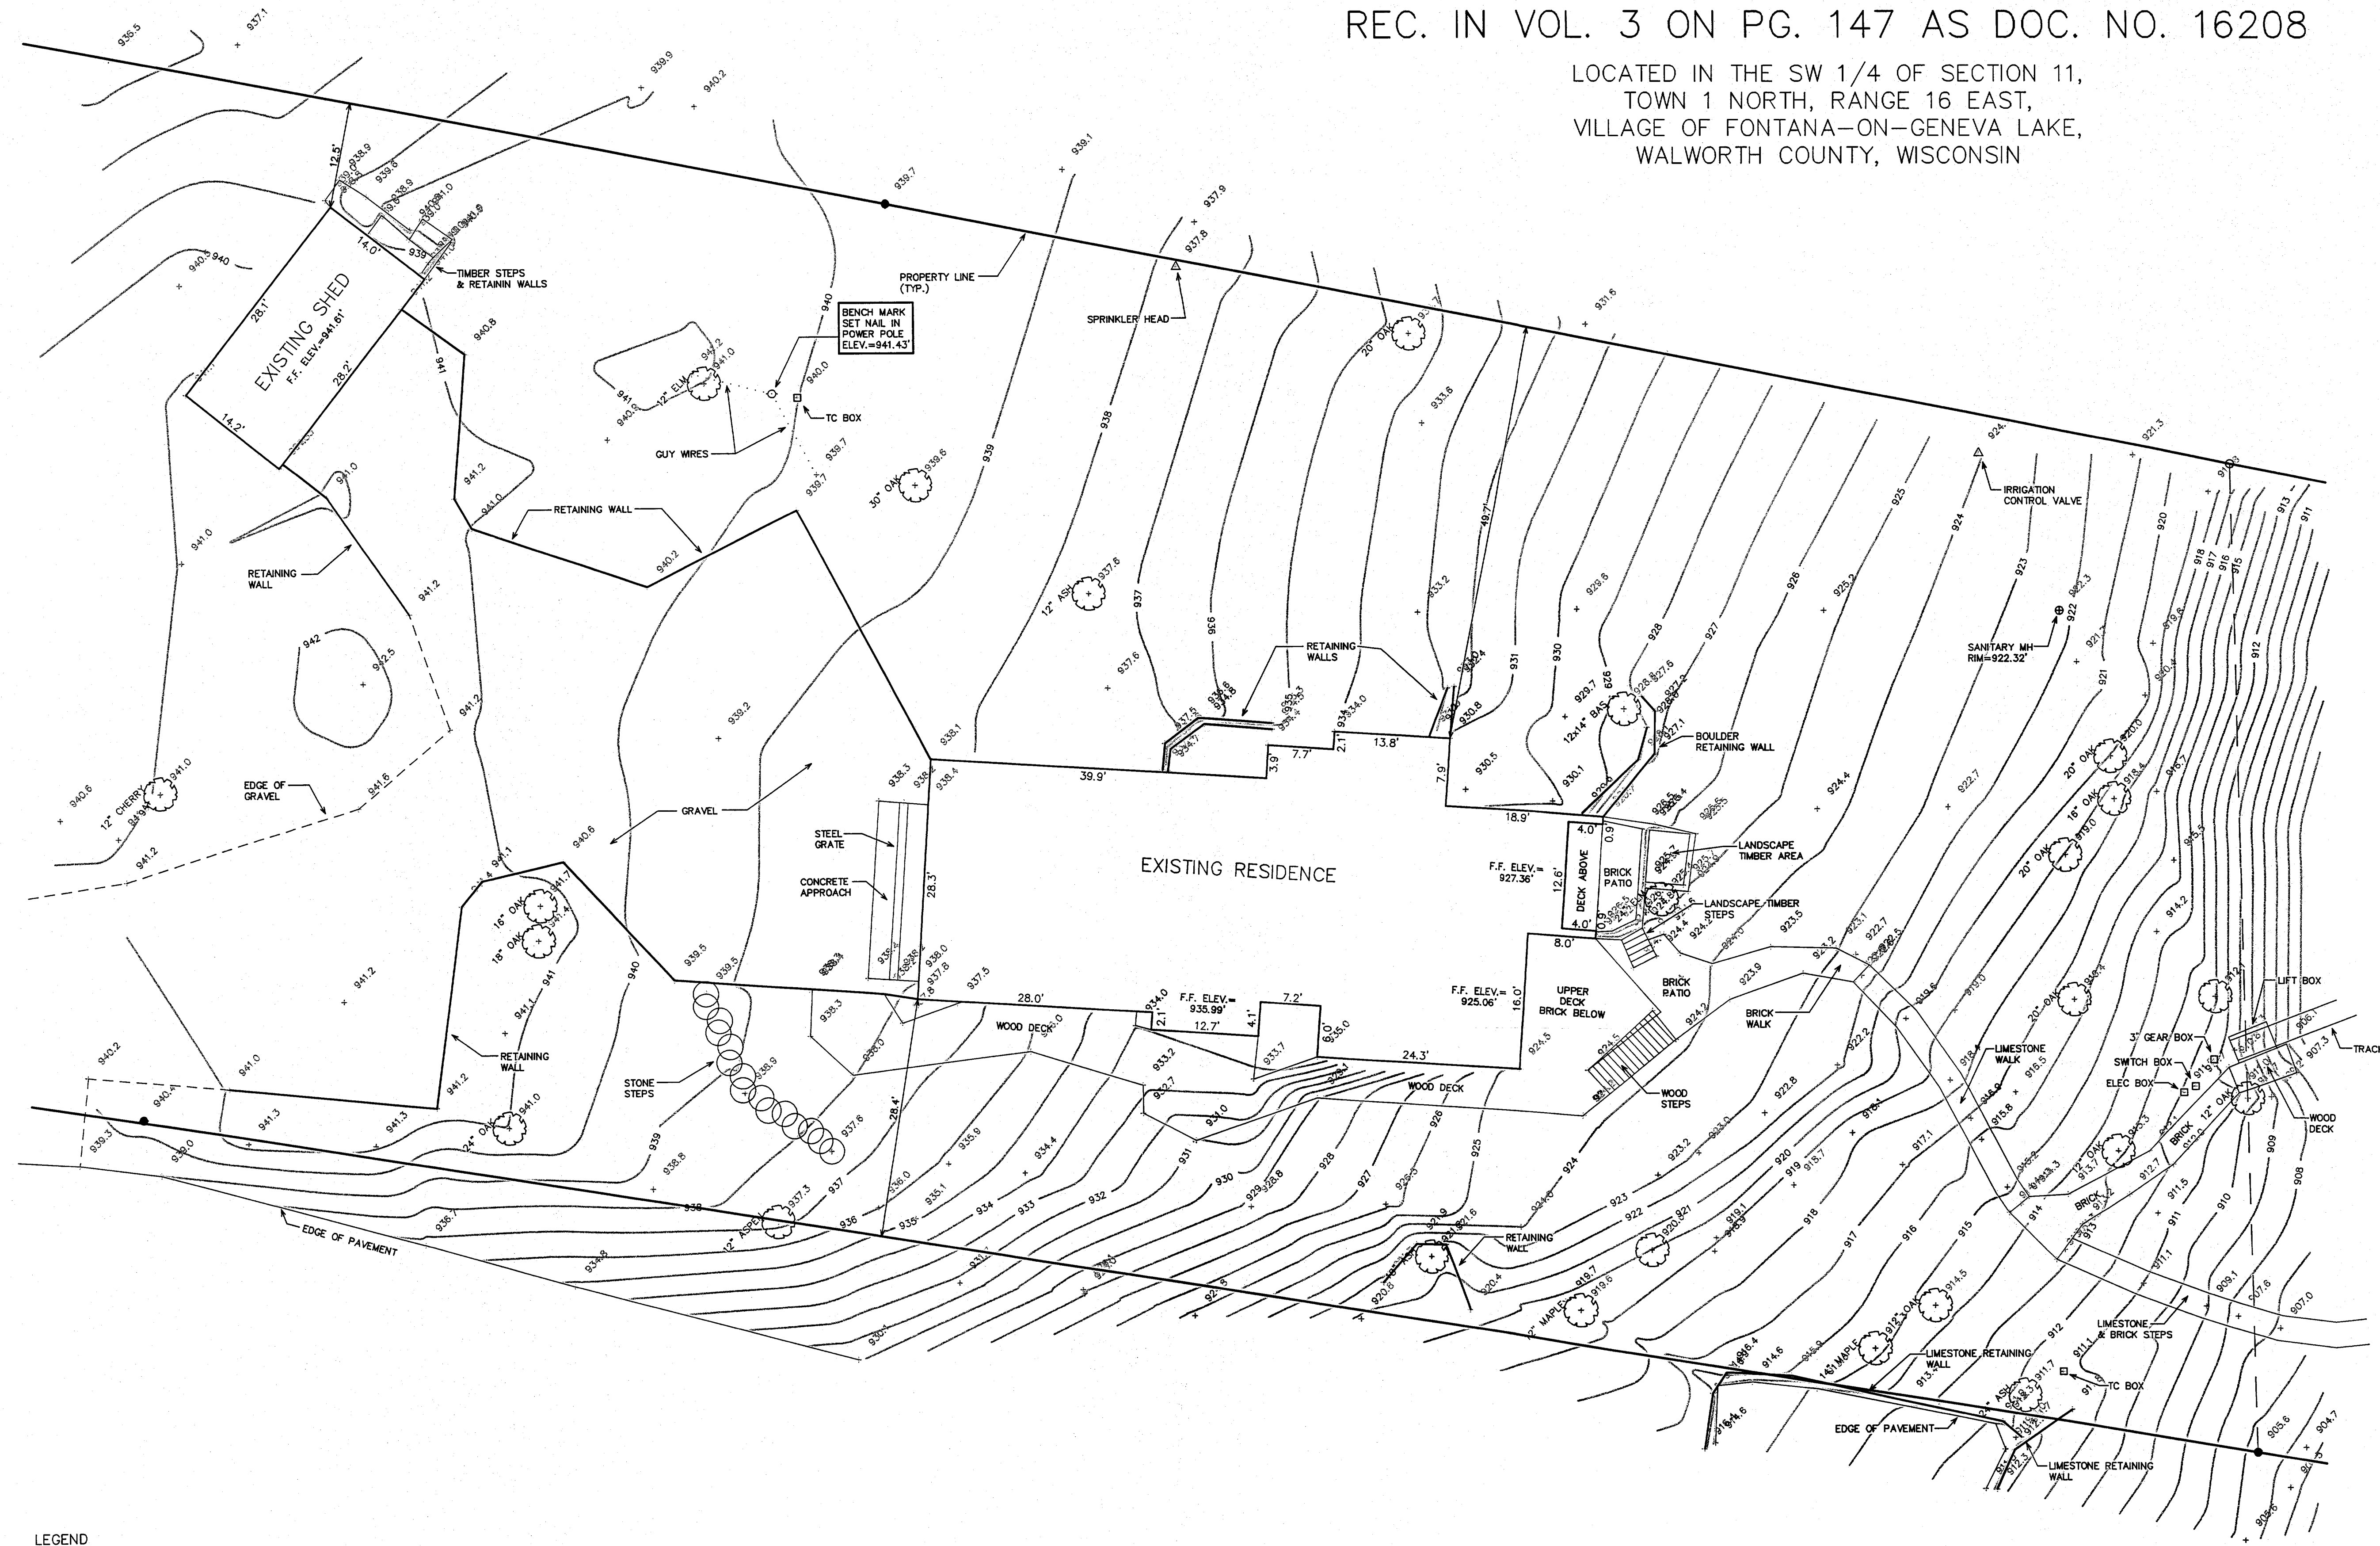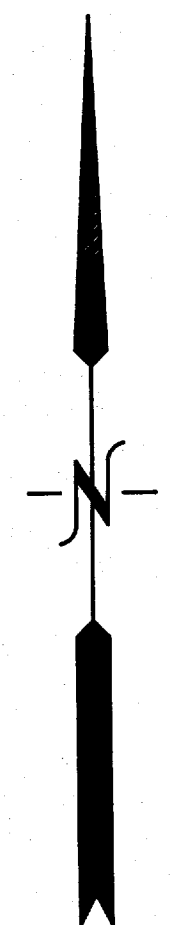

LEGEND

- = FOUND IRON PIPE STAKE
- = FOUND IRON REBAR STAKE

