

ABERNATHY and ASSOCIATES

Kenneth B. Abernathy Jr.

Wisconsin Registered Land Surveyor

S-1594

W4056 BRAY RD.


ELKHORN, WI. 53121

PHONE: (262) 723-4260 (OFFICE)
(262) 723-7209 (FAX)


Email: abernathy@elknet.net

PLAT OF SURVEY

LOT 11 AND THE NORTH 1/2 OF LOT 10,
BLOCK 3 OF INDIAN HILLS SUBDIVISION,
LOCATED IN SECTION 14, T 1 N, R 16 E,
VILLAGE OF FONTANA-ON GENEVA LAKE,
WALWORTH COUNTY, WISCONSIN.

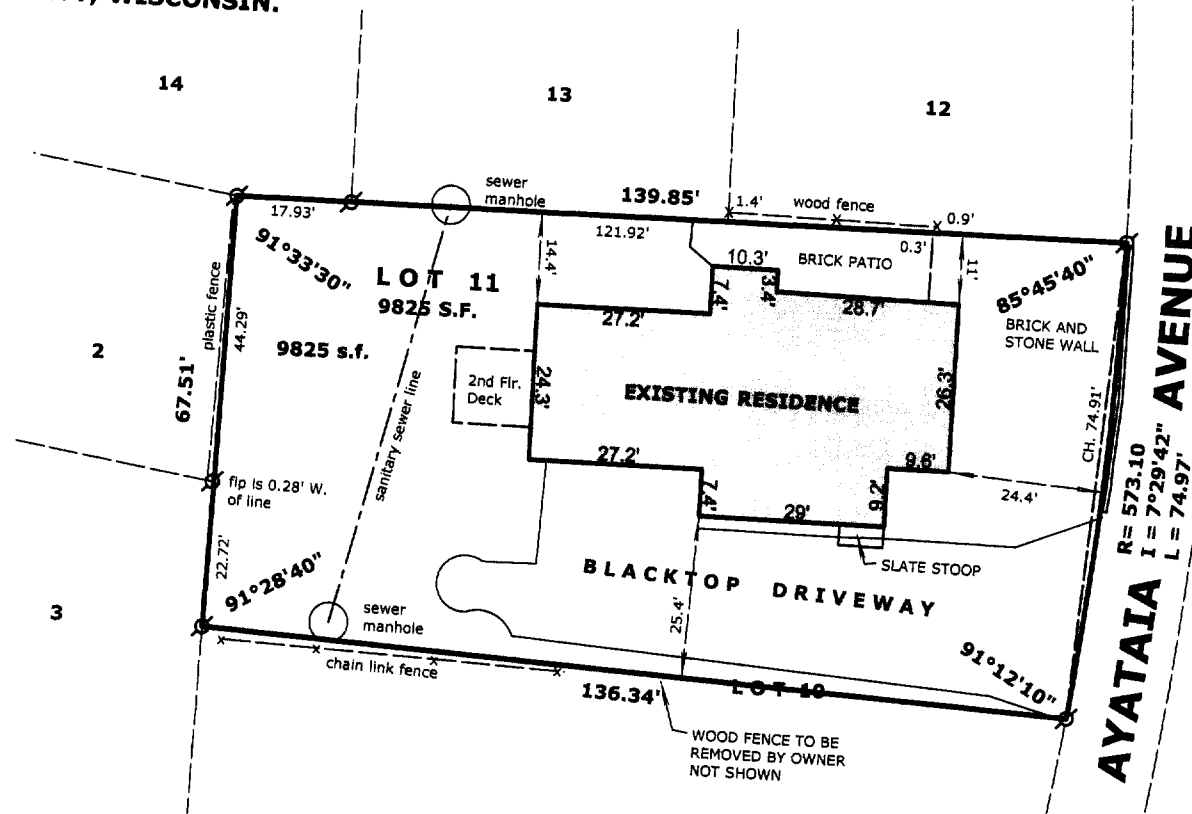


OWNERS: JOHN T. O'NEILL and MAUREEN T. O'NEILL
P.O. BOX 351
FONTANA, WI. 53125

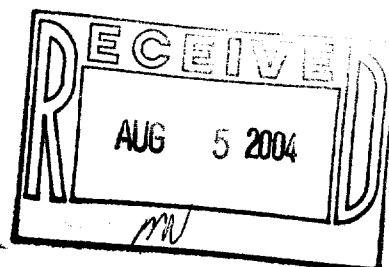


SIH 00056

Legend

- Ø FOUND IRON PIPE
- Ø FOUND IRON ROD
- ⊠ FOUND BRASS CAPPED MONUMENT
- FOUND CONCRETE MONUMENT
- + CHISEL CUT IN CONCRETE
- SET IRON ROD, 24" LONG, WEIGHING 1.5 LBS./LINEAL FT., 3/4" DIA.
- SET IRON ROD, 30" LONG, WEIGHING 4.5 LBS./LINEAL FT., 1-11/16" DIA.
- (x x) RECORDED AS DIMENSION
- x-x-x-x-x EXISTING FENCE

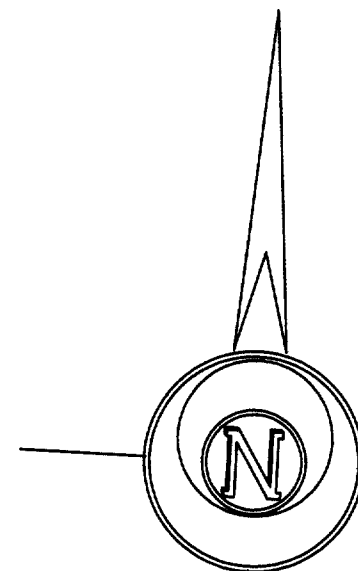

SCALE: 1" = 30 FEET

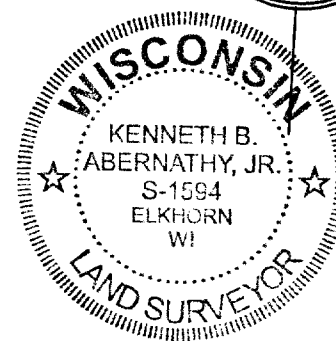

"I hereby certify that the above described property has been surveyed by me or under my direction and that the above map is a true representation thereof and shows the size and location of the property, its exterior boundaries, the location of all visible structures and dimensions of all principal buildings thereon, boundary fences, apparent easements, roadways and visible encroachments, if any."
"This survey is made for the use of the present owners of the property, and also those who purchase, mortgage, or guarantee the title thereto within one year from the date hereof."

Kenneth B. Abernathy, Jr.

KENNETH B. ABERNATHY, JR. S-1594
WISCONSIN REGISTERED LAND SURVEYOR,

Date: JULY 9, 2004

Job No. 04.701