


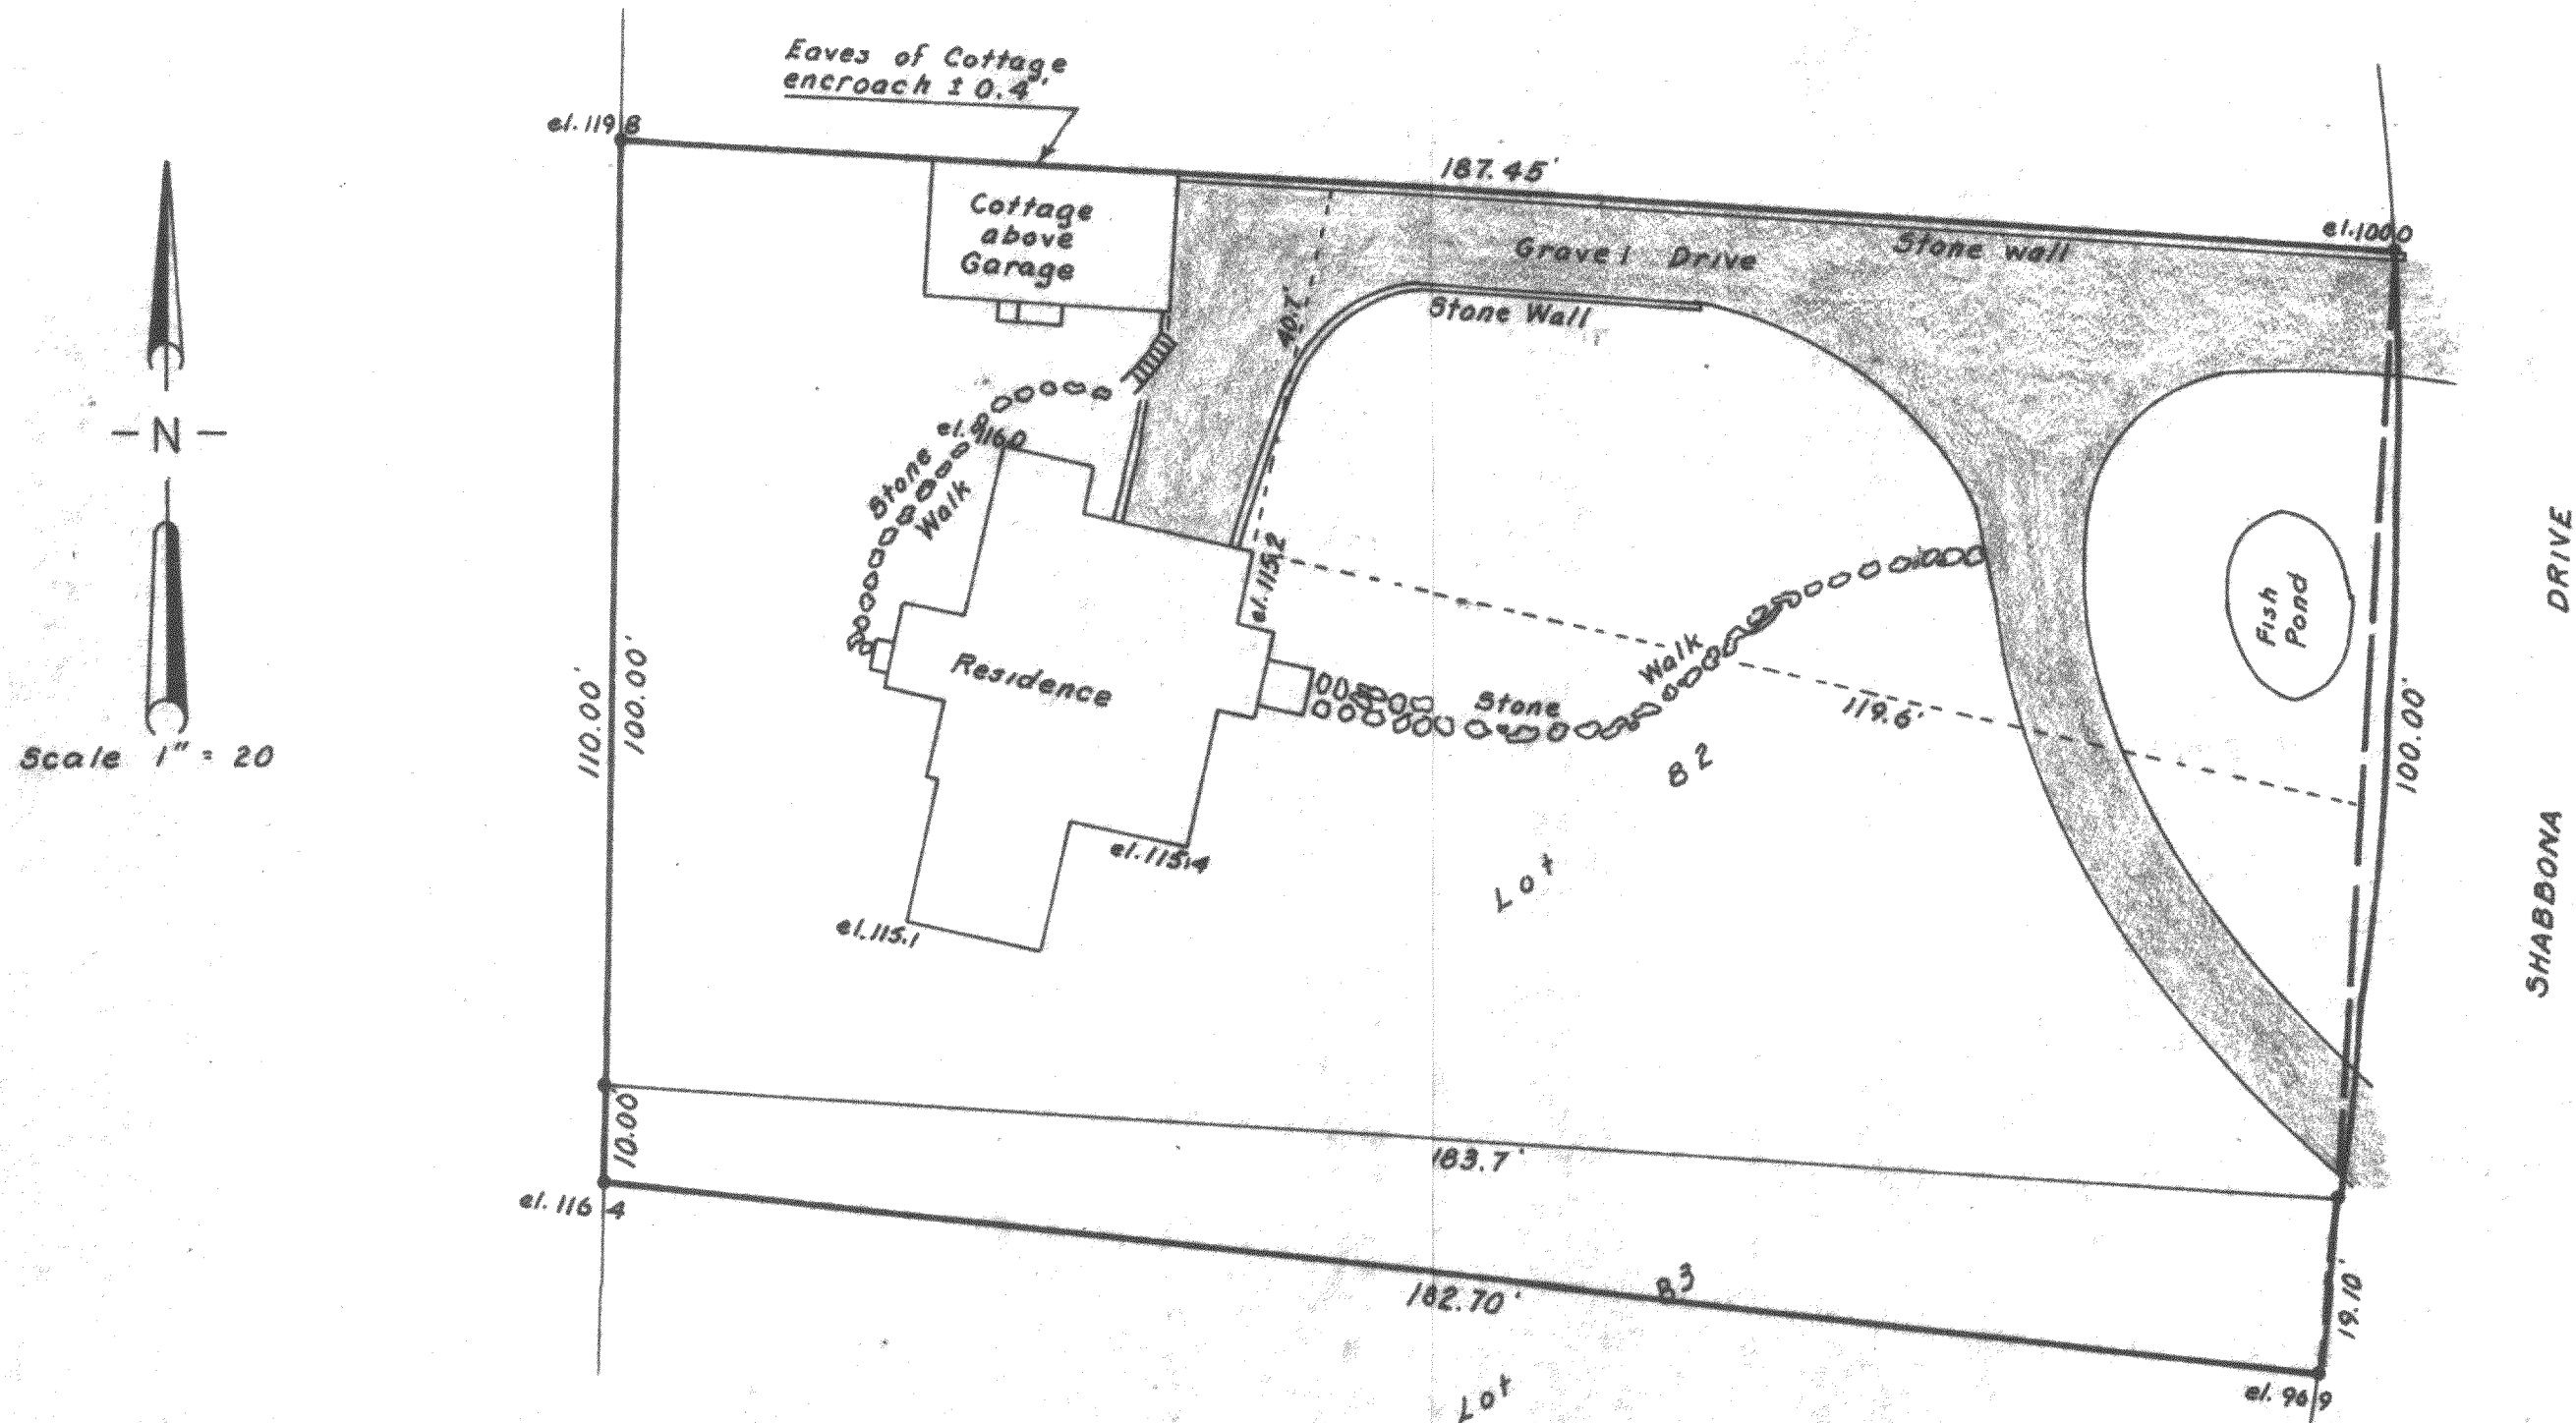

PLAT OF SURVEY OF
Lot 82 and part of Lot 83, Unit 2, Country Club Estates, Village of
Fontana-on-Geneva Lake, Walworth County, Wisconsin.

I certify that I have surveyed the above described property and
that the above plat is an accurate survey and true representation
thereof and correctly shows the exterior boundry lines and location
of buildings and other improvements on said property and the correct
measurments thereof.
Dated this 25th day of October, 1962.

Harold H. Kolb
Harold H. Kolb, Wisconsin Surveyor, S-187



5C0277

Concrete Monument Found

5-220