

Plat of Survey


of

Lot 1 of Certified Survey Map No. 3346,

recorded in Vol. 19 of Certified Survey Maps of Walworth County on Page 88 and located in Government Lot 1 in the fractional Northwest 1/4 of Section 14, Town 1 North, Range 16 East, Village of Fontana-on-Geneva Lake, Walworth County, Wisconsin.


Surveyed for: **Keefe Real Estate, Inc.**
751 Geneva Parkway
P.O. Box 460
Lake Geneva, Wisconsin. 53147

Survey Date: Sept. 21, 2004
Revisions:

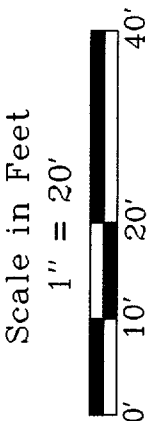

Douglas Street

Third Avenue

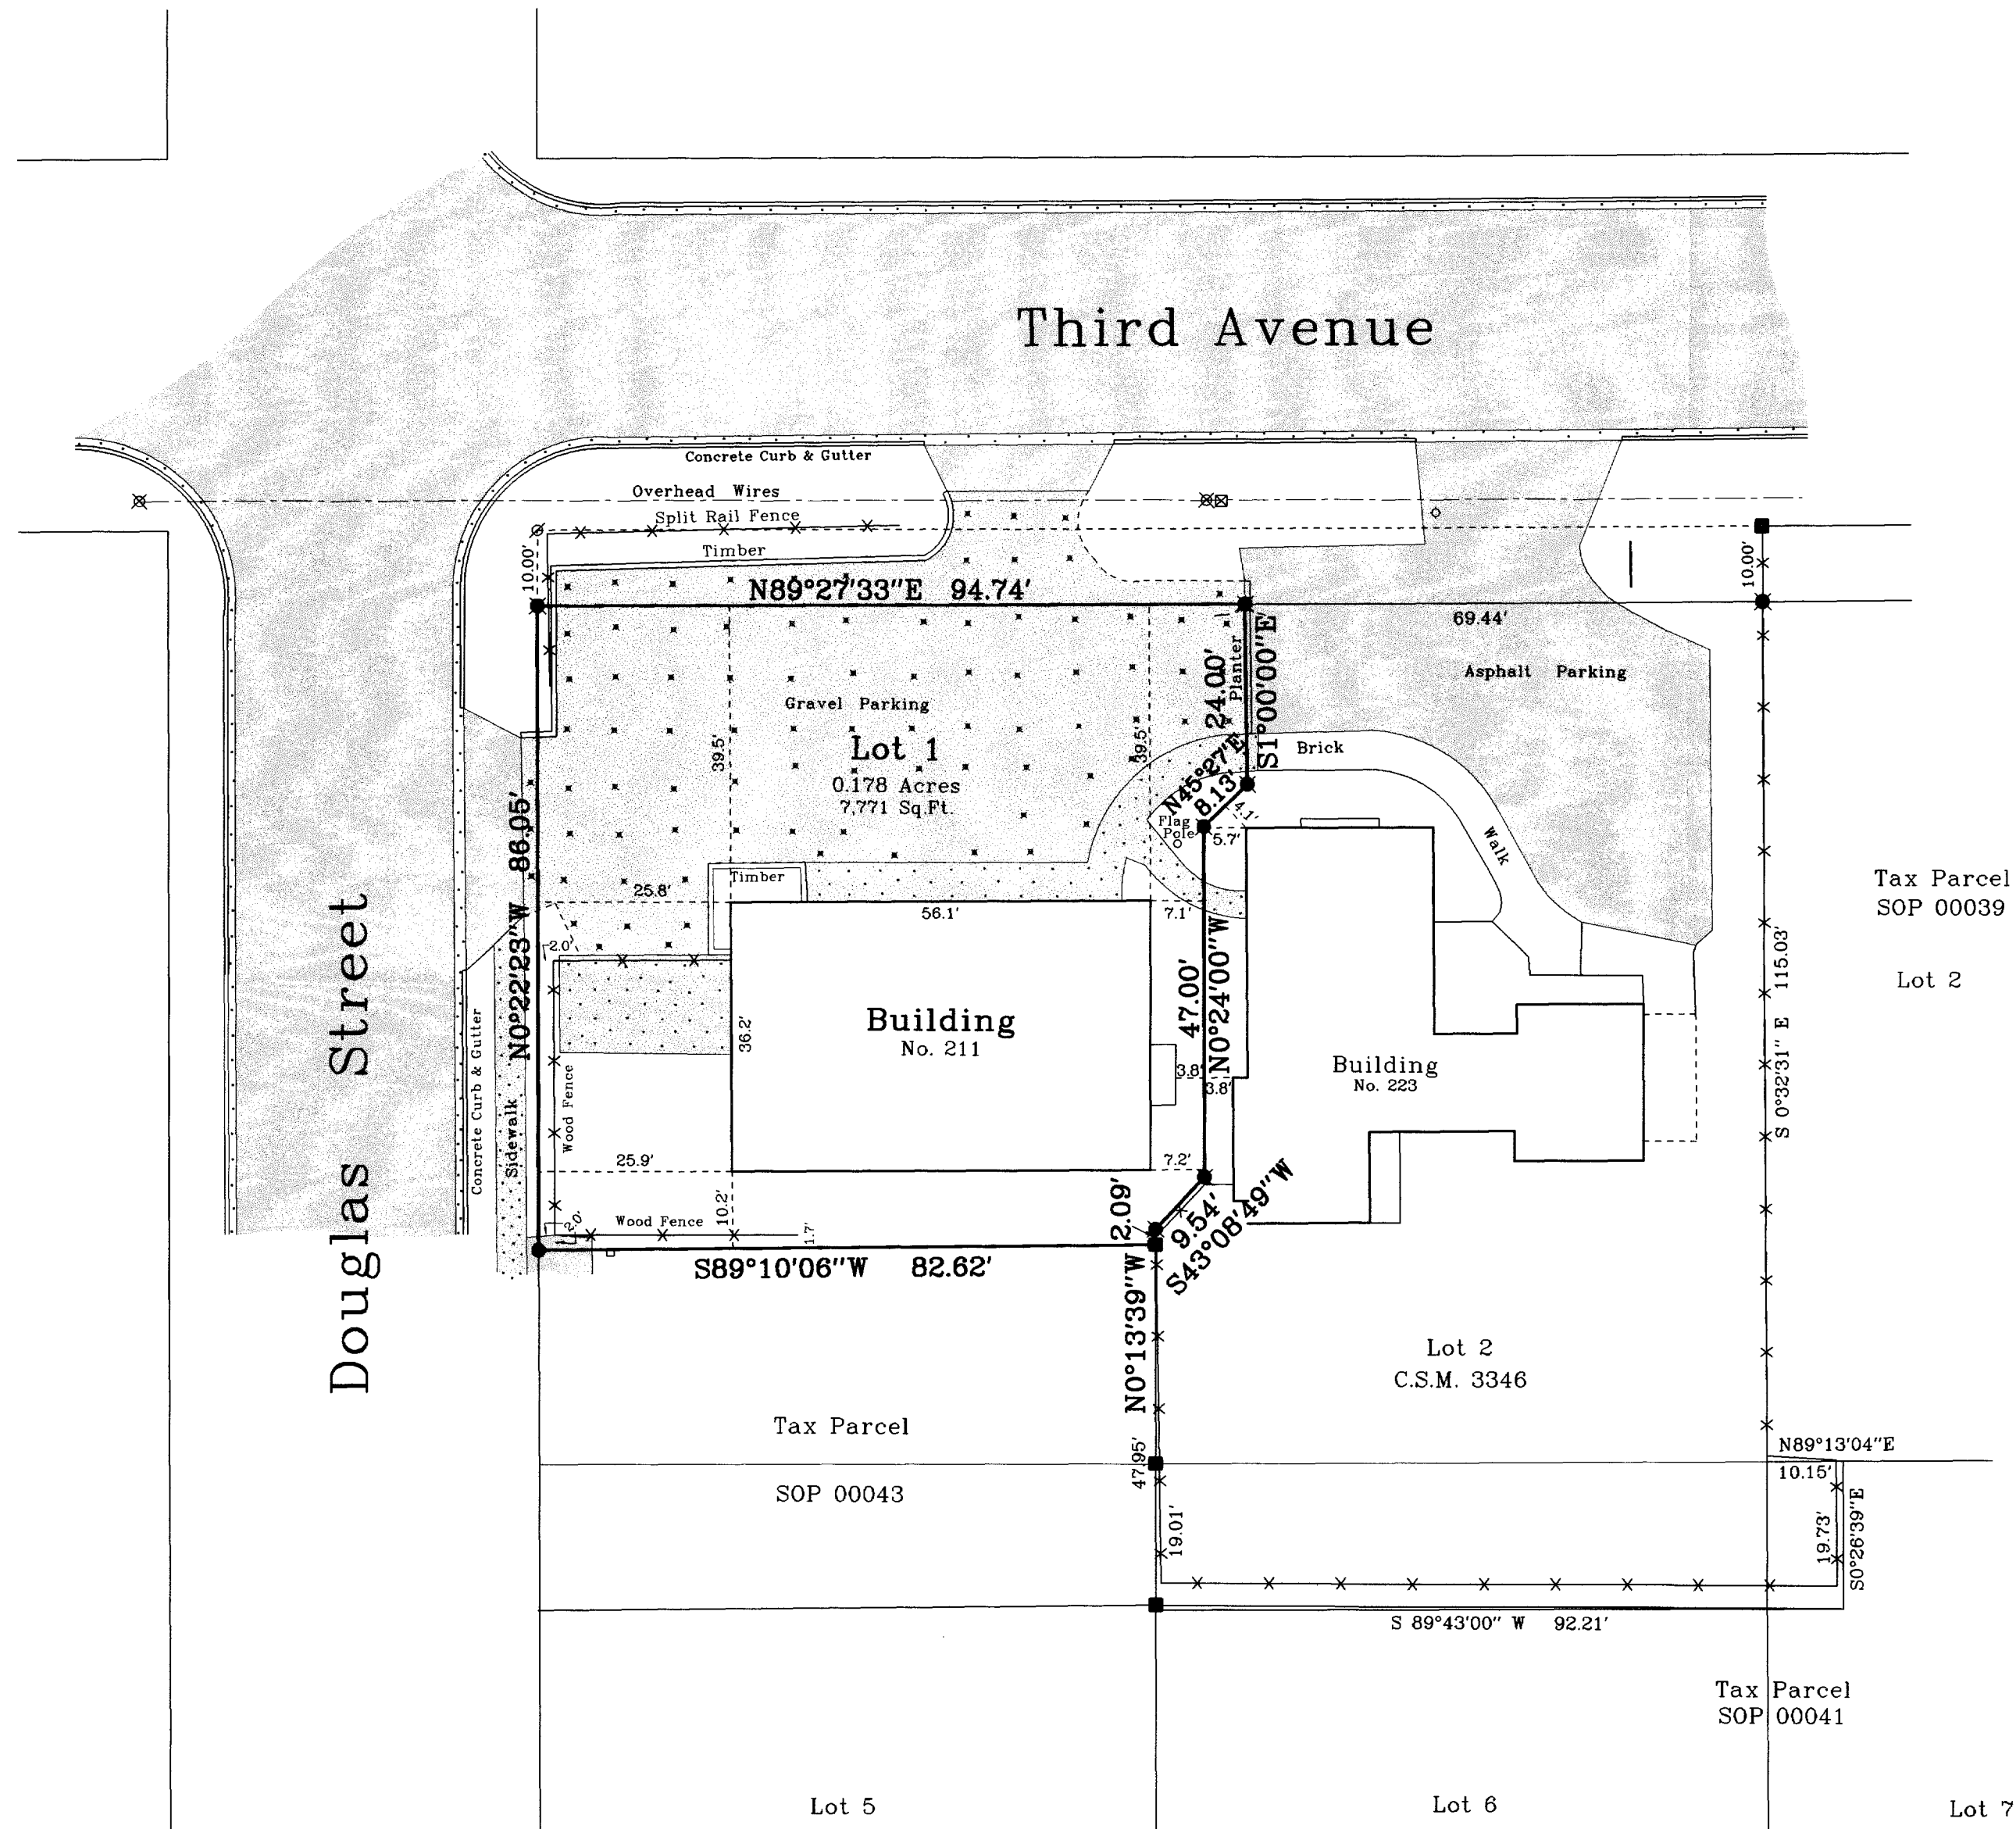

Tax Parcel
SOP 00039

Lot 2

Lot 2
C.S.M. 3346



Tax Parcel
SOP 00043

Lot 5

Lot 6

Lot 7

Tax Parcel
SOP 00041

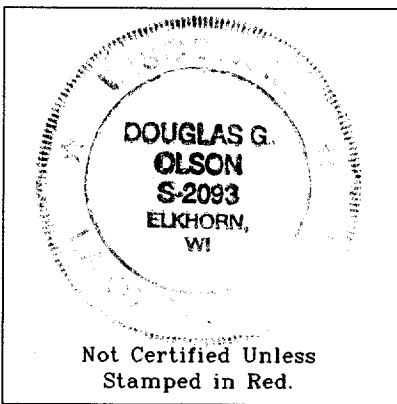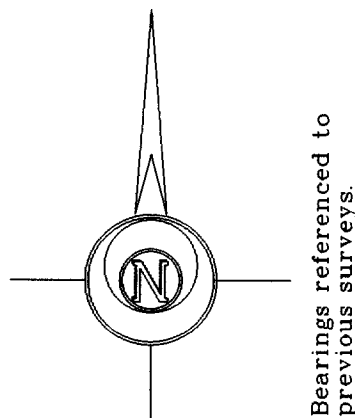

- Notes: 1) This survey plat is not certified unless signed and sealed in red ink.
2) This survey is subject to Wisconsin lien laws. This Plat of Survey is the notice of intent to file lien. Lien waiver required.

Copyright © 2004 by Jensen & Olson Land Surveying, LLC.

All rights reserved. No part of this survey plat may be reproduced or transmitted in any form by any means - graphic, electronic, or mechanical, including photocopying, tracing, or information storage and retrieval systems - without permission in writing from Douglas G. Olson, Jensen & Olson Land Surveying, LLC.

I hereby certify that I have surveyed the above described property and the map hereon is correct to the best of my professional knowledge and belief and shows the size and location of the property, its exterior boundaries, the location and dimensions of all visible structures thereon, boundary fences, apparent easements and roadways and visible encroachments, if any.
This survey is made for the exclusive use of the present owners of property, and also those who purchase, mortgage or guarantee title thereto, within one year from the date hereof.

Douglas G. Olson
Wisconsin Registered Land Surveyor - 2093

Jensen & Olson Land Surveying, LLC

45 South Wisconsin Street
P.O. Box 322
Elkhorn, Wisconsin 53121
Telephone (262) 723-3434
Facsimile (262) 723-8044

Legend
Found Concrete Monument
Found Iron Pipe
Found Iron Rod
Found Iron Rod 3/4" dia.
Recorded Information
Concrete Surface
Asphalt Surface
Fence
Gravel

Sheet 1 of 1 Sheets

Job Reference Number

2004.157

2004.157

SA334600001

005-2223