


PLAT OF SURVEY

OF

LOT 4 BLOCK 3 BROOKWOOD SUBDIVISION,
LOCATED IN SECTION 18, TIN RITE VILLAGE OF
FONTANA, WALWORTH COUNTY, WISCONSIN.

49.5' WIDE
PUBLIC ROAD

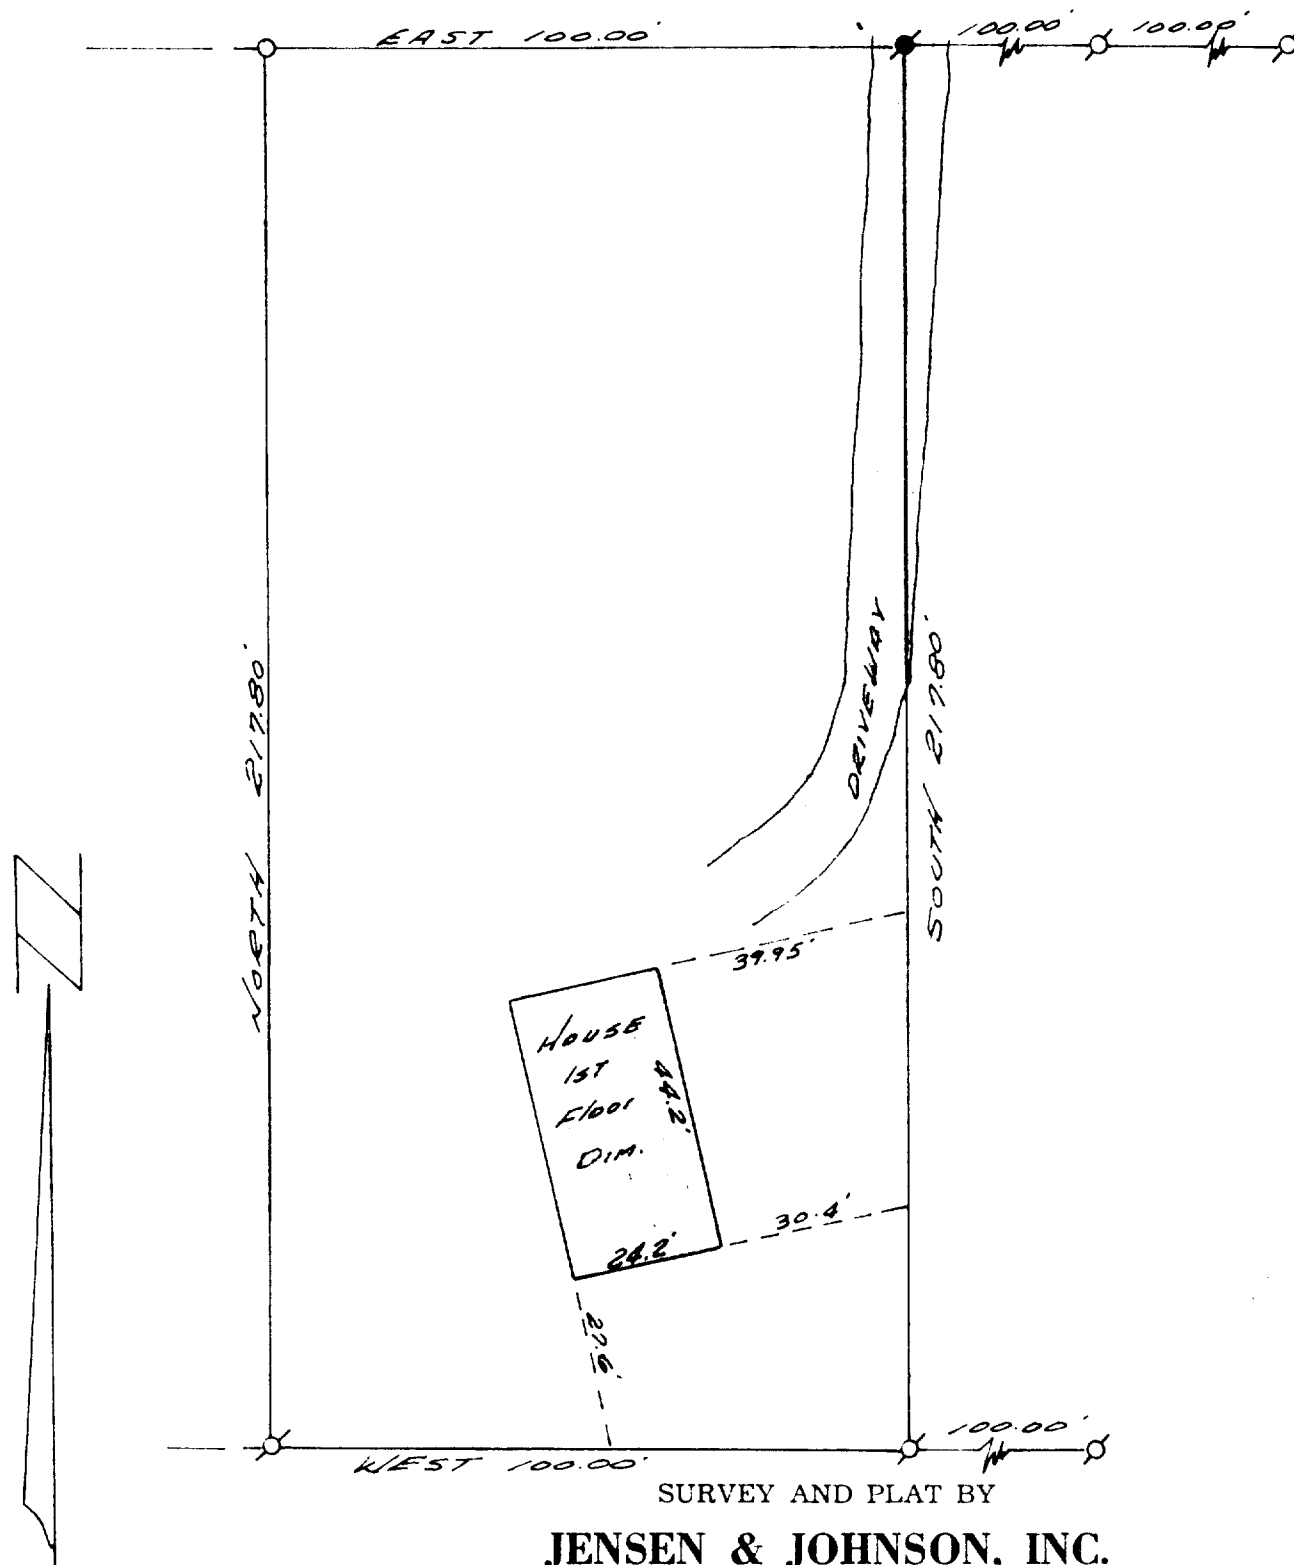

SURVEY AND PLAT BY

JENSEN & JOHNSON, INC.

CIVIL ENGINEERS AND SURVEYORS

Elkhorn, Wisconsin

LEGEND

- — Iron Pipe SET
- — Concrete Monument

Scale 1" = 30'

- — IRON PIPE FOUND
- — IRON ROD SET

WE CERTIFY: That we have surveyed the above described property and that the plat shown hereon is an accurate survey and a true representation thereof and correctly shows the exterior boundary lines and all divisions of said property, AND ALL BUILDINGS THEREON.

Date MAR. 17, 1971

Lloyd L. Jensen
LLOYD L. JENSEN,

Wisconsin Registered Land Surveyor, No. S-211

505-25