


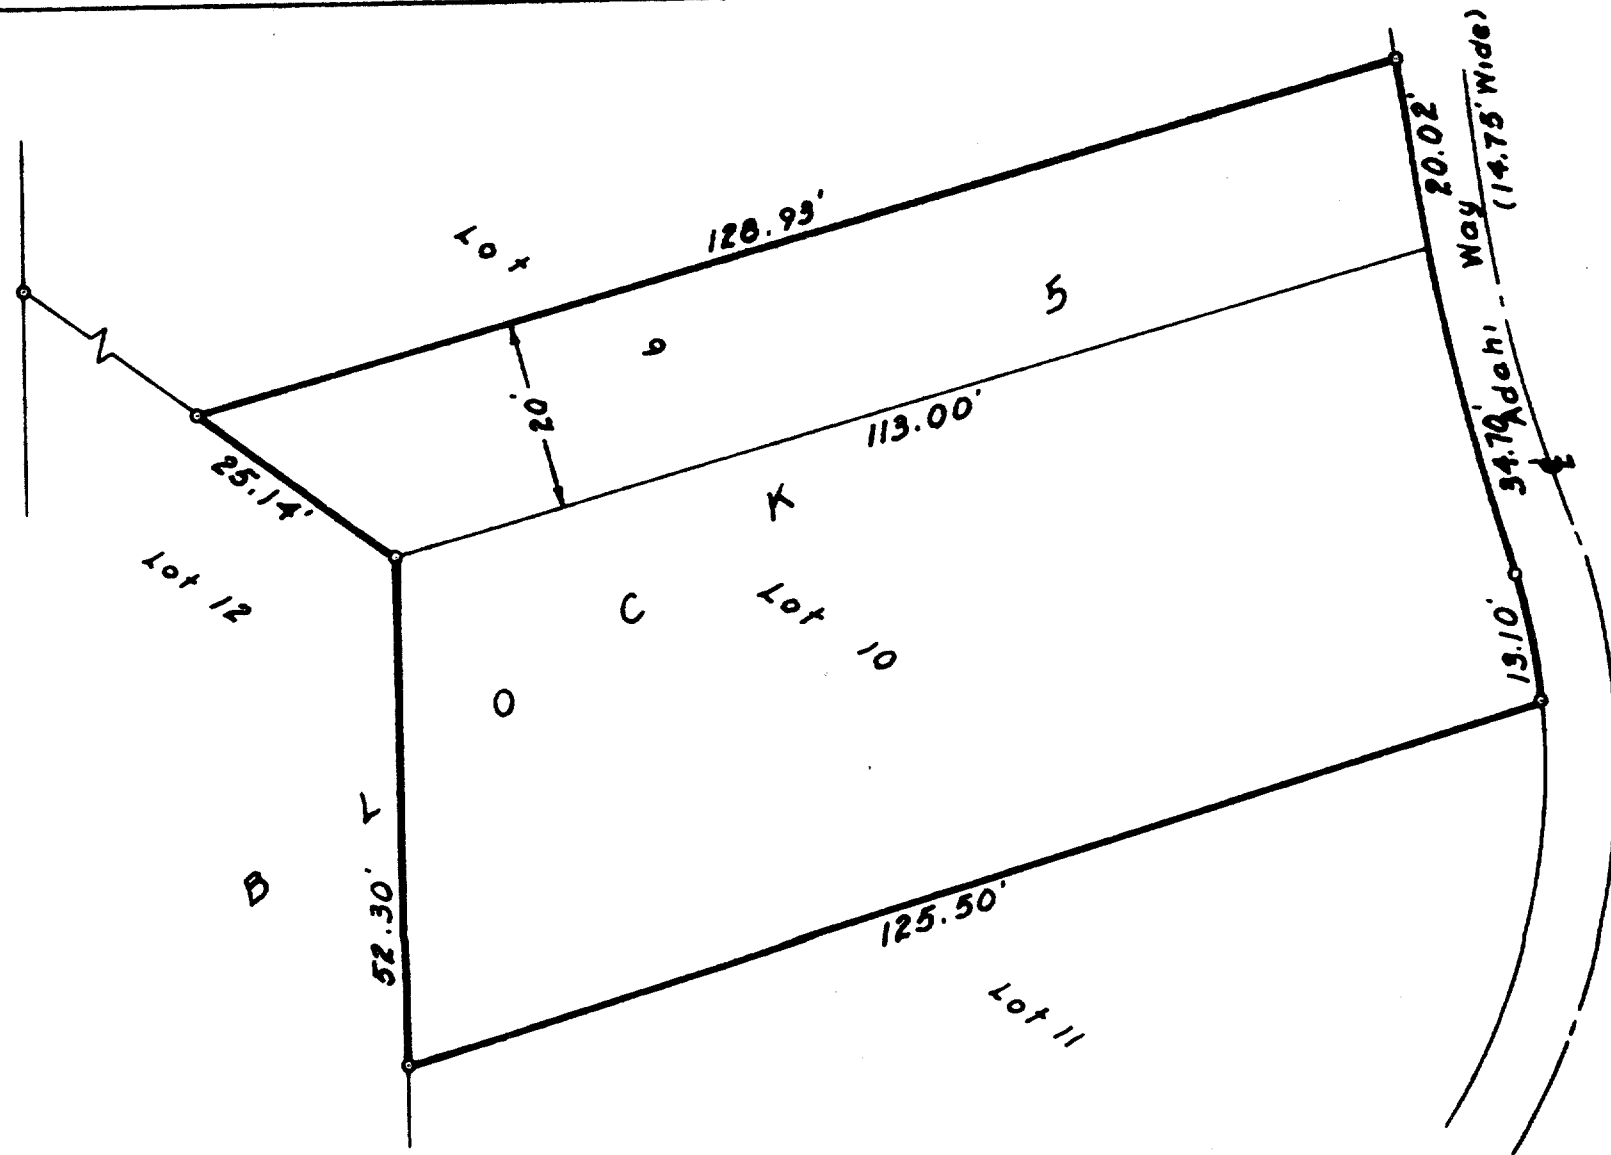

PLAT OF SURVEY OF

Lot 10 and the South 20' of Lot 9,
Block 5, Indian Hills, Village of Fontana-
on- Geneva Lake, Walworth County, Wisconsin.

Harold H. Kolb

Harold H Kolb

Wis. Registered Surveyor S-167

o - Iron Pipe

5-9-62

5-224

SBS-72