

ROBERS & FISCHER, INC.
CONSULTING ENGINEERS & LAND SURVEYORS


PHONE (414) 763-2652

116 E. CHESTNUT ST.

BURLINGTON, WIS. 53105

PLAT OF SURVEY & HOUSE LOCATION

Lot 12, Block 3, Indian Hills Subdivision, Village of Fontana,
 Walworth County, Wisconsin

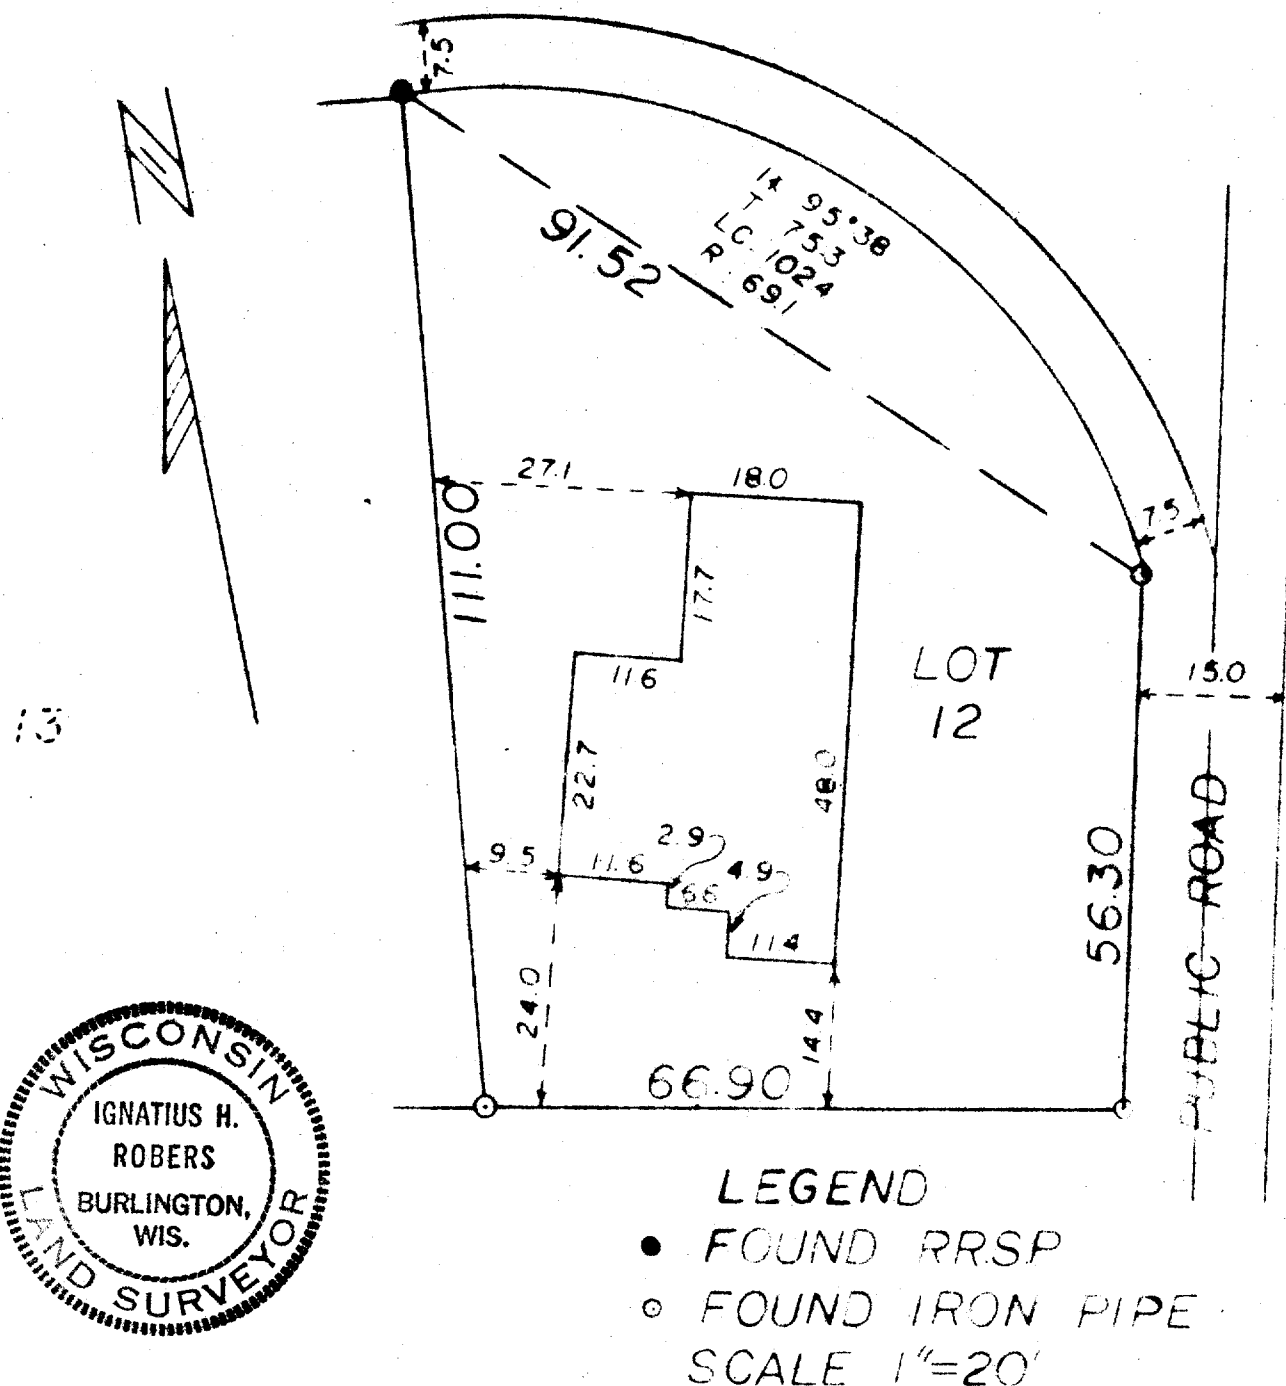

I HEREBY CERTIFY THAT WE HAVE SURVEYED THE LANDS DESCRIBED
 ABOVE ACCORDING TO OFFICIAL RECORDS AND THAT THE PLAT
 DRAWN HEREON IS A CORRECT REPRESENTATION OF SAID SURVEY.

Ignatius H. Rober
 WIS. LAND SURVEYOR

DATE 9-29-71

JOB NO.

5-2276
 1-18
 7-1-34