
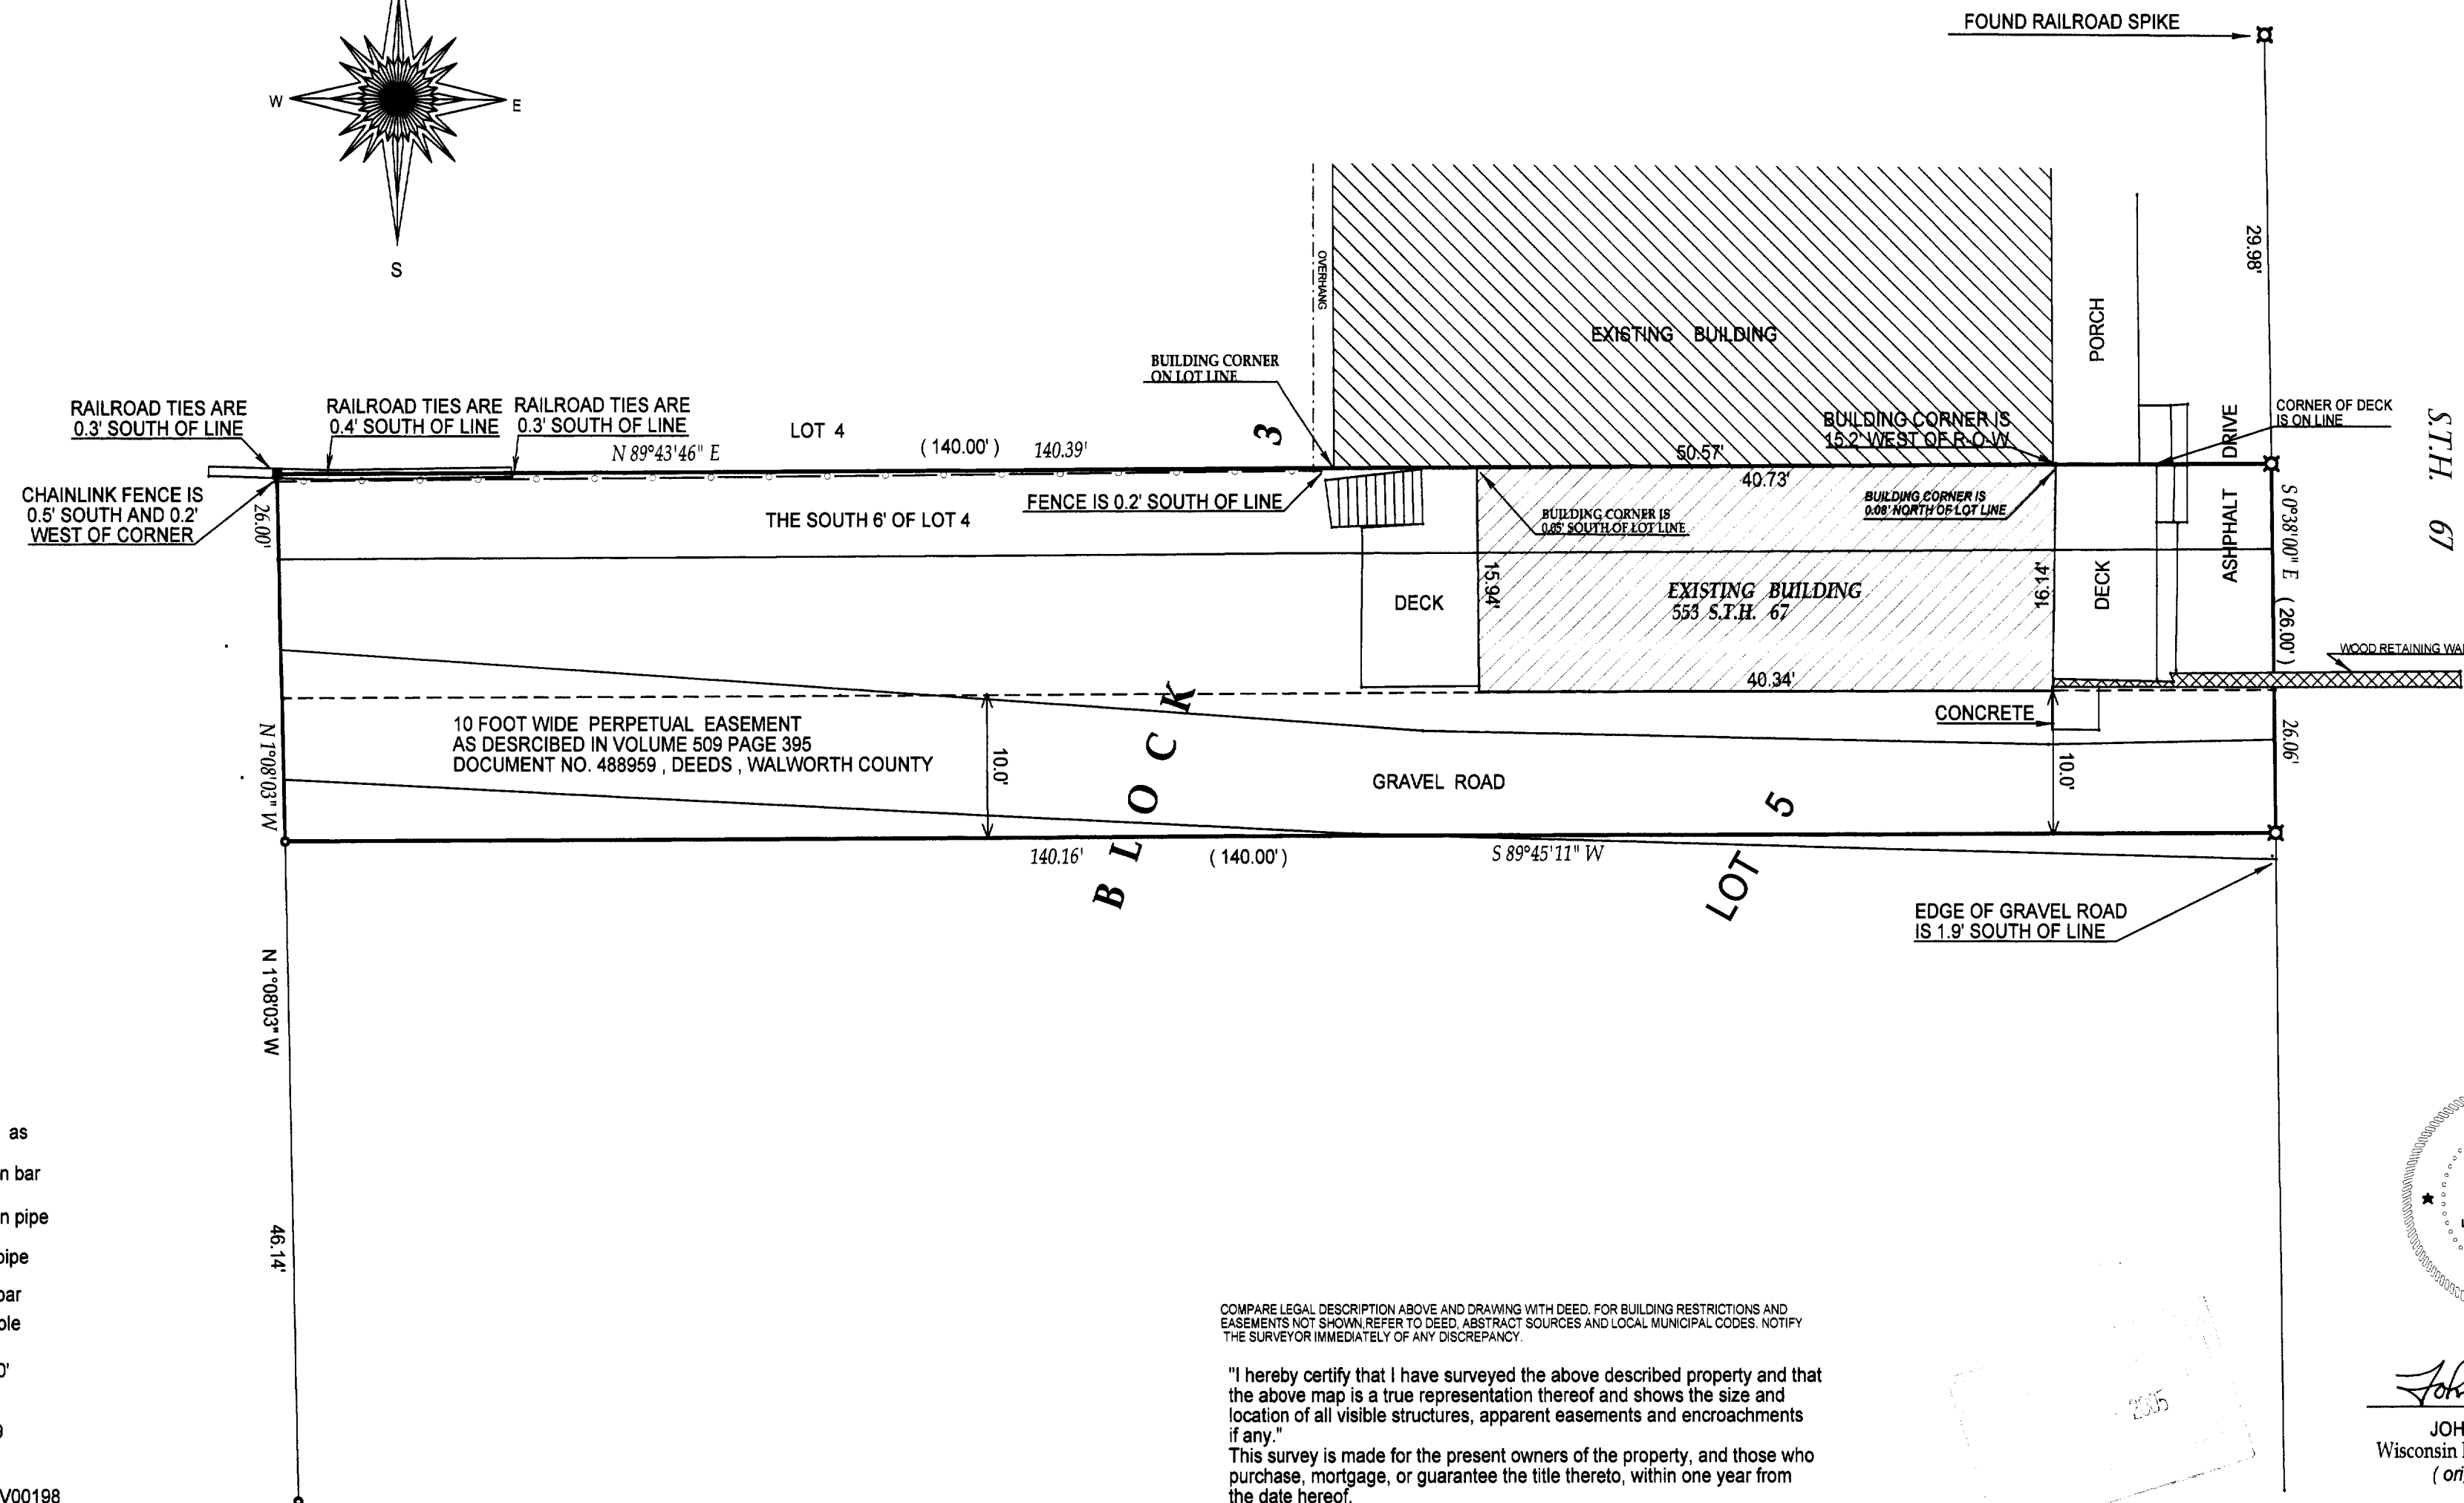


MIKE SCHMIDT
TITAN REAL ESTATE, INC.
531 VALLEY VIEW DR.
FONTANA, WI 53125

- OF -

THE SOUTH SIX (6) FEET OF LOT FOUR (4) BLOCK THREE (3), AND THE NORTH TWENTY (20) FEET OF LOT FIVE (5), BLOCK THREE (3), ALL IN THE ASSESSOR'S PLAT NUMBER ONE (1), C. L. DOUGLASS ADDITION TO THE VILLAGE OF FONTANA, WALWORTH COUNTY, WISCONSIN.

PATHFINDER SURVEYING, INC.
N3705 WILLOWBEND LANE
LAKE GENEVA, WI, 53147
262-248-3697

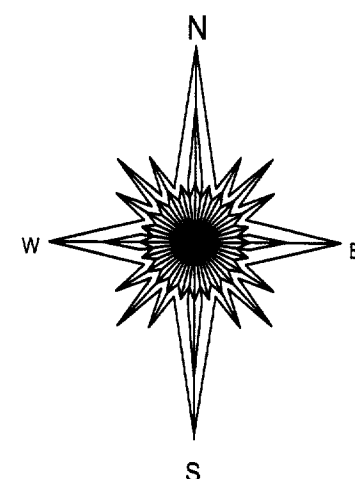


COMPARE LEGAL DESCRIPTION ABOVE AND DRAWING WITH DEED. FOR BUILDING RESTRICTIONS AND EASEMENTS NOT SHOWN, REFER TO DEED, ABSTRACT SOURCES AND LOCAL MUNICIPAL CODES. NOTIFY THE SURVEYOR IMMEDIATELY OF ANY DISCREPANCY.

"I hereby certify that I have surveyed the above described property and that the above map is a true representation thereof and shows the size and location of all visible structures, apparent easements and encroachments if any."

This survey is made for the present owners of the property, and those who purchase, mortgage, or guarantee the title thereto, within one year from the date hereof.

DATED THIS 7th, DAY OF JULY, 2005

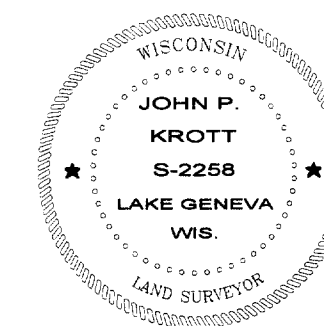


JOHN KROTT S - 2258
Wisconsin Registered Land Surveyor
(original if signed in red)

300-2306