



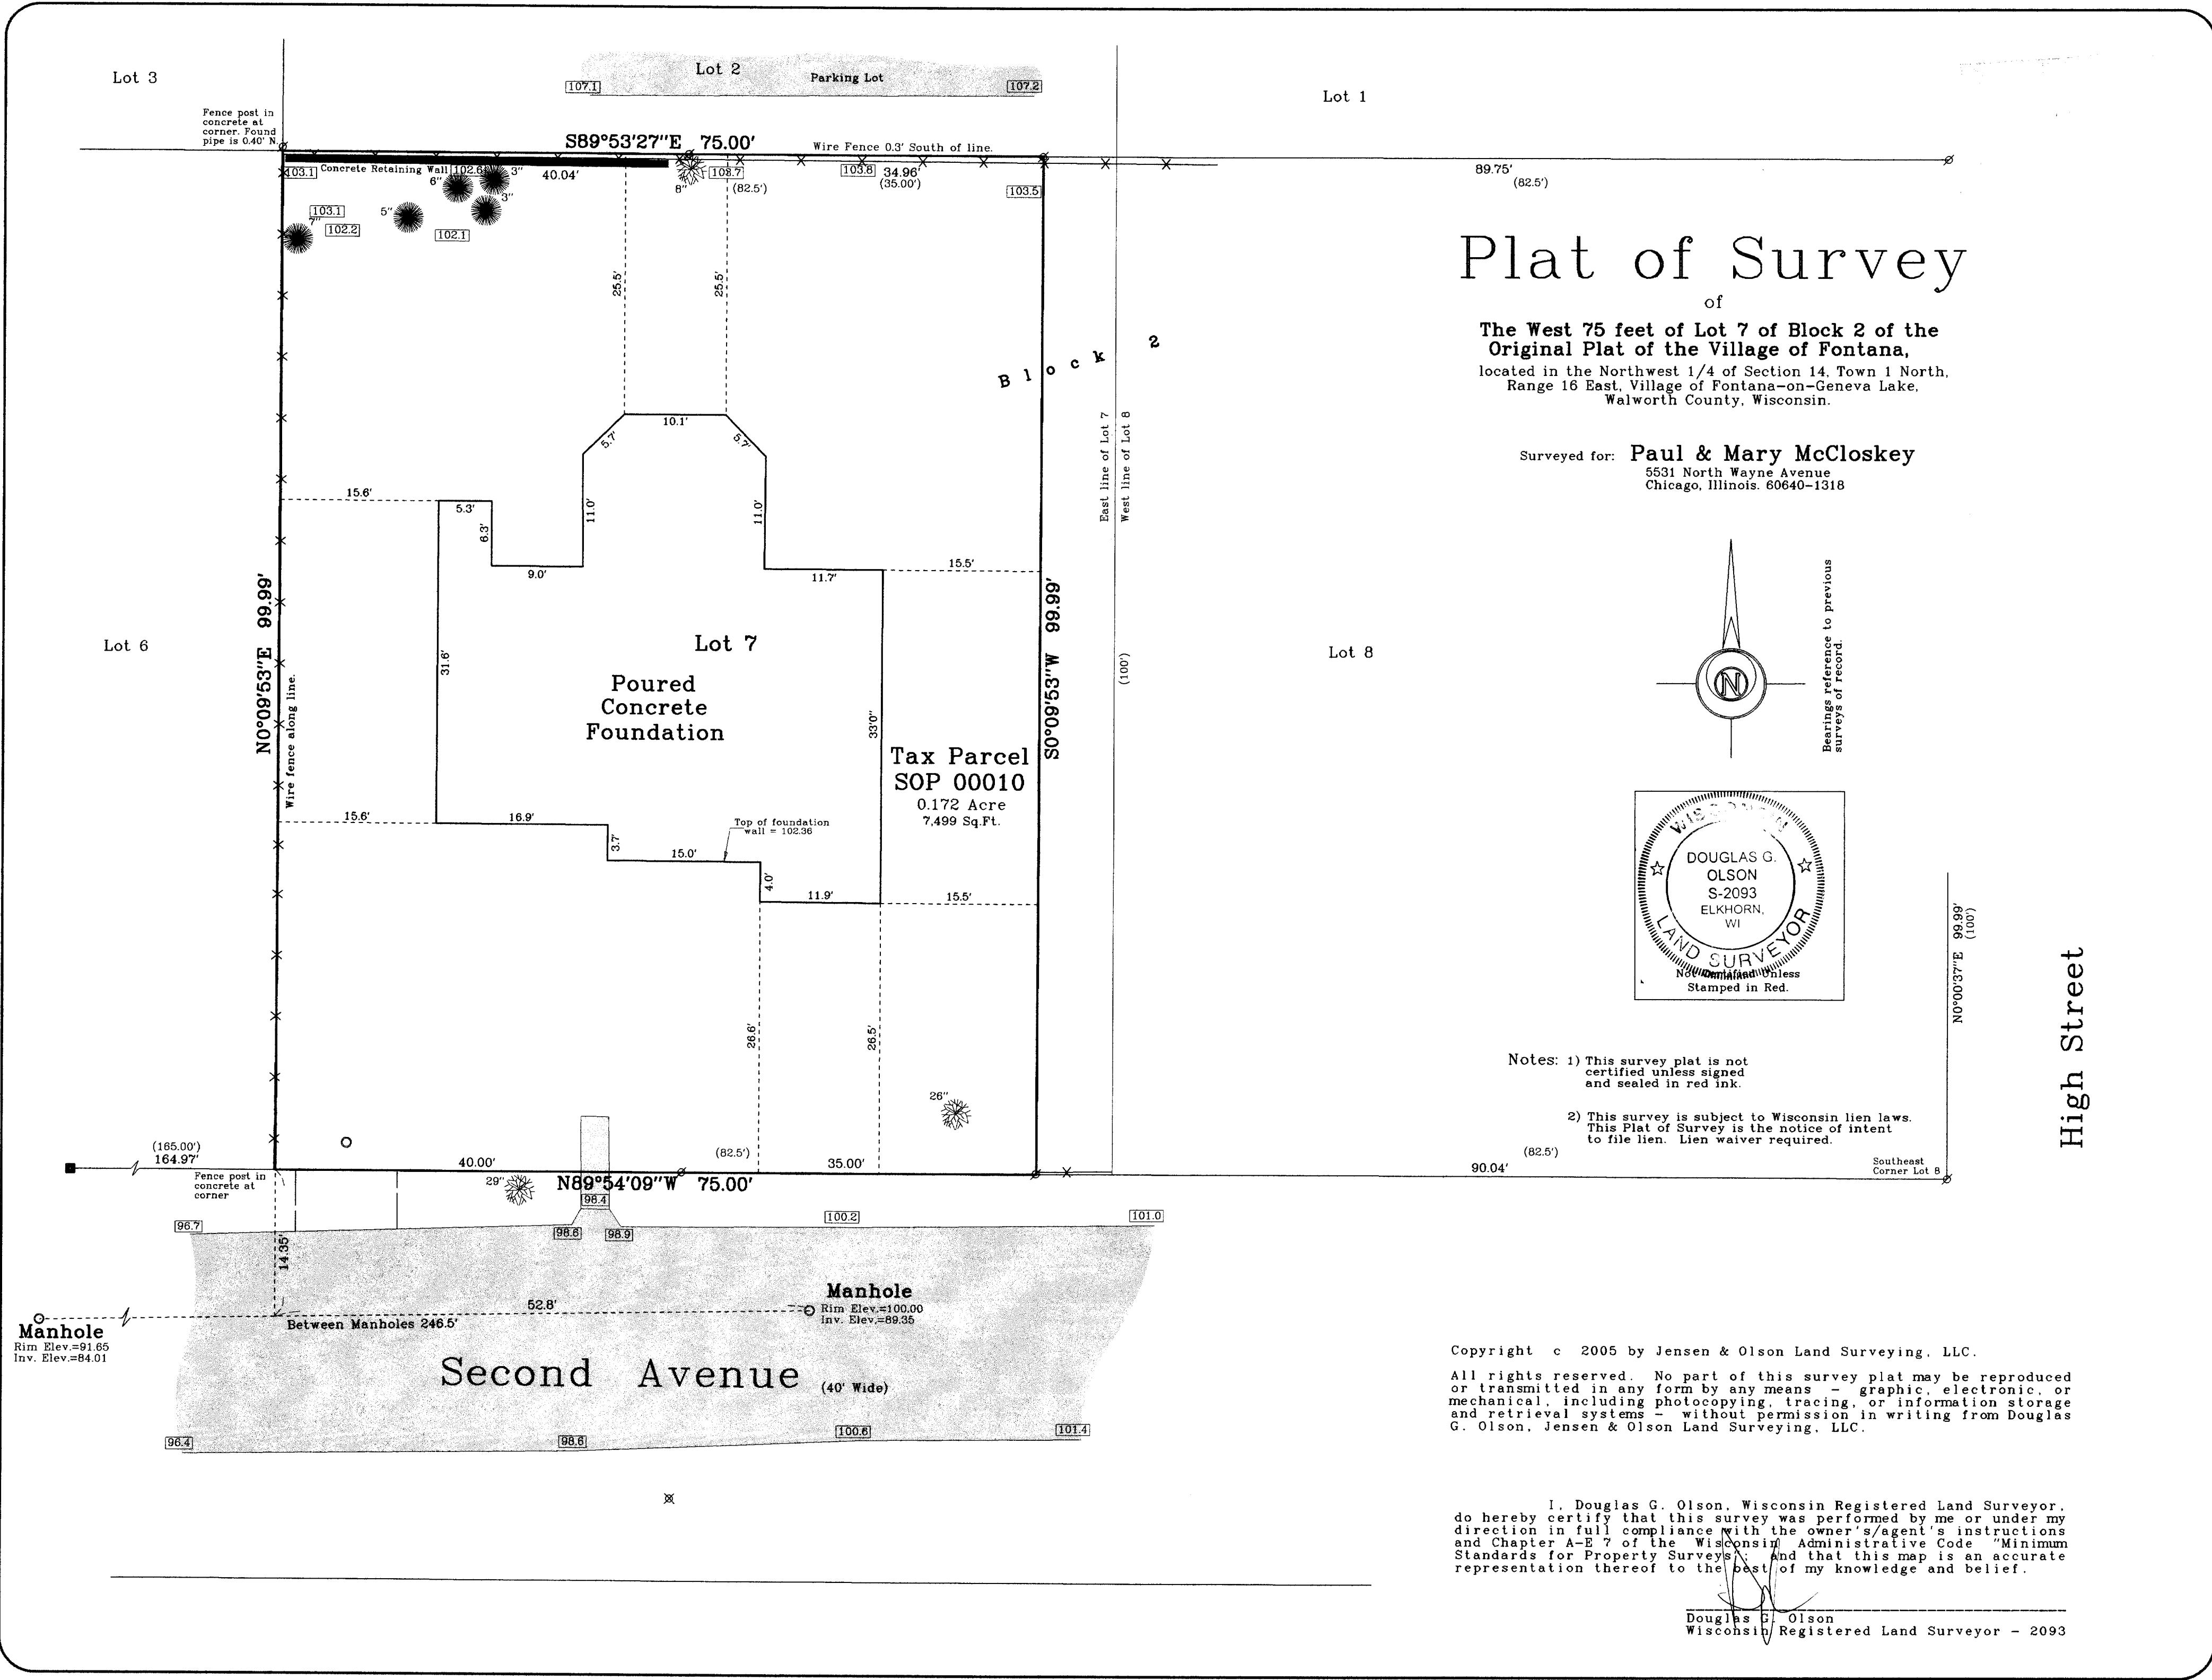

Survey Date: April 28, 2006.
Revisions: No. 1 - House Staking
No. 2 - Foundation

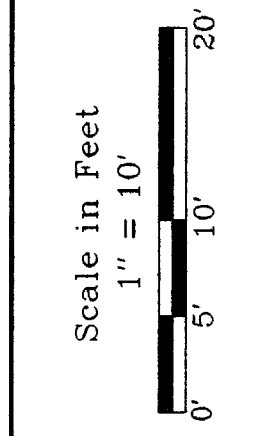

Jensen & Olson Land Surveying, LLC
45 South Wisconsin Street
P.O. Box 322
Elkhorn, Wisconsin 53121
Telephone (262) 723-3434
Facsimile (262) 723-8044

Legend
Found Concrete Monument
Found Iron Pipe
Recorded Information
Deciduous Tree
Manhole or Metal Cover
Asphalt Surface
Concrete Surface
Stone Patio

Sheet 1 of 1 Sheets
Job Reference Number
2005.036
2005.036

005-2320

SOP 00010